
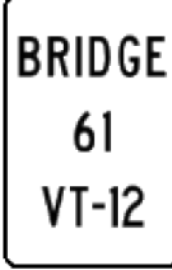





DIRECTION	MILEPOINT	LOCATION CODE (SHEET 3)	SIGN CODE	WIDTH (IN)	HEIGHT (IN)	SHEETING REMARKS	SIGN LEGEND	NEW SIGNS		EXISTING SIGNS				EXIST POST		NUMBER OF NEW POSTS	SQUARE STEEL (IN)			TUBULAR STEEL Ø (IN)				SIGN FRAME REQUIRED	REMARKS	SIGN DETAIL LOCATION								
								"A"	"B"	RETAIN	SALVAGE FROM	SALVAGE TO	REMOVE	RETAIN	REMOVE		1.75	2.00	2.50	FOUNDATION	3.00	3.50	4.00			5.00	SHSM	PROJECT SHEET #	STANDARD SHEET #					
																	(LB / FT)				(LB / FT)													
NB NORTHFIELD VT 12							FY-FLUORESCENT YELLOW FYG-FLUORESCENT YELLOW GREEN																"SHSM"-STANDARD HIGHWAY SIGNS AND MARKINGS BOOK											
		A	M2-1	21	15		 (CONT.)	2.19							4'	10'-2"								JCT, GREEN ON WHITE			E-136B							
		A	VM1-5	24	24			4.00																VT ROUTE 12A			E-136B							
NB	3.044	A	VR-038	24	18		STATE HIGHWAY ENDS			1																								
		A	R2-1	30	36		SPEED LIMIT 30			1																								
		A		24	30		NOTICE WINTER PARKING BAN NO PARKING ON ANY STREET NOV 15 TO APR 15 12:00 A.M.-6:00 A.M.			1																NOTE: PROJECT SUSPENDS HERE AT SOUTHERN CLASS 1 TH LIMIT IN NORTHFIELD								
NB	4.846	A	VR-039	24	18		STATE HIGHWAY BEGINS			1																NOTE: PROJECT RESUMES HERE AT NORTHERN CLASS 1 TH LIMIT IN NORTHFIELD								
		A	R2-1	24	30		SPEED LIMIT 35			1																								
NB	5.035	A	VD-701	6	8							1																						
		A	VD-701	6	10			0.42							4'	4'-10"																		
NB	5.093	A	VR-921R	30	30							1																						
		A	VR-921R	30	30			6.25							4'	9'-4"																		
NB	5.109	A	R3-7R	30	30							1																						
		A	R3-7R	30	30			6.25							4'	9'-8"																		
NB	5.129	D	R1-1	30	30			6.25							4'	9'-4"										INSTALL ON STOP SIGN SIDE OF INTERSECTION AT PLAZA DR								
SIGN SUMMARY SHEET							SHEET TOTALS										5	63'-4"	0	0.0	0.0	0.0	0.0	0.0	PROJECT NAME: RANDOLPH-BERLIN									
							25.36	0.00	5	0	0	3	0	0	5	70.0	0	0.0	0.0	0.0	0.0	0.0	PROJECT NUMBER: STPG SIGN(52)											
VERMONT AGENCY OF TRANSPORTATION							SF	SF	EA	EA	EA	EA	EA	EA	EA	EA	EA	EA	EA	EA	EA	EA	EA	EA	EA	EA	EA	FILE NAME: z13c626tsnorthfield NB	PLOT DATE: 5/12/2015					
							TOWN DIRECTIONAL TOTALS										439.4	0.0	27	0	0	95	0	0	79	1160.0	0	0.0	0.0	0.0	0.0	PROJECT MANAGER: C. BEAN		
							439.4	0.0	27	0	0	95	0	0	79	1160.0	0	0.0	0.0	0.0	0.0	0.0	0.0	DESIGNED BY: S. GOODWIN			DRAWN BY: S. GOODWIN							
																														CHECKED BY: D. MUNRO				
																														SHEET 61 OF 105				