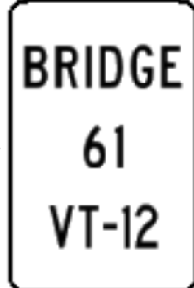


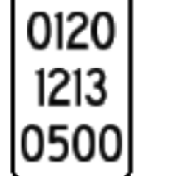




DIRECTION	MILEPOINT	LOCATION CODE (SHEET 3)	SIGN CODE	WIDTH (IN)	HEIGHT (IN)	SHEETING REMARKS	SIGN LEGEND	NEW SIGNS		EXISTING SIGNS				EXIST POST		NUMBER OF NEW POSTS	SQUARE STEEL (IN)			TUBULAR STEEL Ø (IN)				SIGN FRAME REQUIRED	REMARKS	SIGN DETAIL LOCATION			
								"A"	"B"	RETAIN	SALVAGE FROM	SALVAGE TO	REMOVE	RETAIN	REMOVE		1.75	2.00	2.50	FOUNDATION	3.00	3.50	4.00			5.00	SHSM	PROJECT SHEET #	STANDARD SHEET #
																	(LB / FT)				(LB / FT)								
<b>SB NORTHFIELD VT 12</b>							FY-FLUORESCENT YELLOW FYG-FLUORESCENT YELLOW GREEN																"SHSM"-STANDARD HIGHWAY SIGNS AND MARKINGS BOOK						
SB	5.098	F	VD-062AS	72	16		OFFICIAL BUSINESS DIRECTIONAL SIGN			1					X										NORTHFIELD INN LEFT ON PROSPECT				
SB	5.078	F	VD-701	6	8																								
		F	VD-701	6	10			0.42							4'	4'-10"													T-42
SB	5.013	EF	D-3	24	6		DOG RIVER DR																		DOG RIVER DR				
		F		12	18		BUS STOP			1																			
		EF	D3-1	54	12			4.50							8'	7'-5" 8'-3"									INSTALL INDEPENDENTLY ON TWO POSTS ON LEGAL LOAD SIDE OF INTERSECTION		10		
		F		12	18		BUS STOP																		INSTALL ON LEFT POST				
SB	5.006	H					BUCKLE UP VERMONT																		RETURN TO TOWN				
		H	R1-1	30	30			6.25							4'	9'-6"										X			
		G	VD-700	6	10			0.42																	INSTALL BACK TO BACK ON STOP SIGN POST			T-44	
SB	4.846	F	VR-038	24	18		STATE HIGHWAY ENDS			1																			
		F	R2-1	24	30		SPEED LIMIT 30																						
		F	VR-038	24	18		STATE HIGHWAY ENDS																						
		F	R2-1	30	36		 	7.50							4'	11'-0"									NOTE: NEW SIGN IS LARGER NOTE: PROJECT SUSPENDS HERE AT NORTHERN CLASS 1 TH LIMIT IN NORTHFIELD	X			
SB	3.044	F	VR-039	24	12		STATE HIGHWAY BEGINS (CONT. ON NEXT SHEET)			1															NOTE: PROJECT RESUMES HERE AT SOUTHERN CLASS 1 TH LIMIT IN NORTHFIELD				
<b>SIGN SUMMARY SHEET</b>							SHEET TOTALS	19.09	0.00	2	3	3	7	0	0	5	6'-0"	0	0.0	0.0	0.0	0.0	0.0	PROJECT NAME: <b>RANDOLPH-BERLIN</b> PROJECT NUMBER: <b>STPG SIGN(52)</b>					
VERMONT AGENCY OF TRANSPORTATION							TOWN DIRECTIONAL TOTALS	341.2	0.0	26	2	2	72	0	0	65	950.0	0		0.0				FILE NAME: <b>z13c626tsnorthfield SB</b> PLOT DATE: <b>5/12/2015</b> PROJECT MANAGER: <b>C. BEAN</b> DRAWN BY: <b>S. GOODWIN</b> DESIGNED BY: <b>S. GOODWIN</b> CHECKED BY: <b>D. MUNRO</b> NORTHFIELD VT-12 SOUTHBOUND 5 SHEET <b>72</b> OF <b>105</b>					