
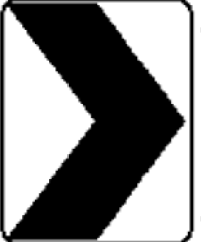
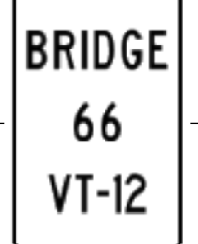




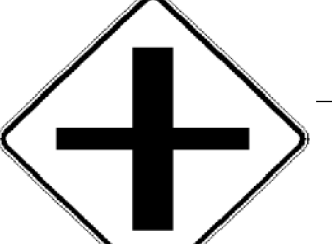




| DIRECTION                        | MILEPOINT | LOCATION CODE (SHEET 3) | SIGN CODE | WIDTH (IN) | HEIGHT (IN) | SHEETING REMARKS | SIGN LEGEND   | NEW SIGNS |      | EXISTING SIGNS |              |            |        | EXIST POST |        | NUMBER OF NEW POSTS | SQUARE STEEL (IN) |      |      | TUBULAR STEEL Ø (IN) |           |      |   | SIGN FRAME REQUIRED  | REMARKS  | SIGN DETAIL LOCATION   |      |                 |                  |       |
|----------------------------------|-----------|-------------------------|-----------|------------|-------------|------------------|---|-----------|------|----------------|--------------|------------|--------|------------|--------|---------------------|-------------------|------|------|----------------------|-----------|------|---|--|--|--|------|-----------------|------------------|-------|
|                                  |           |                         |           |            |             |                  |   | "A"       | "B"  | RETAIN         | SALVAGE FROM | SALVAGE TO | REMOVE | RETAIN     | REMOVE |                     | 1.75              | 2.00 | 2.50 | FOUNDATION           | 3.00      | 3.50 | 4.00  |  |  | 5.00   | SHSM | PROJECT SHEET # | STANDARD SHEET # |       |
|                                  |           |                         |           |            |             |                  |   |           |      |                |              |            |        |            |        |                     | (LB / FT)         |      |      |                      | (LB / FT) |      |   |  |  |  |      |                 |                  |       |
| <b>NB BERLIN VT12</b>            |           |                         |           |            |             |                  | FY-FLUORESCENT YELLOW<br>FYG-FLUORESCENT YELLOW GREEN                               |           |      |                |              |            |        |            |        |                     |                   |      |      |                      |           |      | "SHSM"-STANDARD HIGHWAY SIGNS AND MARKINGS BOOK |  |  |  |      |                 |                  |       |
| NB                               | 1.873     | A                       | W1-8L     | 18         | 24          |                  |    | 3.00      |      |                |              |            |        |            | 4'     | 8'-9"               |                   |      |      |                      |           |      |   |  |  | INSTALL 95 FT ± NORTH OF PROPOSED SIGN AT MP 1.855                           | X    |                 |                  |       |
| NB                               | 1.873     | B                       | W1-8R     | 18         | 24          |                  |    | 3.00      |      |                |              |            |        |            | 4'     | 8'-11"              |                   |      |      |                      |           |      |   |  |  | INSTALL SIGN FACING SOUTHBOUND TRAFFIC                                       | X    |                 |                  |       |
| NB                               | 1.873     | A                       | VD-701    | 6          | 8           |                  |    |                                  |           | A                       | VD-701    | 6          | 10          |                  |   | 0.42      |      |                |              |            |        |            | 4'     | 5'-4"               | X                 |      |      |                      |           |      |   |  |  |  |      |                 | T-42             |       |
| NB                               | 1.885     | A                       | W1-8L     | 18         | 24          |                  | LEFT CHEVRON  |           |      | NB                               | 1.888     | A                       | W1-8L     | 18         | 24          |                  |   | 3.00      |      |                |              |            |        |            | 4'     | 8'-9"               |                   |      |      |                      |           |      |   |  |  | INSTALL 80 FT ± NORTH OF PROPOSED SIGN AT MP 1.873                           | X    |                 |                  |       |
| NB                               | 1.888     | B                       | W1-8R     | 18         | 24          |                  |  | 3.00      |      |                |              |            |        |            | 4'     | 8'-9"               |                   |      |      |                      |           |      |   |  |  | INSTALL SIGN FACING SOUTHBOUND TRAFFIC                                       | X    |                 |                  |       |
| NB                               | 1.901     | A                       | R2-1      | 24         | 30          |                  | SPEED LIMIT 35  |           |      | NB                               | 1.909     | A                       | W1-8L     | 18         | 24          |                  |  | 3.00      |      |                |              |            |        |            | 4'     | 8'-10"              |                   |      |      |                      |           |      |   |  |  | INSTALL 110 FT ± NORTH OF PROPOSED SIGN AT MP 1.888                          | X    |                 |                  |       |
| NB                               | 1.909     | B                       | W1-8R     | 18         | 24          |                  |  | 3.00      |      |                |              |            |        |            | 4'     | 8'-10"              |                   |      |      |                      |           |      |   |  |  | INSTALL SIGN FACING SOUTHBOUND TRAFFIC                                       | X    |                 |                  |       |
| NB                               | 1.923     | A                       | W2-1M     | 30         | 30          |                  | TOWN HIGHWAY INTERSECTION   |           |      |                                  |           | A                       | W5-2      | 30         | 30          |                  | NARROW BRIDGE   |           |      |                                  |           | A                       | W2-1M     | 36         | 36          |                  |  | 9.00      |      |                |              |            |        |            | 8'     | 13'-9"<br>14'-1"    |                   |      |      |                      |           |      |   |  |  |  |      |                 |                  | E-155 |
|                                  |           | A                       | W5-2      | 36         | 36          |                  |  | 9.00      |      |                | NB                               | 1.924     | B                       | W1-8R     | 18         | 24          |                  |  | 3.00      |      |                |              |            |        |            | 4'     | 9'-4"               |                   |      |      |                      |           |      |   |  |  | INSTALL SIGN FACING SOUTHBOUND TRAFFIC                                       | X    |                 |                  |       |
| <b>SIGN SUMMARY SHEET</b>        |           |                         |           |            |             |                  | SHEET TOTALS  | 39.42     | 0.00 | 0              | 0            | 0          | 5      | 0          | 0      | 10                  | 135'-4"<br>146.0  |      | 0    | 0.0                  | 0.0       | 0.0  | 0.0   |  |  | PROJECT NAME: <b>RANDOLPH-BERLIN</b><br>PROJECT NUMBER: <b>STPG SIGN(52)</b> |      |                 |                  |       |
| VERMONT AGENCY OF TRANSPORTATION |           |                         |           |            |             |                  | TOWN DIRECTIONAL TOTALS   | 399.8     | 0.0  | 8              | 3            | 3          | 83     | 0          | 0      | 96                  | 1385.0            |      | 0    |                      | 0.0       |      |   |  | FILE NAME: <b>z13c626tsberlin NB</b><br>PROJECT MANAGER: <b>C. BEAN</b><br>DESIGNED BY: <b>S. GOODWIN</b><br>BERLIN VT-12 NORTHBOUND 6 |  |      |                 |                  |       |
|                                  |           PLOT DATE: <b>5/12/2015</b><br>DRAWN BY: <b>S. GOODWIN</b><br>CHECKED BY: <b>D. MUNRO</b><br>SHEET <b>85</b> OF <b>105</b> |  |  |      |                 |                  |       |