
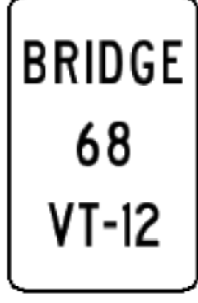



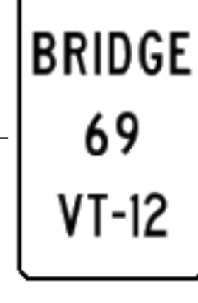



DIRECTION	MILEPOINT	LOCATION CODE (SHEET 3)	SIGN CODE	WIDTH (IN)	HEIGHT (IN)	SHEETING REMARKS	SIGN LEGEND	NEW SIGNS		EXISTING SIGNS				EXIST POST		NUMBER OF NEW POSTS	SQUARE STEEL (IN)			TUBULAR STEEL Ø (IN)				SIGN FRAME REQUIRED	REMARKS	SIGN DETAIL LOCATION			
								"A"	"B"	RETAIN	SALVAGE FROM	SALVAGE TO	REMOVE	RETAIN	REMOVE		1.75	2.00	2.50	FOUNDATION	3.00	3.50	4.00			5.00	SHSM	PROJECT SHEET #	STANDARD SHEET #
																	(LB / FT)				(LB / FT)								
NB BERLIN VT12							FY-FLUORESCENT YELLOW FYG-FLUORESCENT YELLOW GREEN																"SHSM"-STANDARD HIGHWAY SIGNS AND MARKINGS BOOK						
NB	2.483	A	R2-1	24	30																		NOTE: CERTIFICATE AT MP 2.45						
		A	R2-1	24	30			5.00							4'	10'-8"								X					
NB	2.579	A	VD-701	6	8																		EXISTING GONE						
		A	VD-701	6	10			0.42							4'	5'-1"										T-42			
NB	2.581	A	OM3-R	12	36																								
		A	OM3-R	12	36			3.00							4'	7'-3"							INSTALL AT 4 FT VERTICAL CLEARANCE	X					
NB	2.586	B	OM3-L	12	36																		SIGN FACING SOUTHBOUND TRAFFIC						
		B	OM3-L	12	36			3.00							4'	7'-3"							INSTALL AT 4 FT VERTICAL CLEARANCE	X					
NB	2.679	A	R2-1	24	30																								
		A	R2-1	24	30			5.00							4'	9'-4"							NOTE: CERTIFICATE AT MP 2.65	X					
NB	3.304	A	VD-701	6	8																								
		A	VD-701	6	10			0.42							4'	5'-1"										T-42			
NB	3.522	AB	D-3	24	6		COLBY RD TH 38																COLBY RD (TH-38)						
		AB	D3-1	39	12			3.25							4'	7'-10"							INSTALL INDEPENDENTLY ON ONE POST ON STOP SIGN SIDE OF THE INTERSECTION		11				
NB	3.812	C	R2-1	24	30		SPEED LIMIT 35																ROWELL HILL RD (TH-39)						
SIGN SUMMARY SHEET							SHEET TOTALS		20.09	0.00	0	1	0	7	0	0	7	80'-6"	0	0.0	0.0	0.0	0.0	PROJECT NAME: RANDOLPH-BERLIN					
VERMONT AGENCY OF TRANSPORTATION							TOWN DIRECTIONAL TOTALS		399.8	0.0	8	3	3	83	0	0	96	95.0	0	0.0	0.0	0.0	0.0	PROJECT NUMBER: STPG SIGN(52)					
									SF	SF	EA	EA	EA	EA	EA	EA	EA	FT	EA	LB	LB	LB	LB	FILE NAME: z13c626tsberlin NB					
																								PLOT DATE: 5/12/2015					
																								PROJECT MANAGER: C. BEAN					
																								DRAWN BY: S. GOODWIN					
																								DESIGNED BY: S. GOODWIN					
																								CHECKED BY: D. MUNRO					
																								BERLIN VT-12 NORTHBOUND 9					
																								SHEET 88 OF 105					