

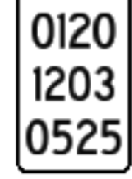
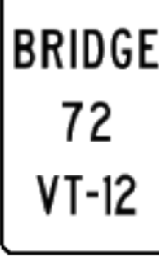


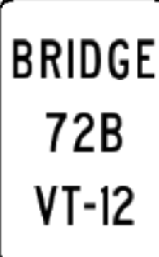


DIRECTION	MILEPOINT	LOCATION CODE (SHEET 3)	SIGN CODE	WIDTH (IN)	HEIGHT (IN)	SHEETING REMARKS	SIGN LEGEND	NEW SIGNS		EXISTING SIGNS				EXIST POST		NUMBER OF NEW POSTS	SQUARE STEEL (IN)			TUBULAR STEEL Ø (IN)				SIGN FRAME REQUIRED	REMARKS	SIGN DETAIL LOCATION			
								"A"	"B"	RETAIN	SALVAGE FROM	SALVAGE TO	REMOVE	RETAIN	REMOVE		1.75	2.00	2.50	FOUNDATION	3.00	3.50	4.00			5.00	SHSM	PROJECT SHEET #	STANDARD SHEET #
																	(LB / FT)				(LB / FT)								
NB BERLIN VT12							FY-FLUORESCENT YELLOW FYG-FLUORESCENT YELLOW GREEN																"SHSM"-STANDARD HIGHWAY SIGNS AND MARKINGS BOOK						
		C	R2-1	24	30			(CONT.)	5.00															BROWNS MILL RD (TH-16)	X				
NB	5.253	D	R1-1	30	30			STOP				1		X										BROWNS MILL RD (TH-16)					
		D	VD-700	6	8			MILE MARKER 0120 / 1203 / 0525				1																	
		D	R1-1	30	30				6.25						4'	8'-9"									X				
		C	VD-700	6	10				0.42															INSTALL BACK TO BACK ON STOP SIGN POST			T-44		
NB	5.853	A	VD-701	6	8							1		X															
		A	VD-701	6	10				0.42						4'	4'-10"											T-42		
NB	6.439	A	VW-054R	30	30			HIDDEN DRIVE RIGHT				1		X															
NB	6.480	A	VW-054R	30	30				6.25						4'	11'-0"								INSTALL 215 FT ± NORTH OF EXISTING SIGN AT MP 6.439			E-154		
NB	6.569	A	R2-5A	24	30			REDUCED SPEED AHEAD				1		X															
		A	W3-5	36	36				9.00						8'	12'-3" 11'-8"									X				
NB	6.636	A	VD-062AS	72	16			OFFICIAL BUSINESS DIRECTIONAL SIGN			1			X										Betsy's B&B rt. At 2nd light					
		A	VD-062AS	72	16			OFFICIAL BUSINESS DIRECTIONAL SIGN			1													Westview Medows right on independence					
NB	6.643	A	VD-701	6	8			BRIDGE 72A VT 12				1		X										NEW SIGN AT MP 6.671					
NB	6.648	A	VD-701	6	10				0.42						4'	4'-11"								INSTALL 25 FT ± NORTH OF EXISTING SIGN AT MP 6.643			T-42		
SIGN SUMMARY SHEET							SHEET TOTALS				27.76	0.00	2	0	0	6	0	0	6	77'-5" 80.0	0	0.0	0.0	0.0	0.0	PROJECT NAME: RANDOLPH-BERLIN PROJECT NUMBER: STPG SIGN(52)			
VERMONT AGENCY OF TRANSPORTATION							TOWN DIRECTIONAL TOTALS				399.8	0.0	8	3	3	83	0	0	96	1385.0	0	0.0				FILE NAME: z13c626tsberlin NB PLOT DATE: 5/12/2015 PROJECT MANAGER: C. BEAN DRAWN BY: S. GOODWIN DESIGNED BY: S. GOODWIN CHECKED BY: D. MUNRO BERLIN VT-12 NORTHBOUND 12 SHEET 91 OF 105			