


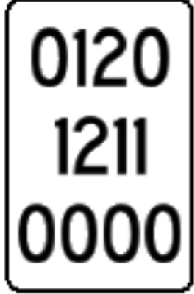
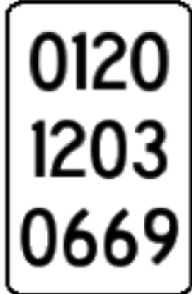


DIRECTION	MILEPOINT	LOCATION CODE (SHEET 3)	SIGN CODE	WIDTH (IN)	HEIGHT (IN)	SHEETING REMARKS	SIGN LEGEND	NEW SIGNS		EXISTING SIGNS				EXIST POST		NUMBER OF NEW POSTS	SQUARE STEEL (IN)			TUBULAR STEEL Ø (IN)				SIGN FRAME REQUIRED	REMARKS	SIGN DETAIL LOCATION			
								"A"	"B"	RETAIN	SALVAGE FROM	SALVAGE TO	REMOVE	RETAIN	REMOVE		1.75	2.00	2.50	FOUNDATION	3.00	3.50	4.00			5.00	SHSM	PROJECT SHEET #	STANDARD SHEET #
																	(LB / FT)				(LB / FT)								
NB BERLIN VT12							FY-FLUORESCENT YELLOW FYG-FLUORESCENT YELLOW GREEN																"SHSM"-STANDARD HIGHWAY SIGNS AND MARKINGS BOOK						
NB	6.671	A	VD-701	6	10			0.42							4'	5'-4"									INSTALL 70 FT ± SOUTH OF EXISTING SIGN AT MP 6.685			T-42	
NB	6.685	A	R2-1	24	30		SPEED LIMIT 30																						
		A	VR-040	24	24		THROUGH WAY ENDS HERE																						
		A		18	24		RIFLE PARKING BAN			1																			
		B	VR-039	24	18		STATE HIGHWAY BEGINS																		ON BACK				
		A	VR-038	24	18			3.00							4'	11'-11"												E-141	
		A	R2-1	30	36		SPEED LIMIT 30	7.50																	NOTE: NEW SIGN IS LARGER	X			
		A		18	24		PARKING BAN				1																		
NB	6.685	C	VD-024	72	10			5.00							8'	7'-9" 7'-8"									INSTALL DIRECTLY ACROSS ROAD FROM THE EXISTING ASSEMBLY, WHICH IS TO BE REMOVED		9		
		C	VD-700	6	10			0.42																	INSTALL MONTPELIER MILE MARKER ON LEFT POST UNDER MONTPELIER			T-44	
		C	VD-700	6	10			0.42																	INSTALL BERLIN MILE MARKER ON RIGHT POST UNDER BERLIN			T-44	
SIGN SUMMARY SHEET							SHEET TOTALS	16.76	0.00	0	1	1	4	0	0	4	48'-8" 55.0-	0	0.0	0.0	0.0	0.0			PROJECT NAME: RANDOLPH-BERLIN				
								SF	SF	EA	EA	EA	EA	EA	EA	EA	FT	EA	LB	LB	LB	LB		PROJECT NUMBER: STPG SIGN(52)					
VERMONT AGENCY OF TRANSPORTATION							TOWN DIRECTIONAL TOTALS	399.81 399.8	0.0	8	3	3	83	0	0	95 96	1235.92 1385.0	0		0.0					FILE NAME: z13c626ts berlin NB	PLOT DATE: 5/12/2015			
																								PROJECT MANAGER: C. BEAN	DRAWN BY: S. GOODWIN				
																								DESIGNED BY: S. GOODWIN	CHECKED: D. MUNRO				
																								BERLIN VT-12 NORTHBOUND 13	SHEET 92	OF	105		