


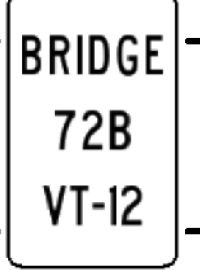


DIRECTION	MILEPOINT	LOCATION CODE (SHEET 3)	SIGN CODE	WIDTH (IN)	HEIGHT (IN)	SHEETING REMARKS	SIGN LEGEND	NEW SIGNS		EXISTING SIGNS				EXIST POST		NUMBER OF NEW POSTS	SQUARE STEEL (IN)			TUBULAR STEEL Ø (IN)				SIGN FRAME REQUIRED	REMARKS	SIGN DETAIL LOCATION			
								"A"	"B"	RETAIN	SALVAGE FROM	SALVAGE TO	REMOVE	RETAIN	REMOVE		1.75	2.00	2.50	FOUNDATION	3.00	3.50	4.00			5.00	SHSM	PROJECT SHEET #	STANDARD SHEET #
																	(LB / FT)				(LB / FT)								
SB BERLIN VT 12							FY-FLUORESCENT YELLOW FYG-FLUORESCENT YELLOW GREEN																"SHSM"-STANDARD HIGHWAY SIGNS AND MARKINGS BOOK						
SB	6.685	G	VD-024	60	7.5		BERLIN / MONTPELIER																NEW TOWN LINE SIGN TO BE INSTALLED DIRECTLY ACROSS FROM THIS ASSEMBLY, ADJACENT TO THE NB LANE						
		G	VD-700	6	8		MILE MARKER 0120 / 1203 / 0669 (BERLIN)																						
		G	VD-700	6	8		MILE MARKER 0120 / 1211 / 0000 (MONTPELIER)																						
SB	6.685	F	VD-701	6	8		BRIDGE 72A VT12																						
SB	6.685	F	R2-1	24	30		SPEED LIMIT 50																						
		F	VR-041	24	24		THROUGH WAY BEGINS HERE																						
		E	VR-038	24	18		STATE HIGHWAY ENDS																ON BACK						
		F	VR-039	24	18			3.00							4'	1	11'-1"									E-141			
		F	R2-1	24	30			5.00																X					
SB	6.676	F	VD-701	6	10			0.42							4'	1	5'-1"						INSTALL 50 FT ± SOUTH OF EXISTING SIGN AT MP 6.685			T-42			
SB	6.652	F	VD-701	6	10			0.42							4'	1	5'-1"						INSTALL 175 FT ± SOUTH OF EXISTING SIGN AT MP 6.685			T-42			
SB	6.368	G	R2-1	24	30		SPEED LIMIT 35			1																			
		G	VR-017	24	30		LLL 24,000 LBS			1																			
SB	6.360	H	R1-1	30	30		STOP			1																			
SB	6.358	GH	D3-1	48	12		Northfield St			1																			
SIGN SUMMARY SHEET							SHEET TOTALS	8.84	0.00	4	0	0	7	0	0	3	33'-3" 35.0'	0	0.0	0.0	0.0	0.0		PROJECT NAME: RANDOLPH-BERLIN					
								SF	SF	EA	EA	EA	EA	EA	EA	EA	FT	EA	LB	LB	LB	LB	PROJECT NUMBER: STPG SIGN(52)						
VERMONT AGENCY OF TRANSPORTATION							TOWN DIRECTIONAL TOTALS	303.4	0.0	15	3	3	80	0	0	70	990.0	0		0.0			FILE NAME: z13c626tsBerlin SB						
																						PLOT DATE: 5/12/2015							
																						PROJECT MANAGER: C. BEAN							
																						DRAWN BY: S. GOODWIN							
																						CHECKED BY: D. MUNRO							
																						DESIGNED BY: S. GOODWIN							
																						BERLIN VT-12 SOUTHBOUND 1							
																						SHEET 93 OF 105							