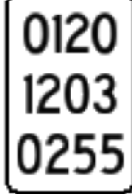




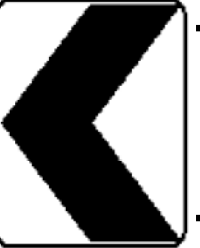




DIRECTION	MILEPOINT	LOCATION CODE (SHEET 3)	SIGN CODE	WIDTH (IN)	HEIGHT (IN)	SHEETING REMARKS	SIGN LEGEND	NEW SIGNS		EXISTING SIGNS				EXIST POST		NUMBER OF NEW POSTS	SQUARE STEEL (IN)			TUBULAR STEEL Ø (IN)				SIGN FRAME REQUIRED	REMARKS	SIGN DETAIL LOCATION			
								"A"	"B"	RETAIN	SALVAGE FROM	SALVAGE TO	REMOVE	RETAIN	REMOVE		1.75	2.00	2.50	FOUNDATION	3.00	3.50	4.00			5.00	SHSM	PROJECT SHEET #	STANDARD SHEET #
																	(LB / FT)				(LB / FT)								
SB BERLIN VT 12							FY-FLUORESCENT YELLOW FYG-FLUORESCENT YELLOW GREEN																"SHSM"-STANDARD HIGHWAY SIGNS AND MARKINGS BOOK						
		G	VD-700	6	10			(CONT.)	0.42															CHASE RD (TH-35) INSTALL BACK TO BACK ON STOP SIGN POST			T-44		
SB	2.549	EF	D-3	24	6			CHASE RD TH 35					1		X														
		EF	D3-1	39	12				3.25							4'	7'-0"							INSTALL INDEPENDENTLY ON ONE POST CLOSER TO INTERSECTION ON STOP SIGN SIDE.		11			
SB	2.483	F	R2-1	24	30								1		X									CERTIFICATE MP 2.45					
		F	R2-1	30	36				7.50							4'	9'-11"							NOTE: NEW SIGN IS LARGER	X				
SB	2.416	F	W1-10d	30	30			MODIFIED REVERSE CURVE					1		X														
		F	W1-10L	36	36				9.00							8'	9'-3" 9'-3"								X				
		F	W16-8p	27	8				1.50															INSTALL ON LEFT POST		7			
SB	2.326	F	W1-8L	18	24			LEFT CHEVRON					1		X														
SB	2.326	E	W1-8R	18	24			RIGHT CHEVRON					1		X														
SB	2.325	F	W1-8L	18	24				3.00							4'	8'-7"							INSTALL 5 FT ± SOUTH OF EXISTING SIGN AT MP 2.326	X				
SB	2.325	E	W1-8R	18	24				3.00							4'	8'-7"							INSTALL SIGN FACING NORTHBOUND TRAFFIC	X				
SB	2.310	F	W1-8L	18	24								1		X														
		F	W1-8L	18	24				3.00							4'	9'-3"								X				
SIGN SUMMARY SHEET							SHEET TOTALS			30.67	0.00	0	0	0	6	0	0	7	89'-10" 105.0	0	0.0	0.0	0.0	0.0	PROJECT NAME: RANDOLPH-BERLIN PROJECT NUMBER: STPG SIGN(52)				
VERMONT AGENCY OF TRANSPORTATION							TOWN DIRECTIONAL TOTALS			303.4	0.0	15	3	3	80	0	0	70	990.0	0	0.0				FILE NAME: z13c626tsberlin SB PROJECT MANAGER: C. BEAN DESIGNED BY: S. GOODWIN BERLIN VT-12 SOUTHBOUND 6	PLOT DATE: 5/12/2015 DRAWN BY: S. GOODWIN CHECKED: D. MUNRO SHEET 98 OF 105			