

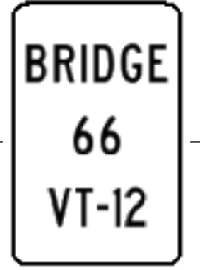




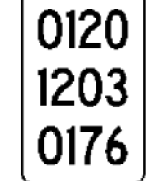
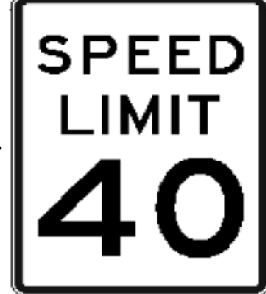


DIRECTION	MILEPOINT	LOCATION CODE (SHEET 3)	SIGN CODE	WIDTH (IN)	HEIGHT (IN)	SHEETING REMARKS	SIGN LEGEND	NEW SIGNS		EXISTING SIGNS				EXIST POST		NUMBER OF NEW POSTS	SQUARE STEEL (IN)			TUBULAR STEEL Ø (IN)				SIGN FRAME REQUIRED	REMARKS	SIGN DETAIL LOCATION			
								"A"	"B"	RETAIN	SALVAGE FROM	SALVAGE TO	REMOVE	RETAIN	REMOVE		1.75	2.00	2.50	FOUNDATION	3.00	3.50	4.00			5.00	SHSM	PROJECT SHEET #	STANDARD SHEET #
																	(LB / FT)				(LB / FT)								
<b>SB BERLIN VT 12</b>							FY-FLUORESCENT YELLOW FYG-FLUORESCENT YELLOW GREEN																"SHSM"-STANDARD HIGHWAY SIGNS AND MARKINGS BOOK						
		H	R1-1	30	30		 (CONT.)	6.25															SCHOOL ST (TH-48)	X					
		G	VD-700	6	10			0.42															INSTALL BACK TO BACK ON STOP SIGN POST			T-44			
SB	1.890	EF	D-3	24	6		SCHOOL STREET TH 48																						
SB	1.882	F	VD-701	6	8																								
		F	VD-701	6	10			0.42							4'	5'-2"										T-42			
SB	1.800	F	R3-1	24	24			4.00							4'	8'-10"							INSTALL 145 FT ± NORTH OF EXISTING SIGN AT MP 1.773	X					
SB	1.773	G	R5-1	30	30																		AYERS RD (TH-54)						
		G	R5-1	30	30			6.25							4'	8'-3"							INSTALL NEW SIGN AT SAME LOCATION ON AYERS RD	X					
SB	1.764	H	R1-1	30	30		STOP																						
		G	VD-700	6	8		MILE MARKER 0120 / 1203 / 0176																						
		H	R1-1	30	30			6.25							4'	11'-9"							AYERS RD (TH-54)	X					
		G	R5-1	30	30			6.25															INSTALL BACK TO BACK ON STOP SIGN POST	X					
		G	VD-700	6	10			0.42															INSTALL BACK TO BACK ON STOP SIGN POST			T-44			
SB	1.710	F	R2-1	24	30																								
		F	R2-1	24	30			5.00							4'	10'-9"								X					
<b>SIGN SUMMARY SHEET</b>							SHEET TOTALS	35.26	0.00	0	0	0	6	0	0	5	<del>64'-9"</del> 70.0	0	0.0	0.0	0.0	0.0		PROJECT NAME: <b>RANDOLPH-BERLIN</b> PROJECT NUMBER: <b>STPG SIGN(52)</b>					
VERMONT AGENCY OF TRANSPORTATION							TOWN DIRECTIONAL TOTALS	303.4	0.0	15	3	3	80	0	0	70	990.0	0		0.0				FILE NAME: <b>z13c626tsberlin SB</b> PROJECT MANAGER: <b>C. BEAN</b> DESIGNED BY: <b>S. GOODWIN</b> BERLIN VT-12 SOUTHBOUND 10	PLOT DATE: <b>5/12/2015</b> DRAWN BY: <b>S. GOODWIN</b> CHECKED BY: <b>D. MUNRO</b> SHEET <b>102</b> OF <b>105</b>				