
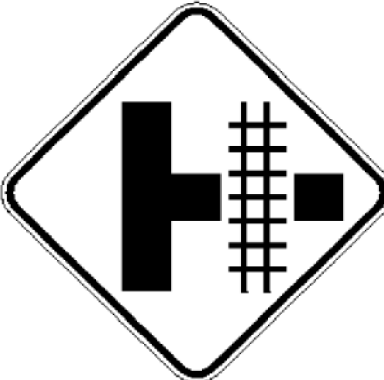




DIRECTION	MILEPOINT	LOCATION CODE (SHEET 3)	SIGN CODE	WIDTH (IN)	HEIGHT (IN)	SHEETING REMARKS	SIGN LEGEND	NEW SIGNS		EXISTING SIGNS				EXIST POST		NUMBER OF NEW POSTS	SQUARE STEEL (IN)			TUBULAR STEEL Ø (IN)				SIGN FRAME REQUIRED	REMARKS	SIGN DETAIL LOCATION			
								"A"	"B"	RETAIN	SALVAGE FROM	SALVAGE TO	REMOVE	RETAIN	REMOVE		1.75	2.00	2.50	FOUNDATION	3.00	3.50	4.00			5.00	SHSM	PROJECT SHEET #	STANDARD SHEET #
																	(LB / FT)				(LB / FT)								
<b>SB BERLIN VT 12</b>							FY-FLUORESCENT YELLOW FYG-FLUORESCENT YELLOW GREEN																"SHSM"-STANDARD HIGHWAY SIGNS AND MARKINGS BOOK						
SB	1.561	F	S3-1	30	30		SCHOOL BUS STOP AHEAD																SIGN NO LONGER WARRANTED						
		F	W1-10d	30	30		MODIFIED RIGHT REVERSE CURVE																						
SB	1.509	F	R2-1	24	30																								
		F	R2-1	24	30				5.00						4'	9'-4"									X				
SB	1.155	F	W10-3R	30	30		RR CROSSING ON SIDE ROAD																						
SB	1.117	F	W10-3R	36	36		 Lovers Ln																INSTALL 200 FT ± SOUTH OF EXISTING SIGN AT MP 1.155	X					
		F	W16-8p	24	8				1.33														INSTALL ON LEFT POST			7			
SB	1.029	G	R2-1	24	30		SPEED LIMIT 35																						
		G	VR-017	24	30		LLL 24,000 LBS																						
		G	VR-017	24	30																		INSTALL NEW SIGNS AT SAME LOCATION ON LOVERS LN			E-141			
		G	R2-1	24	30				5.00						4'	12'-1"							LOVERS LN (TH-61)	X					
SB	1.019	H	R1-1	30	30		STOP																						
		G	VD-700	6	8		MILE MARKER 0120 / 1203 / 0102																ON BACK						
		EF	D3-1	42	12																		INSTALL PERPENDICULAR ON TOP OF STOP SIGN			10			
		H	R1-1	30	30			STOP (CONT. ON NEXT SHEET)																					
<b>SIGN SUMMARY SHEET</b>							<b>SHEET TOTALS</b>	28.83	0.00	0	1	1	8	0	0	5	<del>70'-3"</del> 75.0	0	0.0	0.0	0.0	0.0	PROJECT NAME: <b>RANDOLPH-BERLIN</b> PROJECT NUMBER: <b>STPG SIGN(52)</b>						
VERMONT AGENCY OF TRANSPORTATION							<b>TOWN DIRECTIONAL TOTALS</b>	303.4	0.0	15	3	3	80	0	0	70	990.0	0	0.0				FILE NAME: <b>z13c626tsBerlin SB</b> PROJECT MANAGER: <b>C. BEAN</b> DESIGNED BY: <b>S. GOODWIN</b> BERLIN VT-12 SOUTHBOUND 11	PLOT DATE: <b>5/12/2015</b> DRAWN BY: <b>S. GOODWIN</b> CHECKED: <b>D. MUNRO</b> SHEET <b>103</b> OF <b>105</b>					