
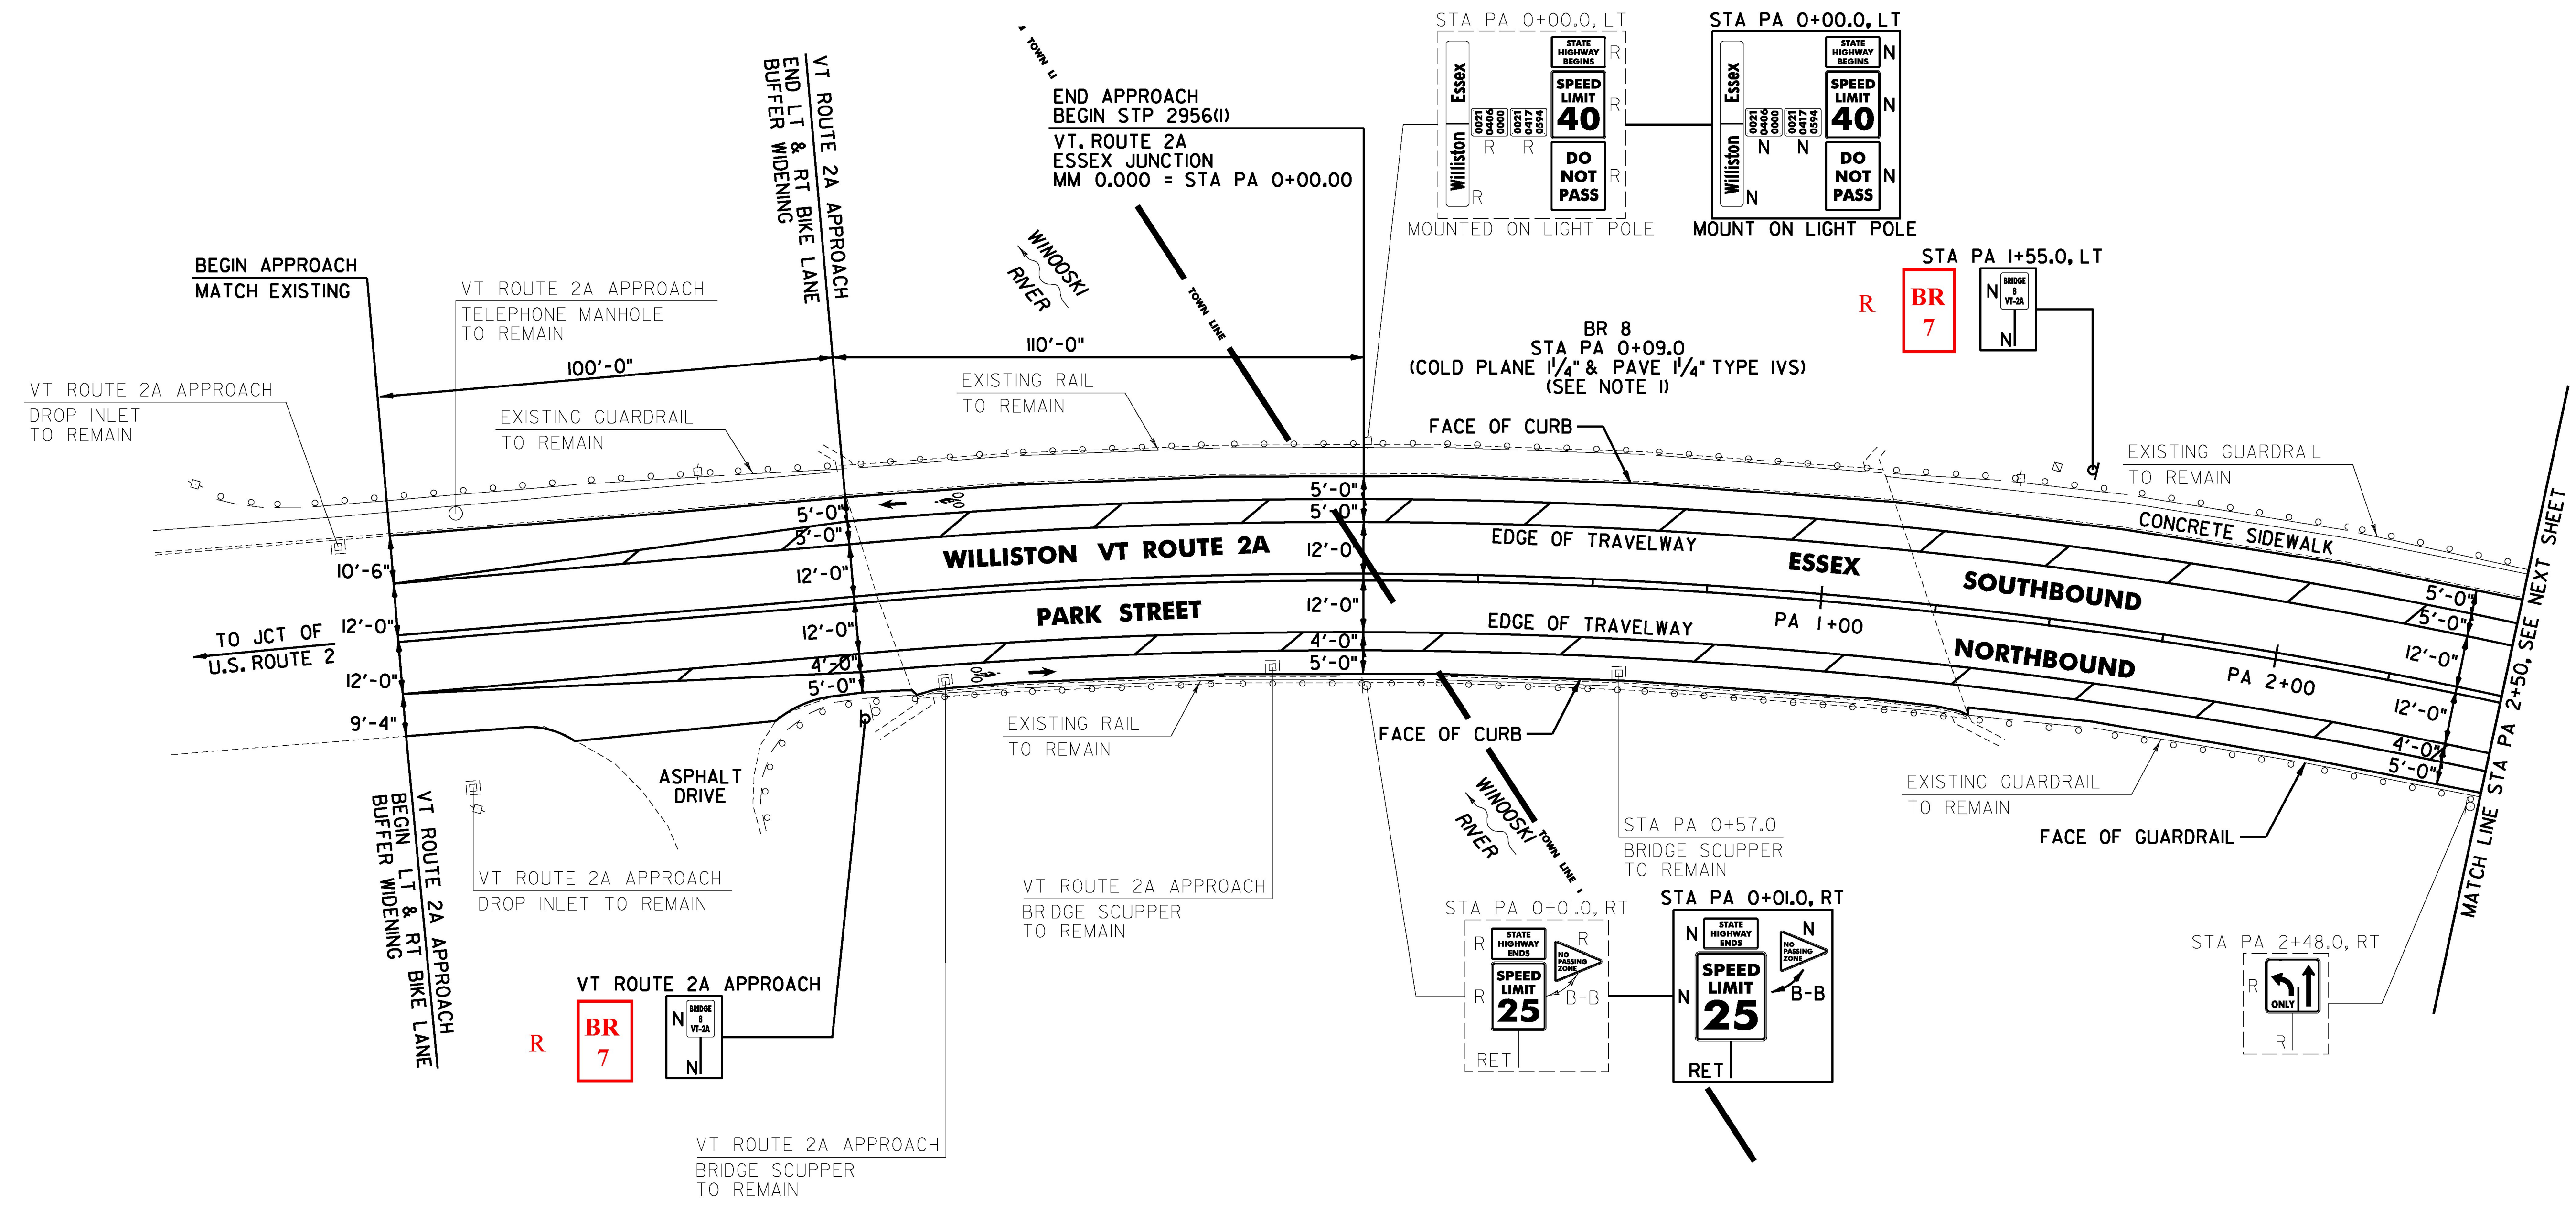


4 INCH WHITE LINE, LOW VOC CHLORINATED RUBBER PAINT AND TEMPORARY 4 INCH WHITE LINE, PAINT
 (ALL LINES WILL INCLUDE EDGE LINE BREAKS AND RADIUS FOR TOWN HIGHWAYS)
 ESSEX JUNCTION:
 VT ROUTE 2A APPROACH - STA PA 2+50.00 BIKE LANE LINES LT & RT
 VT ROUTE 2A APPROACH - STA PA 2+50.00 HATCH BUFFER LT & RT
 LETTER OR SYMBOL, LOW VOC CHLORINATED RUBBER PAINT
 ESSEX JUNCTION:
 VT ROUTE 2A APPROACH LT, BIKE LANE SYMBOL (1 EA)
 VT ROUTE 2A APPROACH RT, BIKE LANE SYMBOL (1 EA)

6 INCH WHITE LINE, LOW VOC CHLORINATED RUBBER PAINT AND TEMPORARY 6 INCH WHITE LINE, PAINT
 (ALL LINES WILL INCLUDE EDGE LINE BREAKS AND RADIUS FOR TOWN HIGHWAYS)
 ESSEX JUNCTION:
 VT ROUTE 2A APPROACH - STA PA 2+50.00 BIKE LANE LINES LT & RT

4 INCH YELLOW LINE, LOW VOC CHLORINATED RUBBER PAINT AND TEMPORARY 4 INCH YELLOW LINE, PAINT
 (ALL LINES WILL INCLUDE C/L LINE BREAKS FOR TOWN HIGHWAYS)
 S = SOLID, D = DASHED
 ESSEX JUNCTION:
 VT ROUTE 2A APPROACH - STA PA 2+50.00 LT C RT S - S
 TEMPORARY LETTER OR SYMBOL, PAINT
 ESSEX JUNCTION:
 VT ROUTE 2A APPROACH LT, BIKE LANE SYMBOL (2 EA)
 VT ROUTE 2A APPROACH RT, BIKE LANE SYMBOL (2 EA)

REMOVING SIGNS AS SHOWN - 10

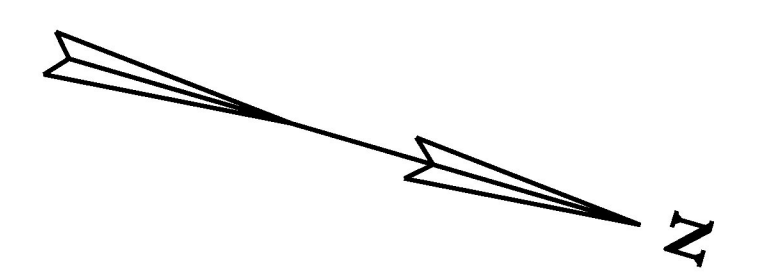

NOTE:

1. SEE STRUCTURES DETAIL SHEET SD-516.10 FOR DETAILS FOR ITEM 516.10 BRIDGE EXPANSION JOINT, ASPHALTIC PLUG, TO BE INSTALLED AT APPROACH JOINT AND AT STA PA 1+24.0.

SIGN LEGEND
 R = REMOVE
 S = SALVAGE
 N = NEW
 RET = RETAIN
 B-B = BACK TO BACK
 EXISTING = _____
 NEW = _____
 R = RETURN TO VILLAGE OF ESSEX JUNCTION

NOT TO SCALE



PROJECT NAME: ESSEX JUNCTION	PLOT DATE: 4/19/2016
PROJECT NUMBER: STP 2956(1)	DRAWN BY: A. KIRBY
FILE NAME: z14v251bdr.dgn	CHECKED BY: J. SHIELDS
DESIGNED BY: J. OLSEN	SHEET 28 OF 171
PLAN SHEET 1	