

4 INCH WHITE LINE, LOW VOC CHLORINATED RUBBER PAINT AND TEMPORARY 4 INCH WHITE LINE, PAINT
 (ALL LINES WILL INCLUDE EDGE LINE BREAKS AND RADIUS FOR TOWN HIGHWAYS)
ESSEX JUNCTION:
 STA PA 12+50.00 - STA PA 13+70.00 HATCH BUFFER LT & RT
 STA PA 12+50.00 - STA PA 13+70.00 BIKE LANE LINES LT & RT
 STA PA 13+70.00 - STA PA 14+70.00 DOTTED LANE LINE RT
 STA PA 13+70.00 - STA PA 15+76.00 BIKE LANE LINE RT
 STA PA 13+70.00 - STA PA 15+76.00 HATCH BUFFER RT
 STA PA 14+70.00 - STA PA 15+95.00 SOLID LANE LINE RT
 STA PA 16+31.52 EDGE LINES RT, RIVER STREET
 STA PA 16+63.00 - STA PA 16+96.00 RT, NO PARKING EDGE LINE
 STA PA 16+68.48 EDGE LINES LT, SOUTH STREET
 STA PA 16+92.00 - STA PA 17+50.00 EDGE LINE LT
 STA PA 17+12.00 - STA PA 17+50.00 SOLID LANE LINE LT
 STA PA 17+17.00 - STA PA 17+50.00 RT, PARKING SPACES

6 INCH WHITE LINE, LOW VOC CHLORINATED RUBBER PAINT AND TEMPORARY 6 INCH WHITE LINE, PAINT
 (ALL LINES WILL INCLUDE EDGE LINE BREAKS AND RADIUS FOR TOWN HIGHWAYS)
ESSEX JUNCTION:
 STA PA 12+50.00 - STA PA 16+34.00 BIKE LANE LINE LT
 STA PA 12+50.00 - STA PA 15+76.00 BIKE LANE LINE RT
 STA PA 15+76.00 - STA PA 15+95.00 DOTTED LANE LINE RT
 (Painted as 4" - 2 dots at 2")
24 INCH STOP BAR, LOW VOC CHLORINATED RUBBER PAINT AND TEMPORARY 24 INCH STOP BAR, PAINT
ESSEX (ESSEX JCT.):
 STA PA 15+71.00 LT/RT
 STA PA 15+94.00 RT
 STA PA 16+31.52 RT RIVER STREET
 STA PA 16+68+48 LT SOUTH STREET
 STA PA 17+13.00 LT

TEMPORARY LETTER OR SYMBOL, PAINT
ESSEX JUNCTION:
 STA PA 14+74.00 C/L, ARROW (2 EA)
 STA PA 15+62.00 C/L, ARROW (2 EA)
 STA PA 15+67.00 RT, BIKE LANE SYMBOL (2 EA)
 STA PA 16+25.00 LT, BIKE LANE SYMBOL (2 EA)
 STA PA 17+22.00 LT, ARROW (2 EA)
CROSSWALK MARKING, LOW VOC CHLORINATED RUBBER PAINT AND TEMPORARY CROSSWALK MARKING, PAINT
ESSEX JUNCTION:
 STA PA 16+31.52 RT, RIVER STREET
 STA PA 16+68.48 LT, SOUTH STREET
 STA PA 16+71.00 LT/RT


8 INCH YELLOW LINE, LOW VOC CHLORINATED RUBBER PAINT
ESSEX JUNCTION:
 STA PA 12+70.00 - STA PA 14+70.00 HATCHED MEDIAN LT/RT
8 INCH WHITE LINE, LOW VOC CHLORINATED RUBBER PAINT
ESSEX JUNCTION:
 STA PA 16+63.00 - STA PA 16+96.00 RT, NO PARKING

ERECTING SALVAGED SIGNS AS SHOWN - 2
REMOVING SIGNS AS SHOWN - 13
 STA PA 16+86.0, LT STA PA 16+86.0, LT

4 INCH YELLOW LINE, LOW VOC CHLORINATED RUBBER PAINT AND TEMPORARY 4 INCH YELLOW LINE, PAINT
 (ALL LINES WILL INCLUDE C/L LINE BREAKS FOR TOWN HIGHWAYS)
 S = SOLID, D = DASHED
ESSEX JUNCTION:
 STA PA 12+50.00 - STA PA 12+70.00 S - S
 STA PA 17+12.00 - STA PA 17+50.00 S - S
 STA PA 12+70.00 - STA PA 14+70.00 DOUBLE SOLID MEDIAN LT/RT
 STA PA 14+70.00 - STA PA 15+72.00 DOUBLE SOLID LT
 STA PA 16+31.52 DOUBLE SOLID RT, RIVER STREET
 STA PA 16+68.48 DOUBLE SOLID LT, SOUTH STREET

LETTER OR SYMBOL, LOW VOC CHLORINATED RUBBER PAINT
ESSEX JUNCTION:
 STA PA 14+74.00 C/L, ARROW (1 EA)
 STA PA 15+18.00 C/L, "O,N,L,Y" (4 EA)
 STA PA 15+62.00 C/L, ARROW (1 EA)
 STA PA 15+67.00 RT, BIKE LANE SYMBOL (1EA)
 STA PA 16+25.00 LT, BIKE LANE SYMBOL (1EA)
 STA PA 17+22.00 LT, ARROW (1 EA)

STA PA 15+38.0, LT STA PA 15+44.0, LT
 STA PA 15+05.0, LT R&S
 STA PA 16+43.0, LT
 STA PA 16+45.0, LT
 STA PA 16+43.0, LT
 STA PA 16+46.0, LT
 STA PA 16+51.0, LT
 STA PA 16+51.0, LT
 STA PA 16+43.0, LT
 STA PA 16+81.0
 STA PA 16+68.0
 STA PA 16+53.0
 STA PA 16+91.0, LT
 STA PA 16+93.0, LT
 STA PA 16+98.0
 STA PA 17+25.0
 STA PA 17+10.0, LT
 STA PA 17+20.0, RT
 STA PA 17+13.0, RT

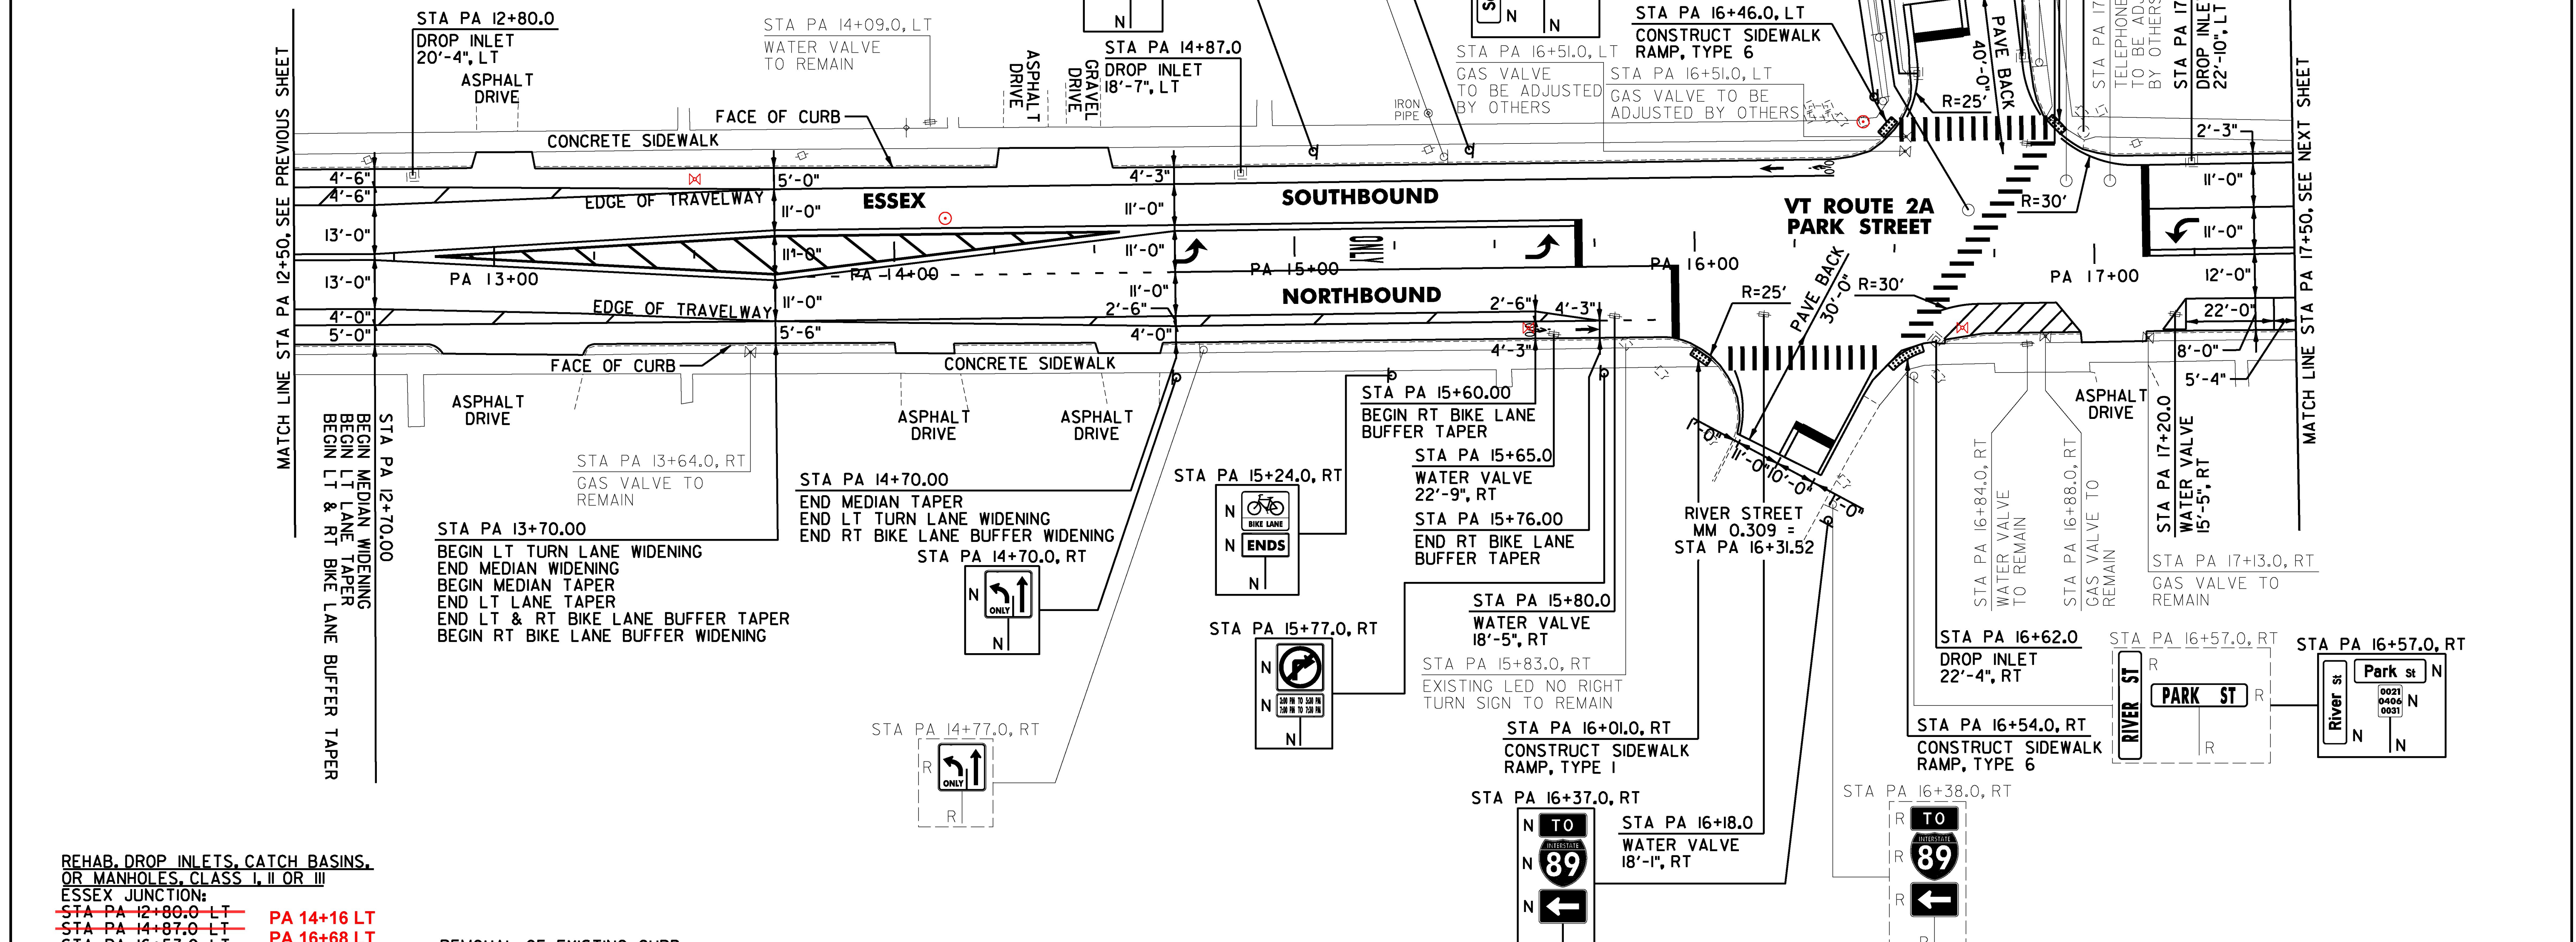

REHAB, DROP INLETS, CATCH BASINS, OR MANHOLES, CLASS I, II OR III
ESSEX JUNCTION:
~~STA PA 12+80.0 LT PA 14+16 LT~~
~~STA PA 14+87.0 LT PA 16+68 LT~~
~~STA PA 16+53.0 LT~~
~~STA PA 16+62.0 RT~~
~~STA PA 16+81.0 LT~~
~~STA PA 16+98.0 LT~~
~~STA PA 17+25.0 LT~~

REMOVAL OF EXISTING CURB
ESSEX JUNCTION:
 STA PA 16+01.0 RT
 STA PA 16+46.0 LT
 STA PA 16+54.0 RT
 STA PA 16+91.0 LT

CHANGING ELEVATION OF SEWER MANHOLES
ESSEX JUNCTION:
~~PA 12+80 LT PA 16+46 LT PA 16+98 LT~~
~~PA 14+87 LT PA 16+81 LT PA 17+25 LT~~

PORTLAND CEMENT CONCRETE SIDEWALK, 5 INCH
ESSEX JUNCTION:
 STA PA 16+01.0 RT
 STA PA 16+46.0 LT
 STA PA 16+54.0 RT
 STA PA 16+91.0 LT

ADJUST ELEVATION OF VALVE BOX
ESSEX JUNCTION:
 STA PA 15+65.0 RT PA 13+50 LT
 STA PA 15+80.0 RT PA 15+60 RT
 STA PA 16+18.0 RT PA 16+67 RT
 STA PA 16+83.0 LT
 STA PA 17+20.0 RT

DETECTABLE WARNING SURFACE
ESSEX JUNCTION:
 STA PA 16+01.0 RT
 STA PA 16+46.0 LT
 STA PA 16+54.0 RT
 STA PA 16+91.0 LT

SIGN LEGEND
 R = REMOVE
 S = SALVAGE
 N = NEW
 RET = RETAIN
 B-B = BACK TO BACK
 EXISTING =
 NEW =
 R = RETURN TO VILLAGE OF ESSEX JUNCTION

NOT TO SCALE
CHA

NOTE:
 I. SEE SHEET 62 FOR TRAFFIC SIGNAL PLAN SHEET.

PROJECT NAME: ESSEX JUNCTION	
PROJECT NUMBER: STP 2956(I)	
FILE NAME: z14v25lbr.dgn	PLOT DATE: 4/19/2016
PROJECT LEADER: D.GOZALKOWSKI	DRAWN BY: A. KIRBY
DESIGNED BY: J. OLSEN	CHECKED BY: J. SHIELDS
PLAN SHEET 4	SHEET 31 OF 171