

4 INCH WHITE LINE, LOW VOC CHLORINATED RUBBER PAINT AND TEMPORARY 4 INCH WHITE LINE, PAINT

(ALL LINES WILL INCLUDE EDGE LINE BREAKS AND RADIUS FOR TOWN HIGHWAYS)

ESSEX JUNCTION:
 STA PA 17+50.00 - STA PA 17+72.00 RT PARKING SPACES
 STA PA 17+50.00 - STA PA 18+38.00 SOLID LANE LINE LT
 STA PA 17+50.00 - STA PA 20+50.00 EDGE LINE LT
 STA PA 17+93.00 - STA PA 18+44.00 RT, NO PARKING EDGE LINE
 STA PA 18+38.00 - STA PA 19+38.00 DOTTED LANE LINE LT
 STA PA 18+53.28 EDGE LINES RT, SILVERBOW TERRACE
 STA PA 18+70.00 - STA PA 19+09.00 RT, NO PARKING EDGE LINE
 STA PA 19+23.00 - STA PA 19+73.00 RT PARKING SPACES
 STA PA 19+89.00 - STA PA 20+59.00 RT PARKING SPACES
 STA PA 20+67.00 - STA PA 20+99.00 LT PARKING SPACES
 STA PA 20+75.00 - STA PA 20+91.00 RT NO PARKING EDGE LINE
 STA PA 21+08.00 - STA PA 21+63.00 RT PARKING SPACES
 STA PA 21+16.00 - STA PA 21+68.00 LT PARKING SPACES
 STA PA 21+81.00 - STA PA 22+41.00 RT PARKING SPACES
 STA PA 21+86.00 - STA PA 22+48.00 LT PARKING SPACES

4 INCH YELLOW LINE, LOW VOC CHLORINATED RUBBER PAINT AND TEMPORARY 4 INCH YELLOW LINE, PAINT

(ALL LINES WILL INCLUDE C/L LINE BREAKS FOR TOWN HIGHWAYS)

S = SOLID, D = DASHED
 ESSEX JUNCTION: LT & RT
 STA PA 17+50.00 - STA PA 18+38.00 S - S
 STA PA 20+63.00 - STA PA 22+50.00 S - S
 STA PA 18+81.00 - STA PA 20+63.00 DOUBLE SOLID MEDIAN LT & C/L
 STA PA 18+53.28 DOUBLE SOLID RT, SILVERBOW TERRACE

8 INCH WHITE LINE, LOW VOC CHLORINATED RUBBER PAINT

ESSEX JUNCTION:
 STA PA 17+93.00 - STA PA 18+44.00 RT, NO PARKING
 STA PA 18+70.00 - STA PA 19+09.00 RT, NO PARKING
 STA PA 19+60.00 - STA PA 20+50.00 LT, NO PARKING
 STA PA 20+75.00 - STA PA 20+91.00 RT, NO PARKING

TEMPORARY LETTER OR SYMBOL, PAINT

ESSEX JUNCTION:
 STA PA 18+34.00 LT, ARROW (2 EA)

LETTER OR SYMBOL, LOW VOC CHLORINATED RUBBER PAINT

ESSEX JUNCTION:
 STA PA 17+78.00 LT, "O,N,L,Y" (4 EA)
 STA PA 18+34.00 LT, ARROW (1 EA)

CROSSWALK MARKING, LOW VOC CHLORINATED RUBBER PAINT AND TEMPORARY CROSSWALK MARKING, PAINT

ESSEX JUNCTION:
 STA PA 18+53.28 RT, SILVERBOW TERRACE

8 INCH YELLOW LINE, LOW VOC CHLORINATED RUBBER PAINT



ESSEX JUNCTION:
 STA PA 18+81.00 - STA PA 20+63.00 HATCHED MEDIAN LT

24 INCH STOP BAR, LOW VOC CHLORINATED RUBBER PAINT AND TEMPORARY 24 INCH STOP BAR, PAINT

ESSEX JUNCTION:
 STA PA 18+53.28 RT, SILVERBOW TERRACE

ERECTING SALVAGED SIGNS
 AS SHOWN - 1

REMOVING SIGNS
 AS SHOWN - 9

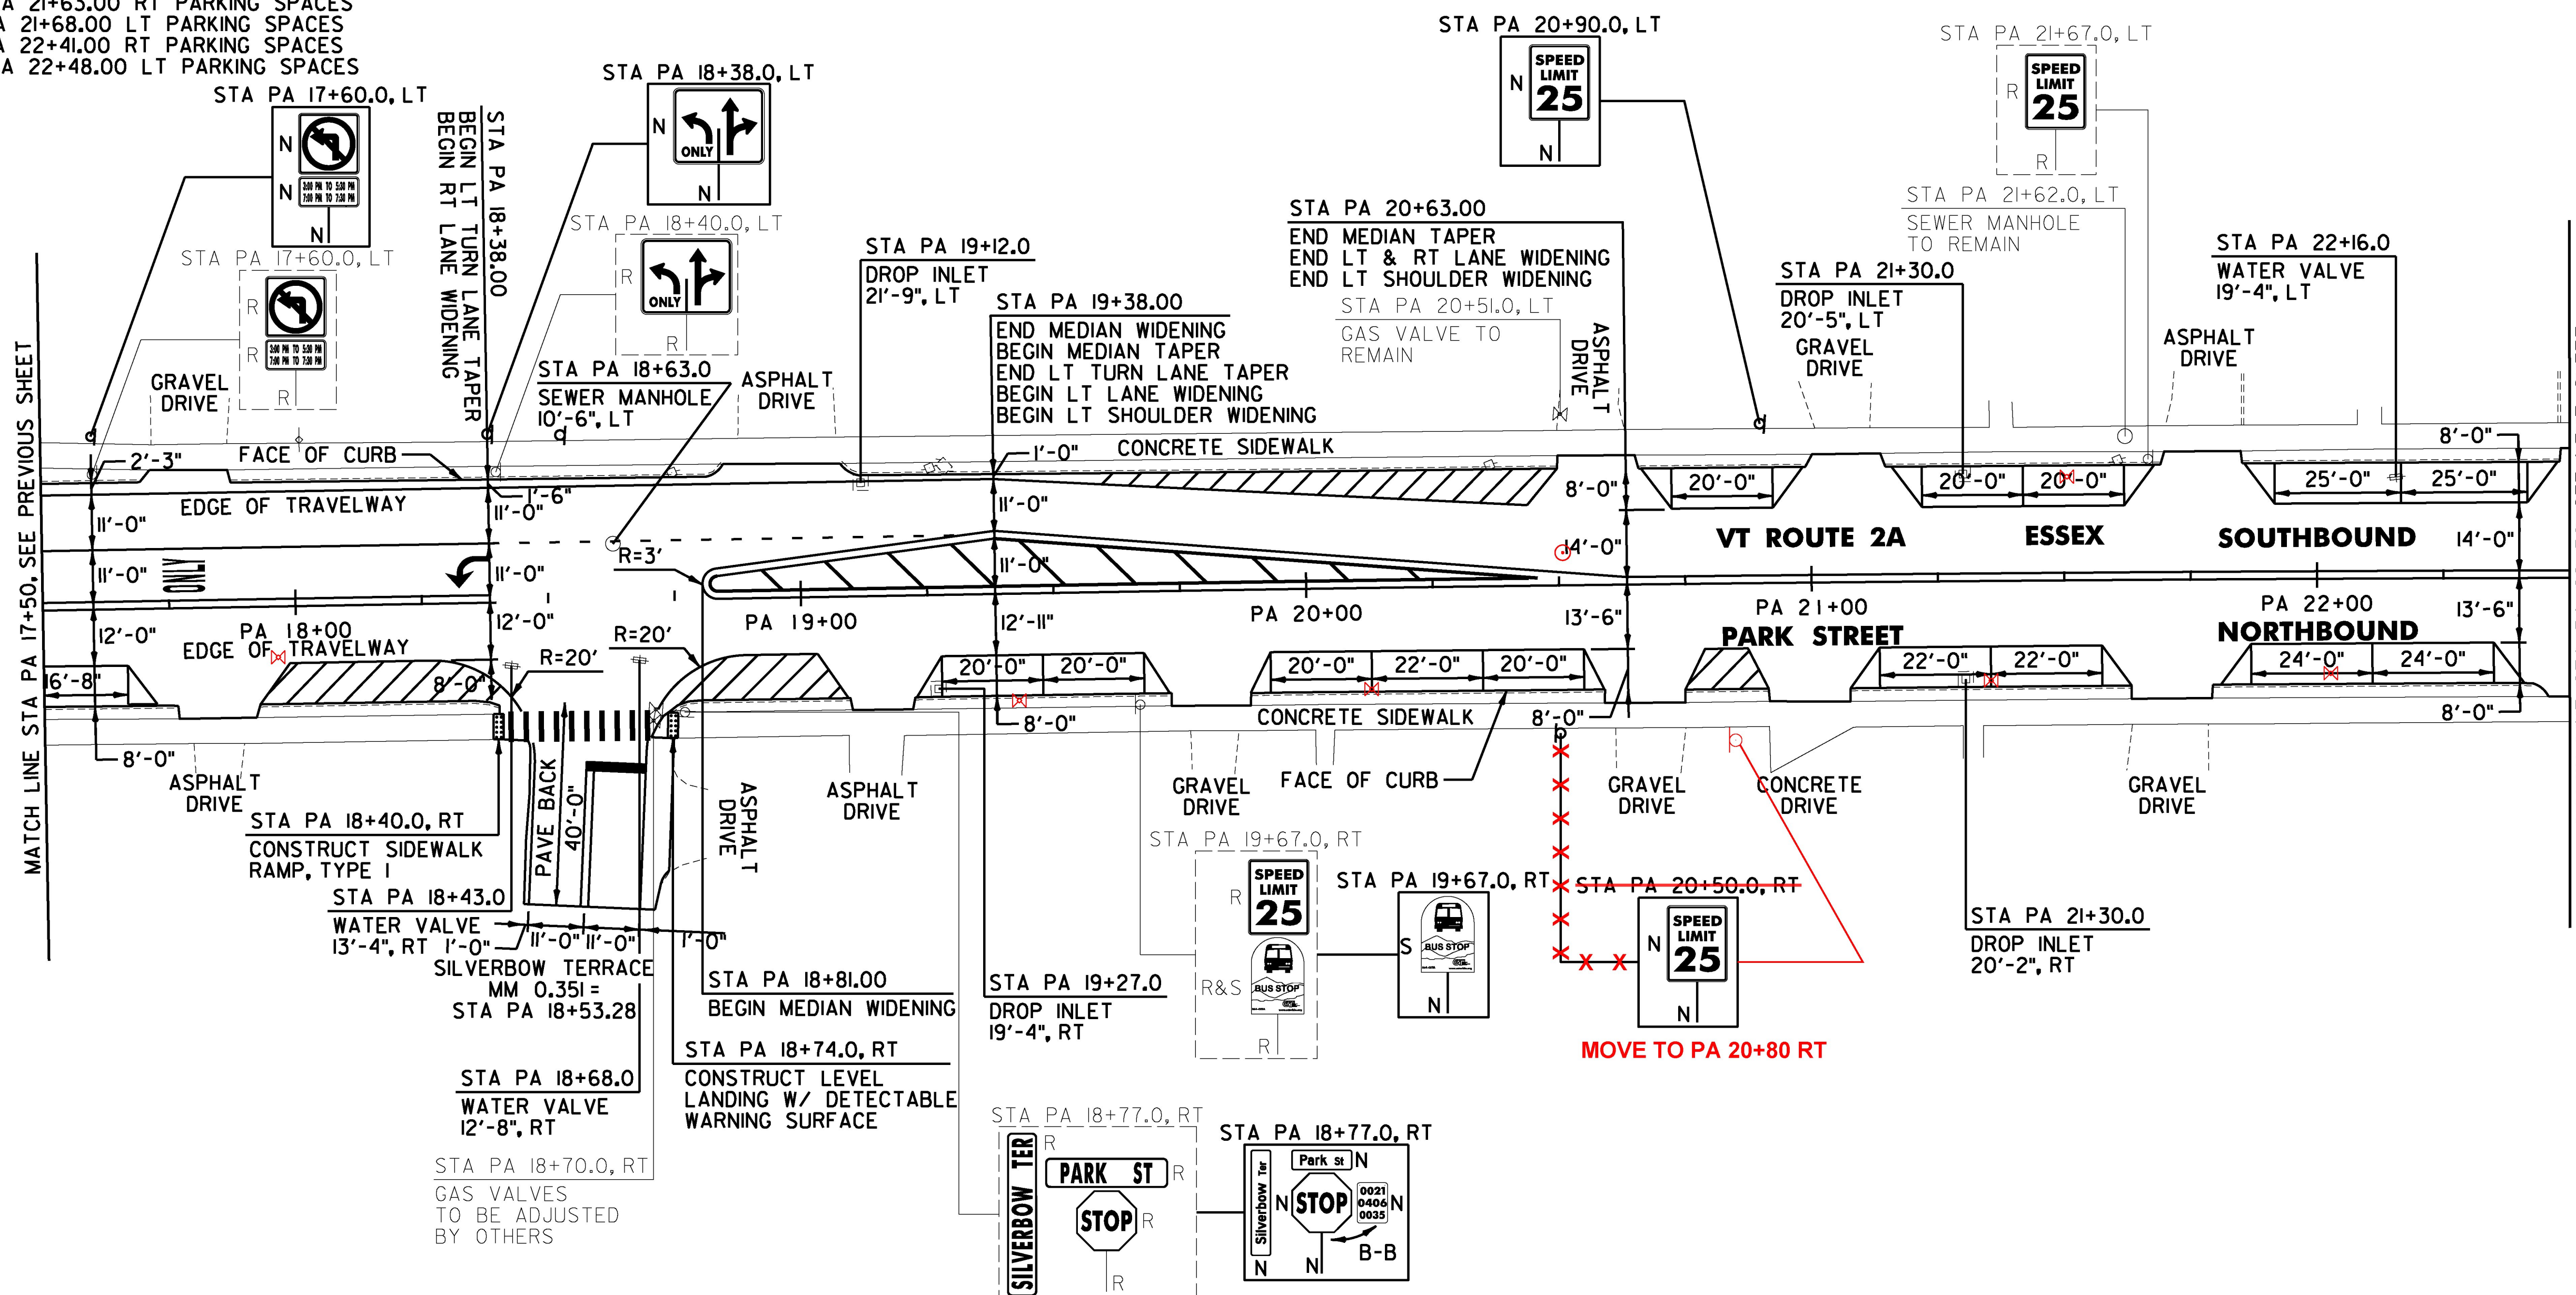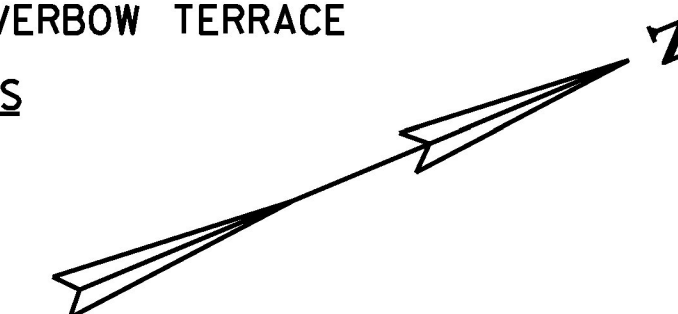

CAST-IN-PLACE CONCRETE CURB, TYPE B

ESSEX JUNCTION:
 STA PA 18+40.0 RT
 STA PA 18+74.0 RT

REHAB. DROP INLETS, CATCH BASINS, OR MANHOLES, CLASS I, II OR III

ESSEX JUNCTION:
~~STA PA 19+12.0 LT - PA 20+50 LT~~
~~STA PA 19+27.0 RT~~
~~STA PA 21+30.0 LT~~
~~STA PA 21+30.0 RT~~

CHANGING ELEVATION OF SEWER MANHOLE

ESSEX JUNCTION: PA 19+12 LT PA 21+30 RT
 STA PA 18+63.0 LT PA 19+27 RT

REMOVAL OF EXISTING CURB

ESSEX JUNCTION:
 STA PA 18+40.0 RT
 STA PA 18+74.0 RT

ADJUST ELEVATION OF VALVE BOX

ESSEX JUNCTION: PA 17+90 RT
 STA PA 18+43.0 RT PA 20+19 RT
 STA PA 18+68.0 RT PA 21+36 RT
 STA PA 22+16.0 LT PA 21+50 RT
 PA 22+05 RT

DETECTABLE WARNING SURFACE

ESSEX JUNCTION:
 STA PA 18+40.0 RT
 STA PA 18+74.0 RT

PORTLAND CEMENT CONCRETE SIDEWALK, 5 INCH

ESSEX JUNCTION:
 STA PA 18+40.0 RT
 STA PA 18+74.0 RT

SIGN LEGEND

R = REMOVE
 S = SALVAGE
 N = NEW
 RET = RETAIN
 B-B = BACK TO BACK
 EXISTING = EXISTING
 NEW = NEW
 R = RETURN TO VILLAGE OF ESSEX JUNCTION

NOT TO SCALE



PROJECT NAME: ESSEX JUNCTION

PROJECT NUMBER: STP 2956(I)

FILE NAME: z14v25lbd.dgn

PROJECT LEADER: D.GOZALKOWSKI

DESIGNED BY: J. OLSEN

PLAN SHEET 5

PLOT DATE: 4/19/2016

DRAWN BY: A. KIRBY

CHECKED BY: J. SHIELDS

SHEET 32 OF 171