

4 INCH WHITE LINE, LOW VOC CHLORINATED RUBBER PAINT AND TEMPORARY 4 INCH WHITE LINE, PAINT

(ALL LINES WILL INCLUDE EDGE LINE BREAKS AND RADIUS FOR TOWN HIGHWAYS)

ESSEX JUNCTION:

- STA L 37+00.00 - STA L 39+25.00 EDGE LINE LT & RT
- STA L 37+00.00 - STA L 37+50.00 SOLID LANE LINE LT
- STA L 37+47.00 - STA L 37+58.00 EDGE LINE RT, JUG HANDLE
- STA L 37+50.00 - STA L 37+93.00 DO NOT BLOCK INTERSECTION CROSS HATCH LT & RT
- STA L 37+93.00 - STA L 38+90.00 SOLID LANE LINE LT
- STA L 38+90.00 - STA L 39+25.00 DOTTED LANE LINE LT
- STA MN 117+25.00 - STA MN 117+74.00 SOLID LANE LINE LT
- STA MN 117+25.00 - STA MN 117+50.00 EDGE LINE RT
- STA MN 117+25.00 - STA MN 118+43.00 EDGE LINE LT
- STA MN 117+45.00 - STA MN 118+33.00 PARKING SPACES RT
- STA MN 118+33.00 - STA MN 118+45.00 EDGE LINE RT
- STA MN 118+36.00 - STA MN 118+50.00 PARKING SPACES LT

4 INCH YELLOW LINE, LOW VOC CHLORINATED RUBBER PAINT AND TEMPORARY 4 INCH YELLOW LINE, PAINT

(ALL LINES WILL INCLUDE C/L LINE BREAKS FOR TOWN HIGHWAYS)

S = SOLID, D = DASHED

- ESSEX JUNCTION:
- STA L 37+00.00 - STA L 39+25.00 S - S
 - STA MN 117+25.00 - STA MN 118+50.00 S - S
 - STA L 37+32.00 - STA L 37+52.00 EDGE LINE RT, JUG HANDLE S - S

8 INCH WHITE LINE, LOW VOC CHLORINATED RUBBER PAINT

ESSEX JUNCTION:

- STA L 37+50.00 - STA L 37+93.00 LT/RT DO NOT BLOCK INTERSECTION
- STA MN 118+33.00 - STA MN 118+45.00 RT, FIRE HYDRANT, NO PARKING

LETTER OR SYMBOL, LOW VOC CHLORINATED RUBBER PAINT

ESSEX JUNCTION:

- STA L 37+39.00 C/L, "O,N,L,Y" (4 EA)
- STA L 37+39.00 LT, ARROWS (2 EA)
- STA L 38+03.00 C/L, ARROW (1 EA)
- STA L 38+03.00 LT, ARROWS (2 EA)
- STA L 38+43.50 C/L, "O,N,L,Y" (4 EA)
- STA L 38+83.00 C/L, ARROW (1 EA)
- STA L 38+83.00 LT, ARROWS (2 EA)
- STA MN 117+70.00 LT, ARROW (1 EA)
- STA MN 117+70.00 LT, ARROW (1 EA)

TEMPORARY LETTER OR SYMBOL, PAINT

ESSEX JUNCTION:

- STA L 37+39.00 LT, ARROWS (4 EA)
- STA L 38+03.00 C/L, ARROW (2 EA)
- STA L 38+03.00 LT, ARROWS (4 EA)
- STA L 38+83.00 C/L, ARROW (2 EA)
- STA L 38+83.00 LT, ARROWS (4 EA)
- STA MN 117+70.00 LT, ARROW (2 EA)
- STA MN 117+70.00 LT, ARROW (2 EA)



CROSSWALK MARKING, LOW VOC CHLORINATED RUBBER PAINT AND TEMPORARY CROSSWALK MARKING, PAINT

ESSEX JUNCTION:

STA L 37+41.00 RT JUG HANDLE

REMOVING SIGNS AS SHOWN - 15

SETTING SALVAGED POSTS AS SHOWN - 1

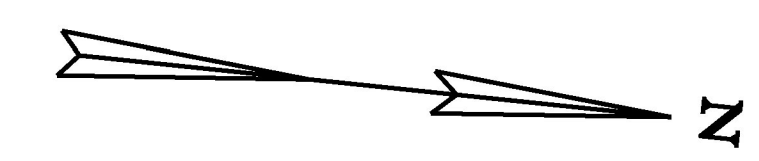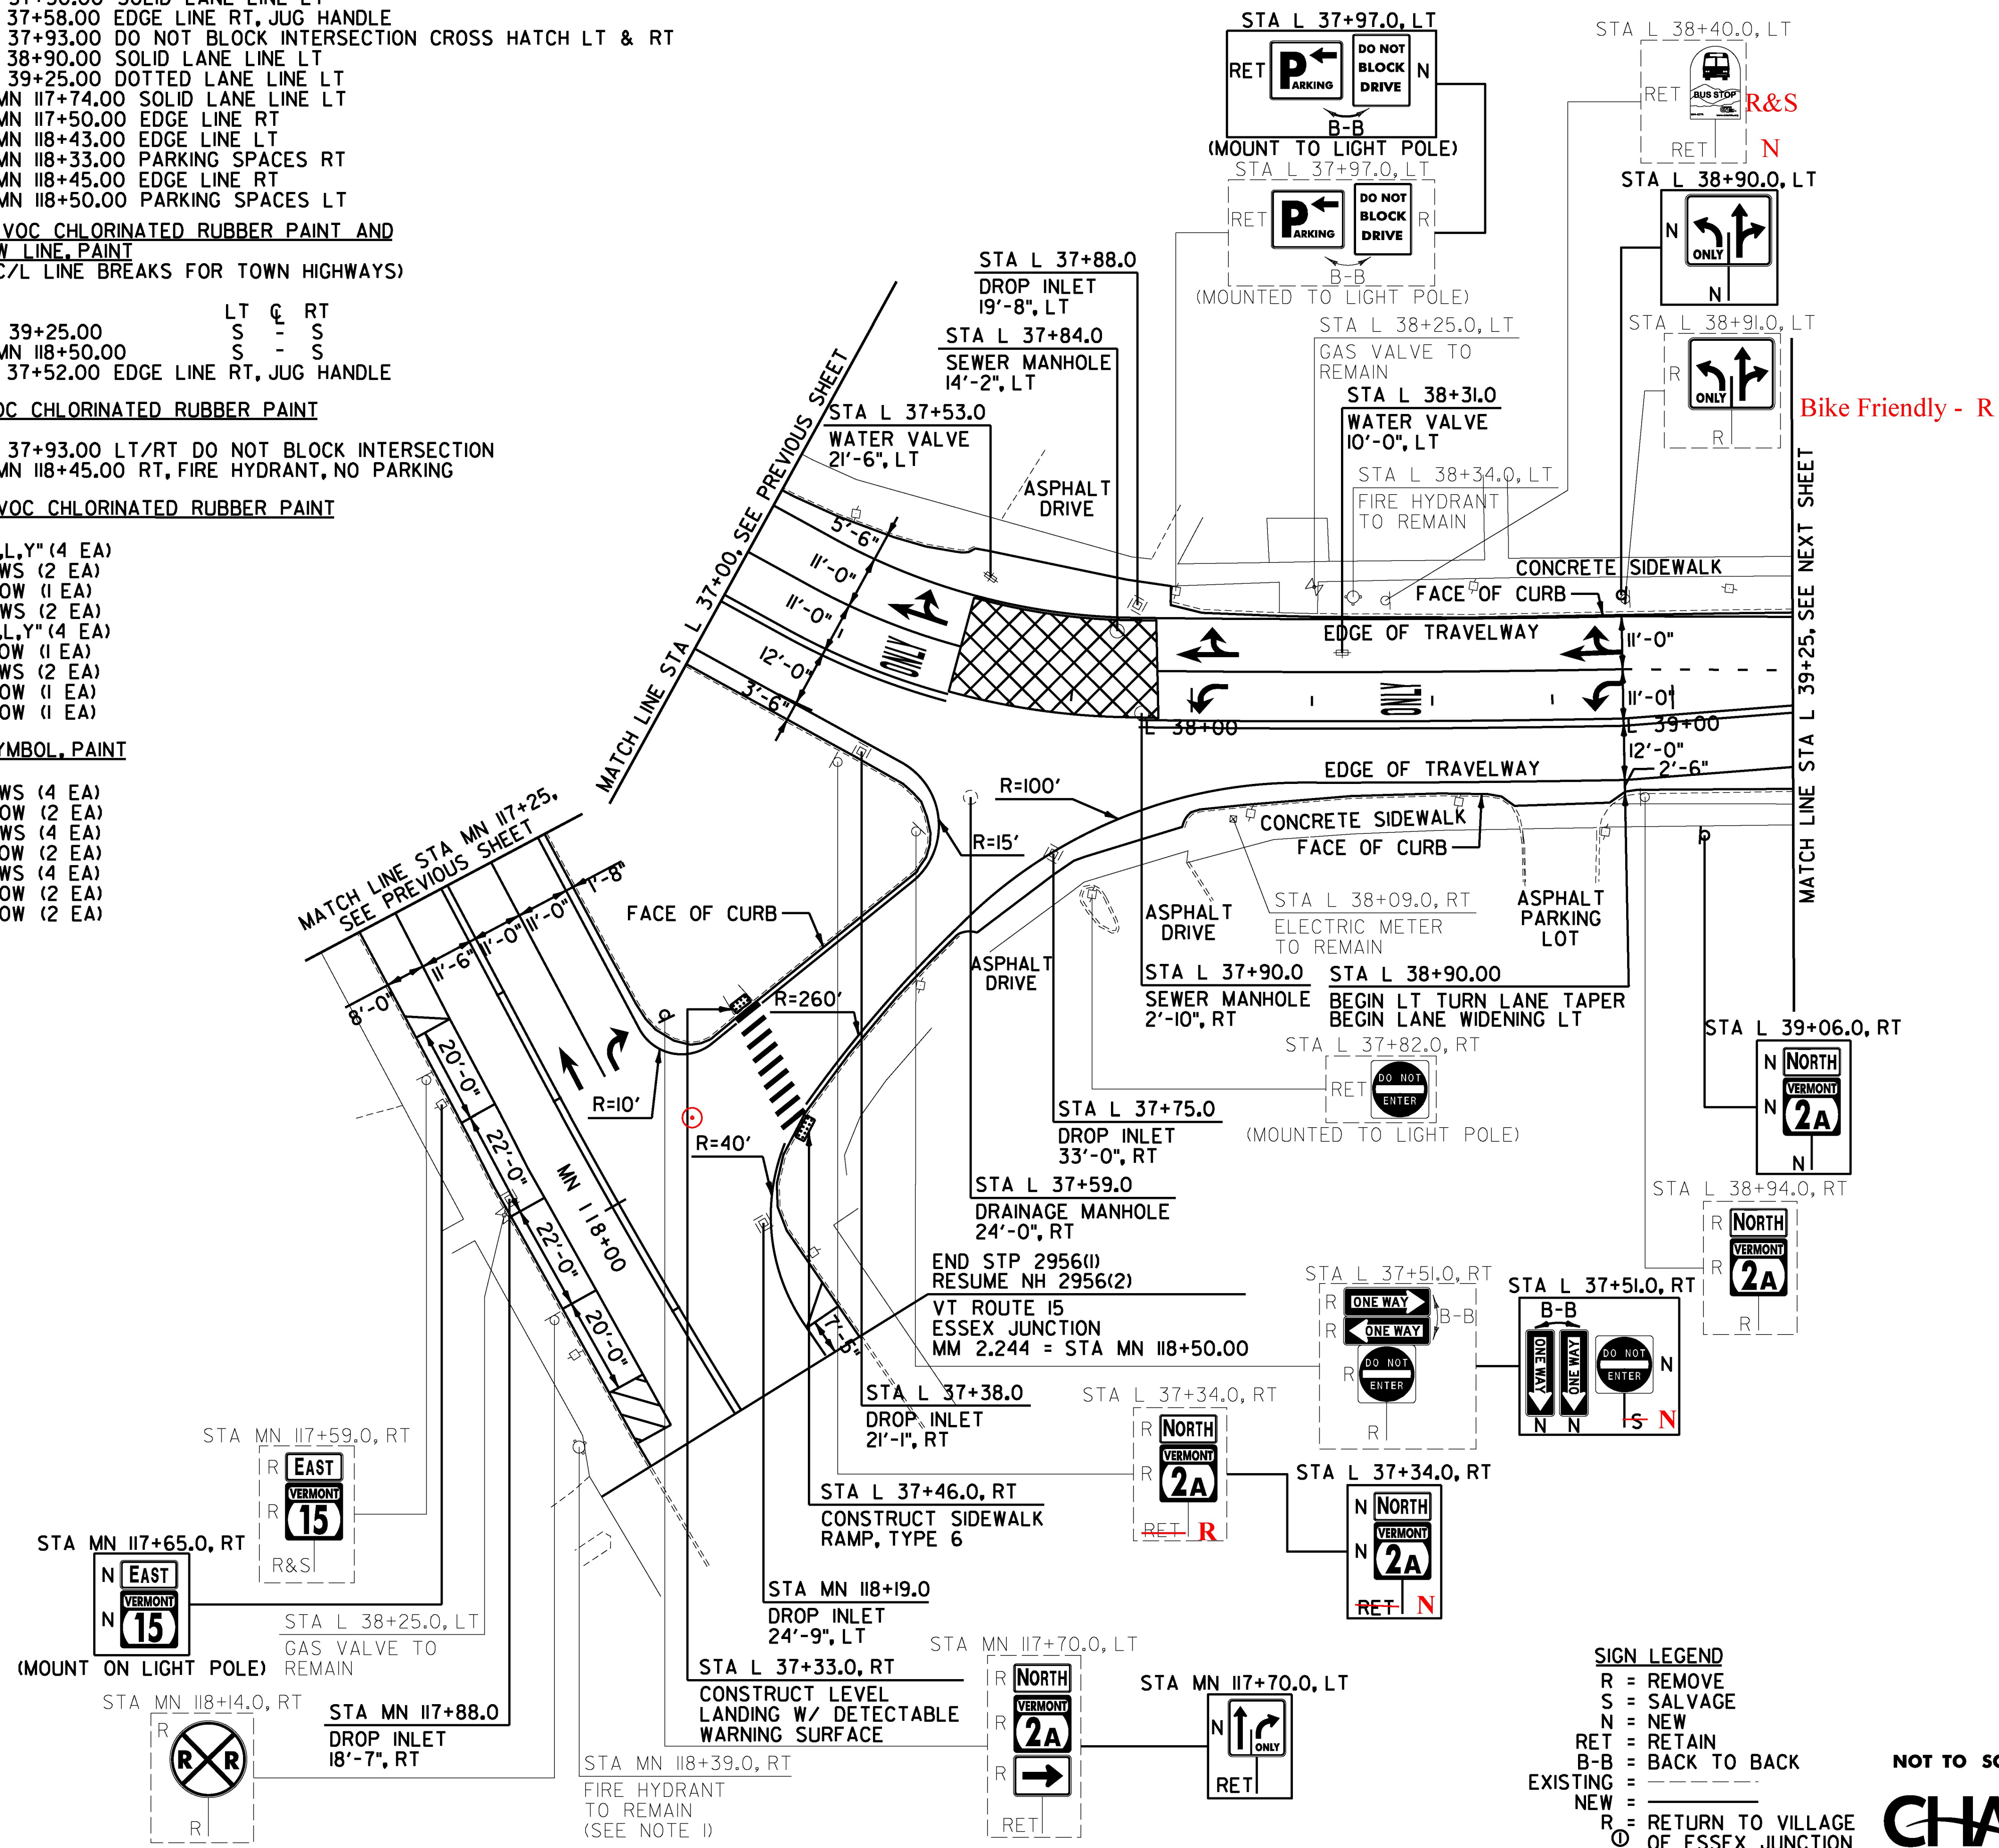

REHAB. DROP INLETS, CATCH BASINS, OR MANHOLES, CLASS I, II, OR III

- ESSEX JUNCTION:
- STA L 37+38.0 RT
 - ~~STA L 37+59.0 RT~~ L 37+84 LT
 - ~~STA L 37+75.0 RT~~
 - ~~STA L 37+88.0 LT~~
 - STA MN 117+88.0 RT
 - STA MN 118+19.0 LT

CHANGING ELEVATION OF SEWER MANHOLES

- ESSEX JUNCTION:
- L 37+59 RT
 - ~~STA L 37+84.0 LT~~ L 37+75 RT
 - STA L 37+90.0 RT L 37+88 LT
 - MN 117+90 LT
- ADJUST ELEVATION OF VALVE BOX
- ESSEX JUNCTION:
- ~~STA L 37+53.0 LT~~
 - ~~STA L 38+31.0 LT~~

DETECTABLE WARNING SURFACE

- ESSEX JUNCTION:
- STA L 37+33.0 RT
 - STA L 37+46.0 RT

PORTLAND CEMENT CONCRETE SIDEWALK, 5 INCH

- ESSEX JUNCTION:
- STA L 37+33.0 RT
 - STA L 37+46.0 RT

REMOVAL OF EXISTING CURB

- ESSEX JUNCTION:
- ~~STA L 37+33.0 RT~~
 - ~~STA L 37+46.0 RT~~

CAST-IN-PLACE CONCRETE CURB, TYPE B

- ESSEX JUNCTION:
- ~~STA L 37+33.0 RT~~
 - ~~STA L 37+46.0 RT~~

NOTE:

I. SEE SHEET 10 FOR FIRE HYDRANT PAVEMENT MARKING DETAIL.

PROJECT NAME: ESSEX JUNCTION

PROJECT NUMBER: STP 2956(I)

FILE NAME: z14v251bdr.dgn

PROJECT LEADER: D.GOZALKOWSKI

DESIGNED BY: J. OLSEN

PLAN SHEET 9

PLOT DATE: 4/19/2016

DRAWN BY: A. KIRBY

CHECKED BY: J. SHIELDS

SHEET 36 OF 171

- SIGN LEGEND
- R = REMOVE
 - S = SALVAGE
 - N = NEW
 - RET = RETAIN
 - B-B = BACK TO BACK
 - EXISTING = _____
 - NEW = _____
 - R = RETURN TO VILLAGE OF ESSEX JUNCTION

NOT TO SCALE

