

CROSSWALK MARKING, LOW VOC CHLORINATED RUBBER PAINT AND TEMPORARY CROSSWALK MARKING, PAINT

ESSEX JUNCTION:  
 STA L 40+44.00 LT/RT  
 STA L 40+60.32 RT, LINCOLN PLACE

8 INCH WHITE LINE, LOW VOC CHLORINATED RUBBER PAINT  
 ESSEX JUNCTION:  
 STA L 42+28.00 - STA L 42+40.00 RT, FIRE HYDRANT, NO PARKING

4 INCH YELLOW LINE, LOW VOC CHLORINATED RUBBER PAINT AND TEMPORARY 4 INCH YELLOW LINE, PAINT

(ALL LINES WILL INCLUDE C/L LINE BREAKS FOR TOWN HIGHWAYS)  
 S = SOLID, D = DASHED  
 ESSEX JUNCTION:  
 STA L 40+15.00 - STA L 42+50.00 LT @ RT  
 STA L 39+25.00 - STA L 40+15.00 DOUBLE SOLID RT

24 INCH STOP BAR, LOW VOC CHLORINATED RUBBER PAINT  
 L 40+60 RT

TEMPORARY LETTER OR SYMBOL, PAINT

ESSEX JUNCTION:  
 STA L 42+28.00 RT, "S,C,H,O,O,L" (12 EA)

LETTER OR SYMBOL, LOW VOC CHLORINATED RUBBER PAINT



ESSEX JUNCTION:  
 STA L 42+28.00 RT, "S,C,H,O,O,L" (6 EA)

4 INCH WHITE LINE, LOW VOC CHLORINATED RUBBER PAINT AND TEMPORARY 4 INCH WHITE LINE, PAINT

(ALL LINES WILL INCLUDE EDGE LINE BREAKS AND RADIUS FOR TOWN HIGHWAYS)

ESSEX JUNCTION:  
 STA L 39+25.00 - STA L 40+39.00 EDGE LINE RT  
 STA L 39+25.00 - STA L 42+50.00 EDGE LINE LT  
 STA L 39+25.00 - STA L 40+15.00 LT DOTTED LANE LINE  
 STA L 40+84.00 - STA L 42+02.00 RT PARKING SPACES  
 STA L 41+96.00 - STA L 42+50.00 EDGE LINE RT

REMOVING SIGNS AS SHOWN - 22

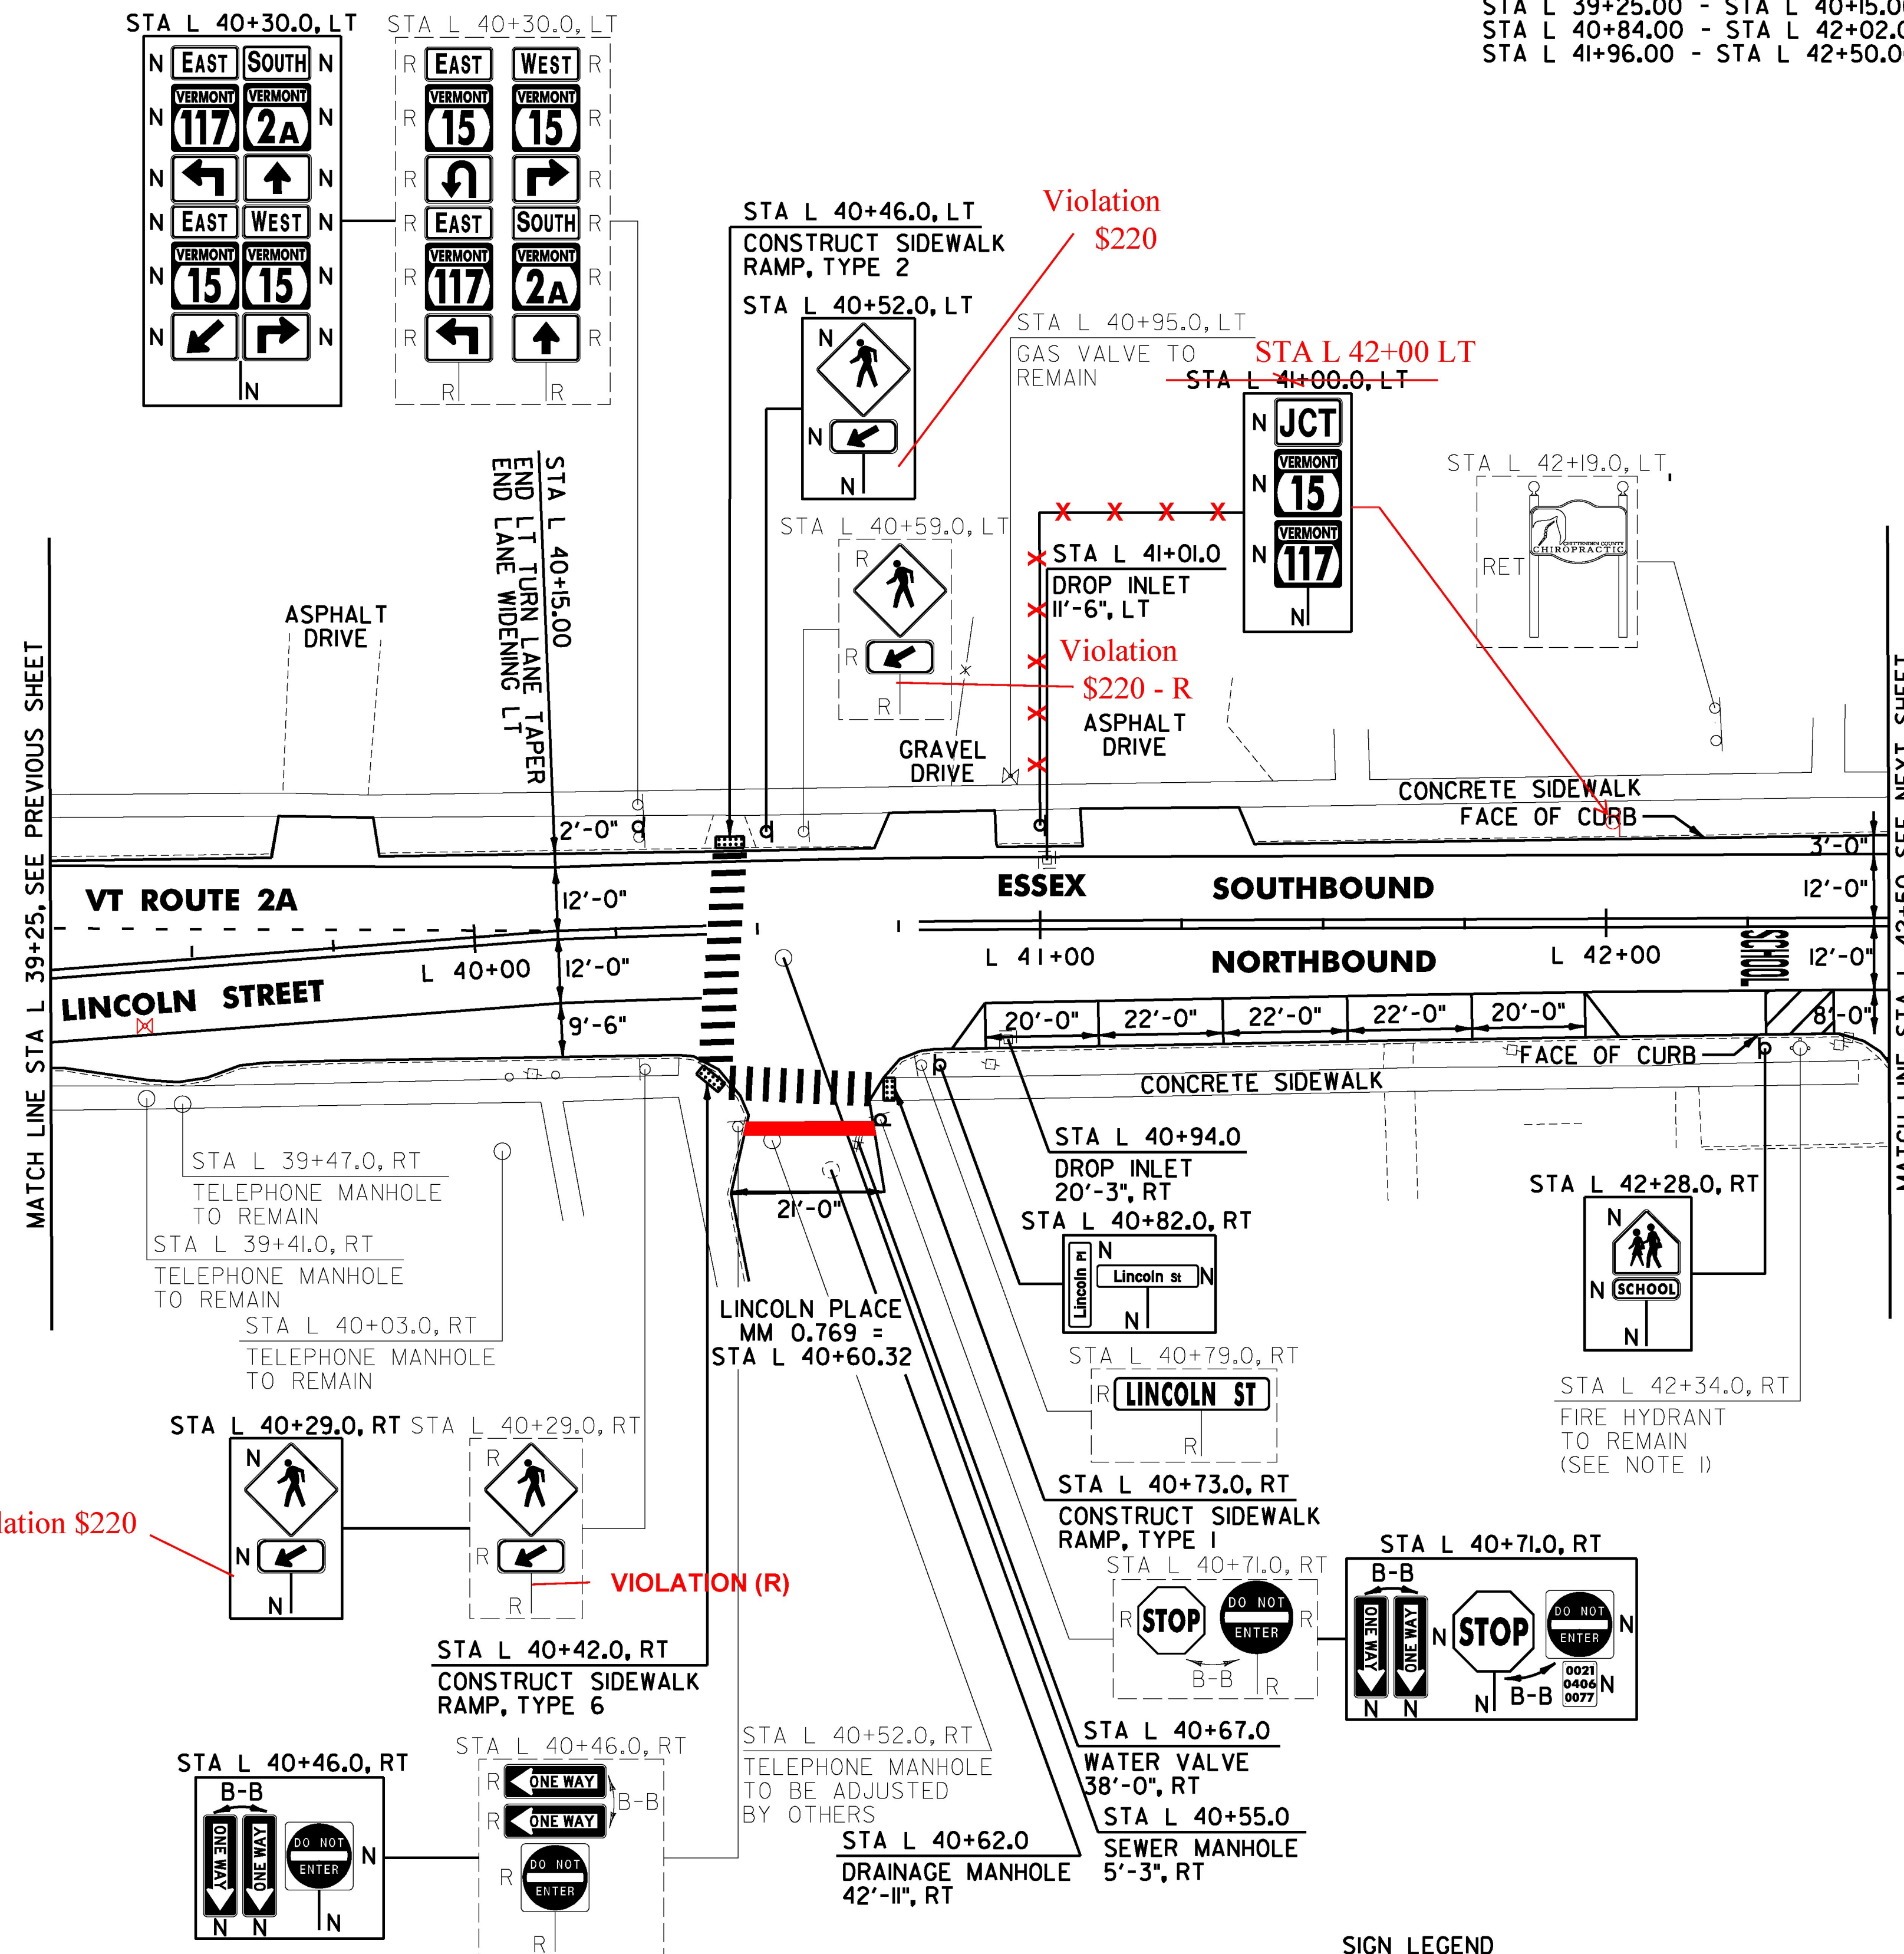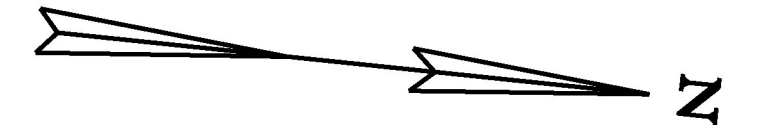

CAST-IN-PLACE CONCRETE CURB, TYPE B

ESSEX JUNCTION:  
~~STA L 40+42.0 RT~~  
~~STA L 40+46.0 LT~~  
 STA L 40+73.0 RT

PORTLAND CEMENT CONCRETE SIDEWALK, 5 INCH

ESSEX JUNCTION:  
 STA L 40+42.0 RT  
 STA L 40+46.0 LT  
 STA L 40+73.0 RT

DETECTABLE WARNING SURFACE

ESSEX JUNCTION:  
 STA L 40+42.0 RT  
 STA L 40+46.0 LT  
 STA L 40+73.0 RT

REMOVAL OF EXISTING CURB

ESSEX JUNCTION:  
~~STA L 40+42.0 RT~~  
~~STA L 40+46.0 LT~~  
 STA L 40+73.0 RT

ADJUST ELEVATION OF VALVE BOX

ESSEX JUNCTION:  
 STA L 40+67.0 RT L 39+41 RT

CHANGING ELEVATION OF SEWER MANHOLES

ESSEX JUNCTION:  
~~STA L 40+55.0 RT~~

REHAB. DROP INLETS, CATCH BASINS, OR MANHOLES, CLASS I, II OR III

ESSEX JUNCTION:  
 STA L 40+62.0 RT  
 STA L 40+94.0 RT  
 STA L 41+01.0 LT  
 L 40+55 RT

SIGN LEGEND  
 R = REMOVE  
 S = SALVAGE  
 N = NEW  
 RET = RETAIN  
 B-B = BACK TO BACK  
 EXISTING =   
 NEW =   
 R = RETURN TO VILLAGE OF ESSEX JUNCTION

NOT TO SCALE



NOTE:

1. SEE SHEET 10 FOR FIRE HYDRANT PAVEMENT MARKING DETAIL.

PROJECT NAME: ESSEX JUNCTION  
 PROJECT NUMBER: STP 2956(I)

FILE NAME: z14v251bdr.dgn  
 PROJECT LEADER: D.GOZALKOWSKI  
 DESIGNED BY: J. OLSEN  
 PLAN SHEET 10

PLOT DATE: 4/19/2016  
 DRAWN BY: A. KIRBY  
 CHECKED BY: J. SHIELDS  
 SHEET 37 OF 171