



COLD PLANE AND RESURFACING TYPICAL SECTION
 VT ROUTE 15 ESSEX JUNCTION STA PE 58+25.00 TO STA PE 84+60.00

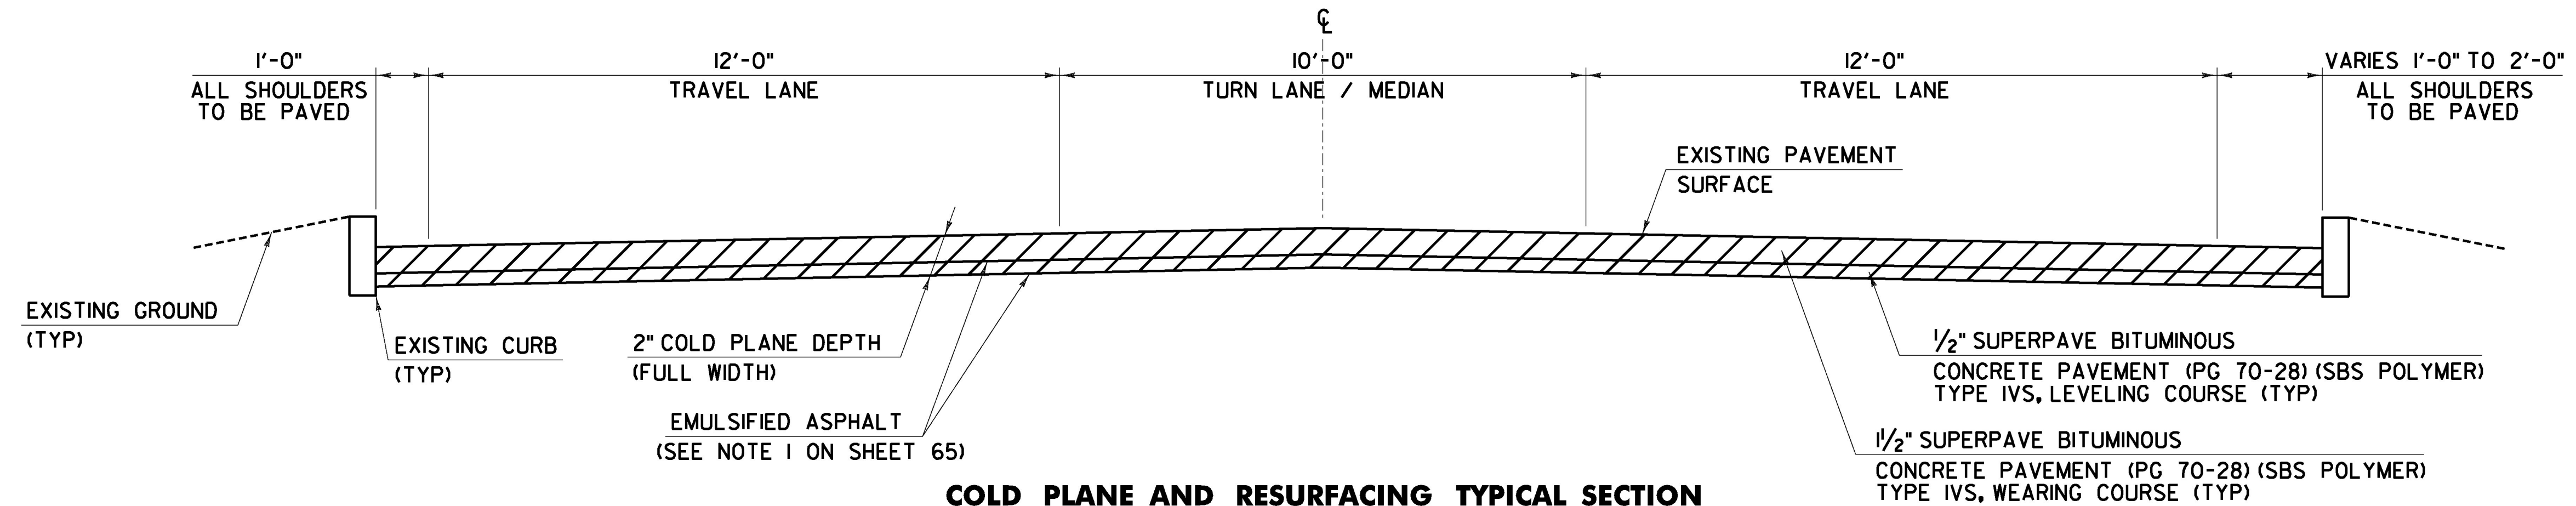

COLD PLANE AND RESURFACING TYPICAL SECTION
 VT ROUTE 15 ESSEX JUNCTION STA PE 84+60.00 TO STA PE 90+80.00

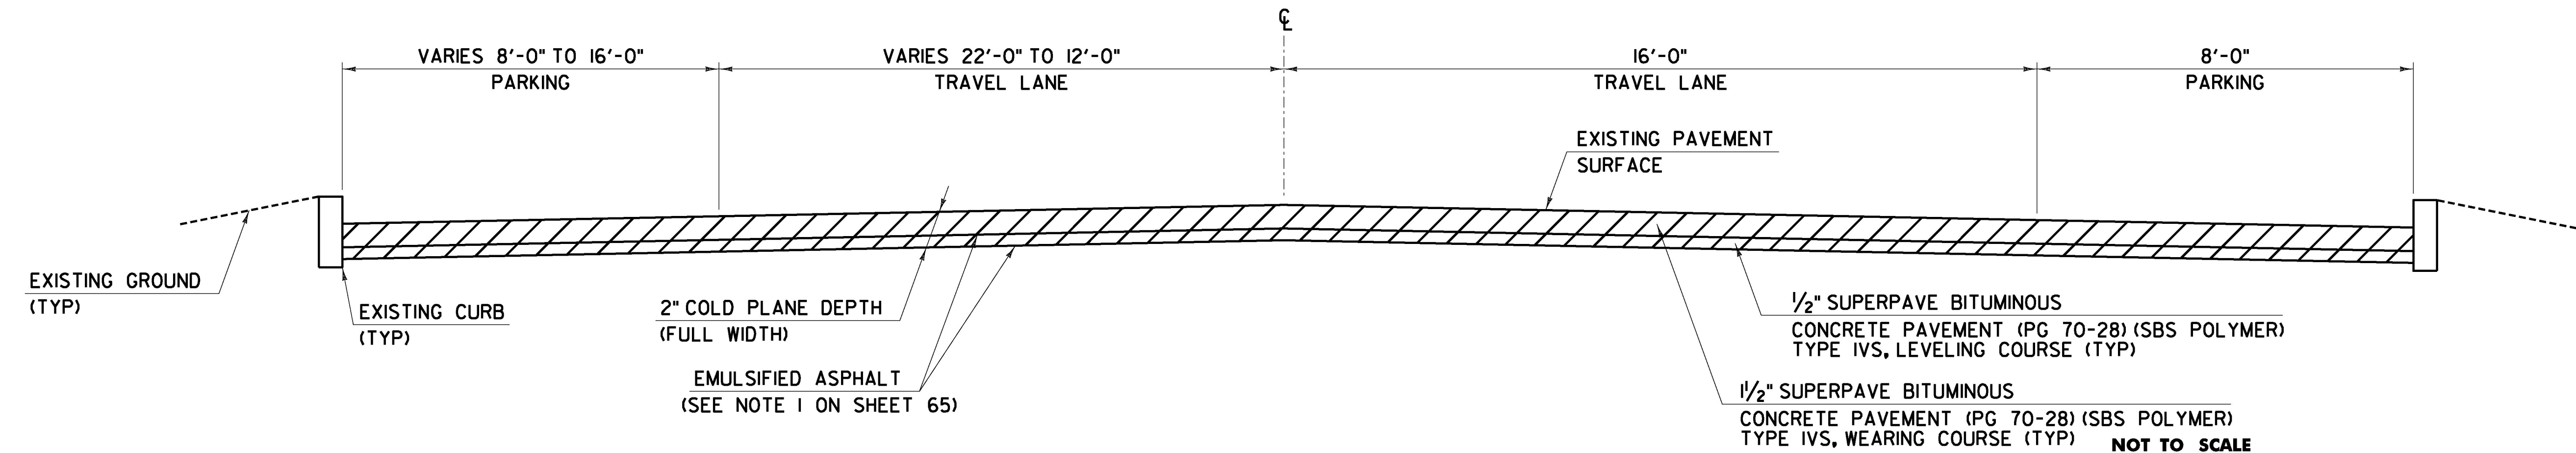

COLD PLANE AND RESURFACING TYPICAL SECTION
 VT ROUTE 15 ESSEX JUNCTION STA MN 118+50.00 TO STA MN 120+38.00

NOT TO SCALE

PROJECT NAME: ESSEX JUNCTION	PLOT DATE: 5/9/2016
PROJECT NUMBER: NH 2956(2)	DRAWN BY: C. KAHLBAUGH
FILE NAME: z15v026typ.dgn	DESIGNED BY: J. SCUDDER
PROJECT LEADER: D.GOZALKOWSKI	CHECKED BY: J. SHIELDS
TYPICAL SECTIONS SHEET 2	SHEET 67 OF 171

