



COLD PLANE AND RESURFACING TYPICAL SECTION
 VT ROUTE 15 ESSEX JUNCTION STA MN 120+38.00 TO STA MN 121+19.21.00

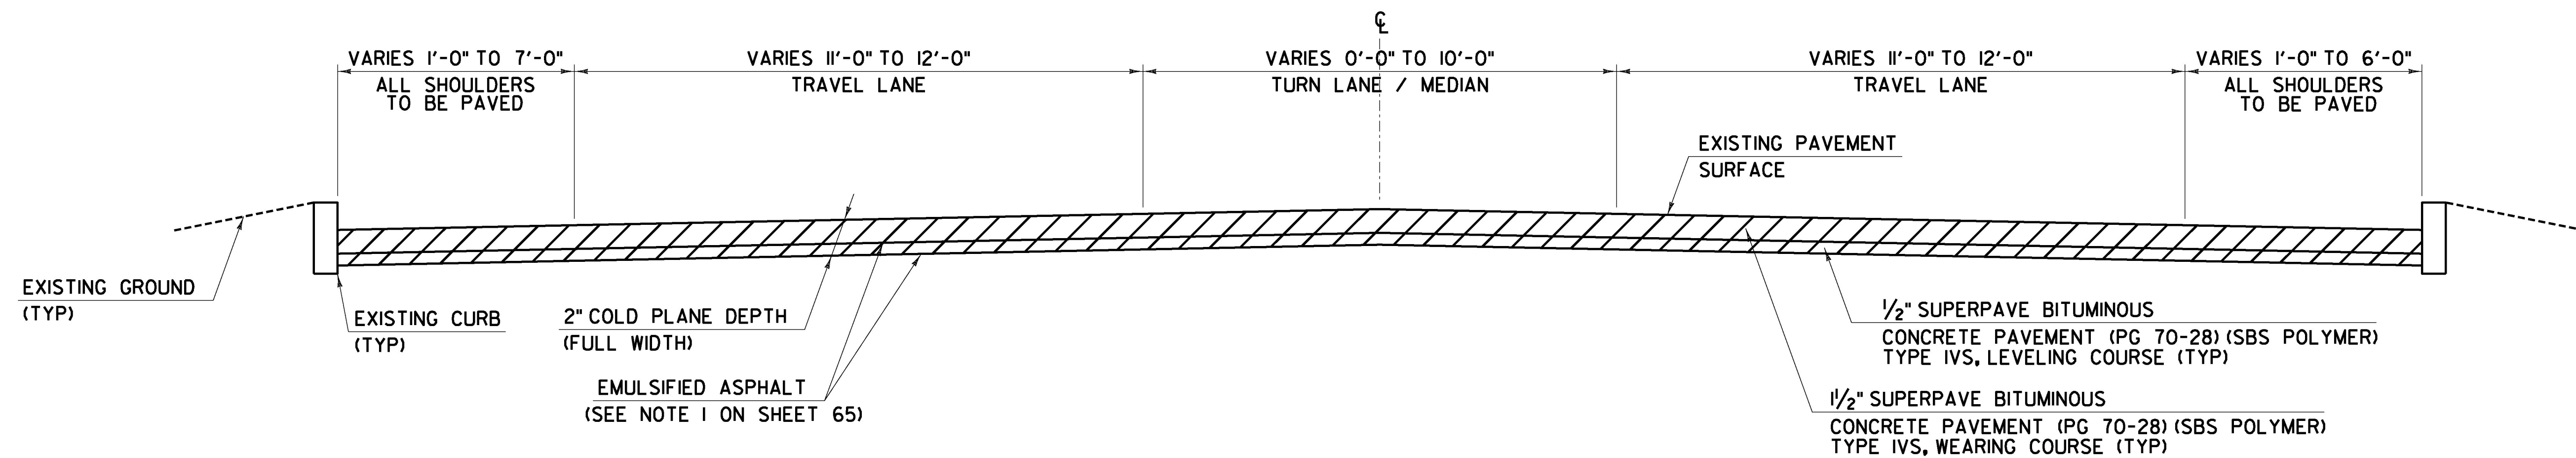

COLD PLANE AND RESURFACING TYPICAL SECTION
 VT ROUTE 15 ESSEX JUNCTION STA MN 121+31.32 TO STA MN 123+00.00
 VT ROUTE 15 ESSEX JUNCTION STA MN 123+00.00 TO STA MN 125+00.00
 VT ROUTE 15 ESSEX JUNCTION STA MN 131+06.00 TO STA MN 135+90.00

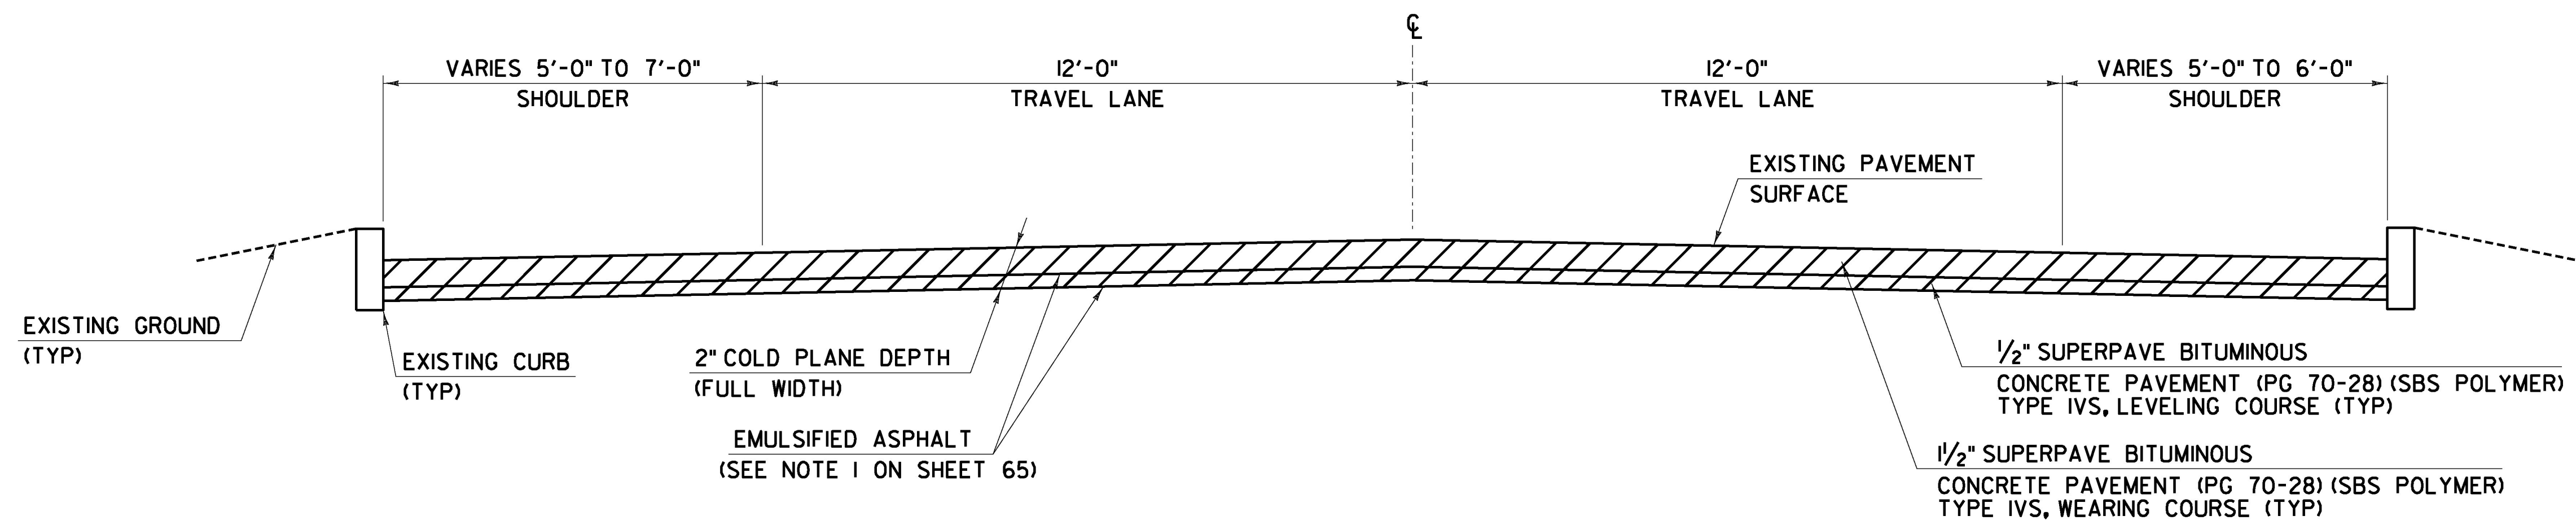

COLD PLANE AND RESURFACING TYPICAL SECTION
 VT ROUTE 15 ESSEX JUNCTION STA MN 125+00.00 TO STA MN 131+06.00
 VT ROUTE 15 ESSEX JUNCTION STA MN 135+90.00 TO STA MN 137+40.00
 VT ROUTE 15 ESSEX JUNCTION STA MN 137+60.00 TO STA MN 137+72.00

NOT TO SCALE	
PROJECT NAME:	ESSEX JUNCTION
PROJECT NUMBER:	NH 2956(2)
FILE NAME:	z15v026typ.dgn
PROJECT LEADER:	D.GOZALKOWSKI
DESIGNED BY:	J. SCUDDER
TYPICAL SECTIONS SHEET 3	
PLOT DATE:	5/9/2016
DRAWN BY:	C. KAHLBAUGH
CHECKED BY:	J. SHIELDS
SHEET	68 OF 171

