



COLD PLANE AND RESURFACING TYPICAL SECTION
 VT ROUTE 15 ESSEX JUNCTION STA MN 137+72.00 TO STA MN 140+00.00

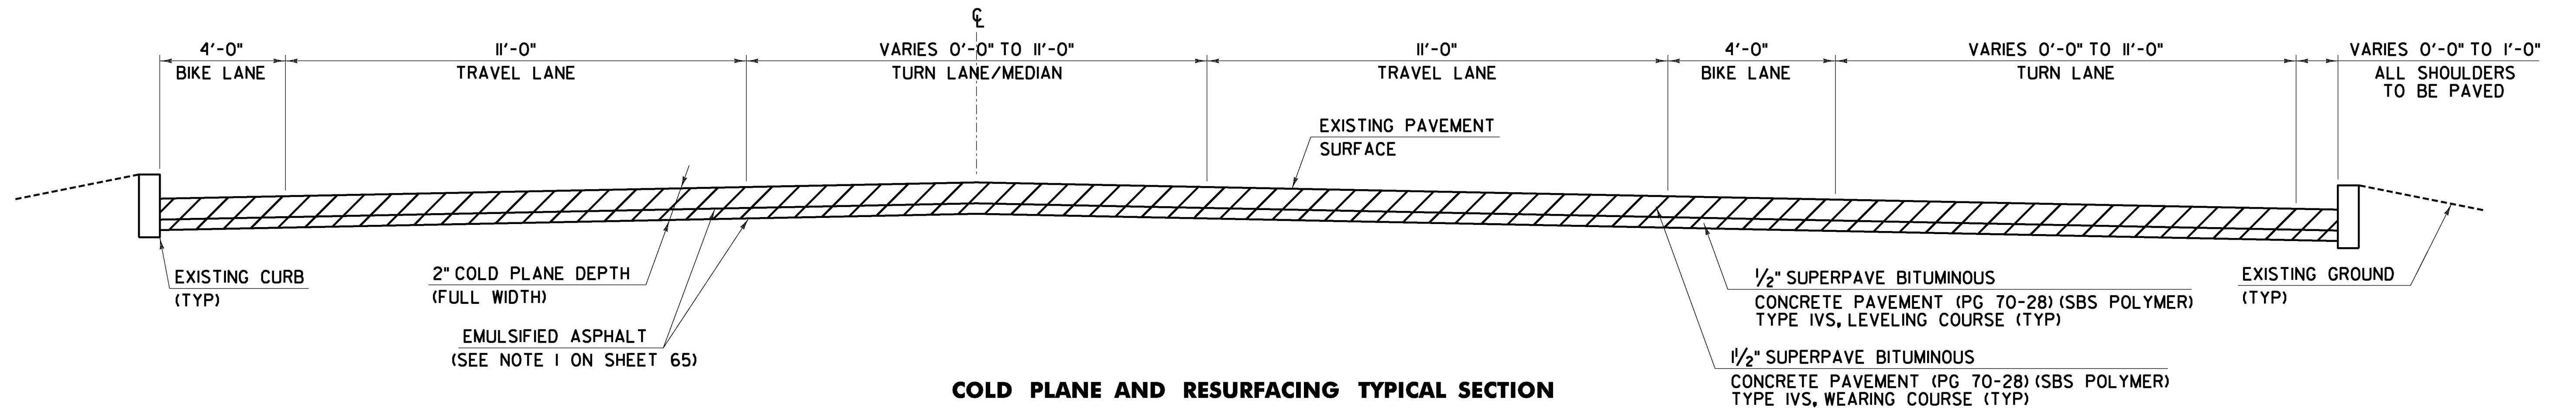

COLD PLANE AND RESURFACING TYPICAL SECTION
 VT ROUTE 15 ESSEX JUNCTION STA MN 140+00.00 TO STA MN 145+50.00

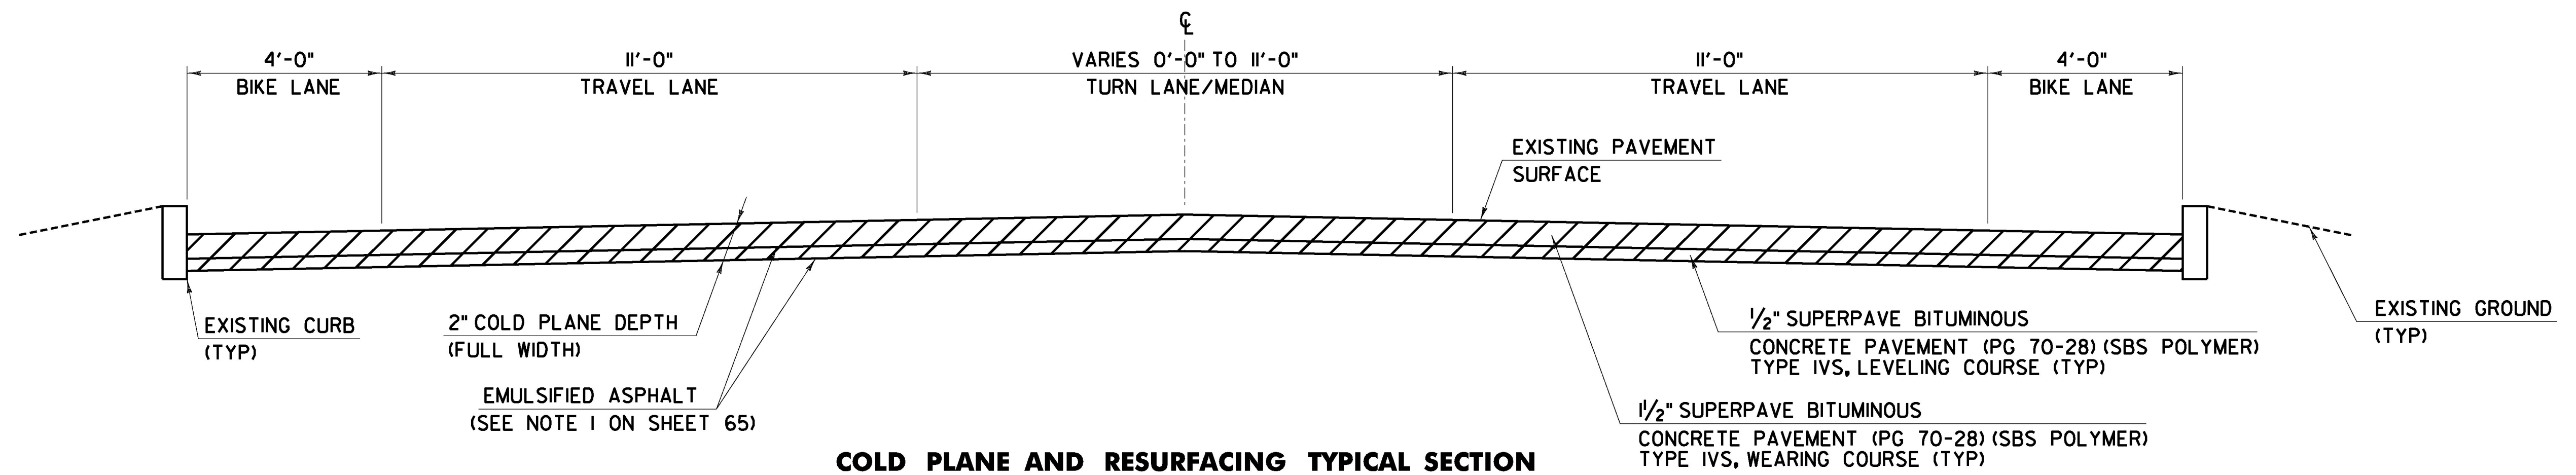

COLD PLANE AND RESURFACING TYPICAL SECTION
 VT ROUTE 15 ESSEX JUNCTION STA MN 145+50.00 TO STA MN 148+80.00

NOT TO SCALE	
PROJECT NAME: ESSEX JUNCTION	
PROJECT NUMBER: NH 2956(2)	
FILE NAME: z15v026typ.dgn	PLOT DATE: 5/9/2016
PROJECT LEADER: D.GOZALKOWSKI	DRAWN BY: C. KAHLBAUGH
DESIGNED BY: J. SCUDDER	CHECKED BY: J. SHIELDS
TYPICAL SECTIONS SHEET 4	SHEET 69 OF 171

