


**4 INCH WHITE LINE, LOW VOC CHLORINATED RUBBER PAINT**  
 (ALL LINES WILL INCLUDE EDGE LINE BREAKS AND RADIUS FOR TOWN HIGHWAYS)  
**ESSEX JUNCTION:**  
 STA PE 29+40.96 - STA PE 29+57.00 SOLID LANE LINE RT  
 STA PE 29+40.96 - STA PE 29+57.00 SOLID LANE LINE LT  
 STA PE 29+40.96 - STA PE 33+00.00 EDGE LINE LT & RT  
 STA PE 30+04.32 DASHED LANE LINE LT, TH-4  
 STA PE 30+04.32 SOLID LANE LINE LT, TH-4  
 STA PE 30+04.32 SOLID LANE LINE LT, TH-4  
 STA PE 30+04.32 EDGE LINES LT, TH-4  
 STA PE 30+50.00 - STA PE 33+00.00 DASHED LANE LINE LT & RT

**4 INCH YELLOW LINE, LOW VOC CHLORINATED RUBBER PAINT**  
 (ALL LINES WILL INCLUDE C/L LINE BREAKS FOR TOWN HIGHWAYS)  
 S = SOLID, D = DASHED  
**ESSEX JUNCTION:**  
 STA PE 29+40.96 - STA PE 29+60.00 MEDIAN EDGE LINE LT & RT  
 STA PE 30+04.32 - DOUBLE SOLID LT, TH-4  
 STA PE 30+46.00 - STA PE 33+00.00 MEDIAN EDGE LINE LT  
 STA PE 30+46.00 - STA PE 33+00.00 MEDIAN EDGE LINE RT  
 STA PE 30+51.00 - STA PE 30+95.00 ISLAND EDGE LINE LT

**8 INCH WHITE LINE, LOW VOC CHLORINATED RUBBER PAINT**  
**ESSEX JUNCTION:**  
 STA PE 30+41.00 - STA PE 30+70.00 HATCHED AREA LT

BEGIN NH 2956(2)  
 VT ROUTE 15  
 ESSEX JUNCTION  
 MM 0.557 = STA PE 29+40.96

STA PE 29+00.0, LT

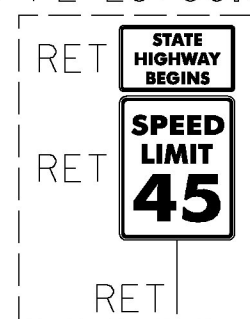


**LETTER OR SYMBOL, LOW VOC CHLORINATED RUBBER PAINT**  
**ESSEX JUNCTION:**  
 STA PE 29+47.00 RT, ARROW (1 EA)  
 STA PE 29+47.00 RT, ARROW (1 EA)  
 STA PE 30+04.32 LT, TH-4 ARROW (1 EA)  
 STA PE 30+04.32 LT, TH-4 ARROW (1 EA)  
 STA PE 30+04.32 LT, TH-4 ARROW (1 EA)  
 STA PE 30+04.32 LT, TH-4 "O,N,L,Y" (4)  
 STA PE 30+04.32 LT, TH-4 "O,N,L,Y" (4)  
 STA PE 30+04.32 LT, TH-4 "O,N,L,Y" (4)  
 STA PE 30+56.00 LT, YIELD LINE (4 EA)

**CROSSWALK MARKING, LOW VOC CHLORINATED RUBBER PAINT**  
**ESSEX JUNCTION:**  
 STA PE 30+04.32 LT, TH-4  
 STA PE 31+00.00 - STA PE 31+45.00 LT

**24 INCH STOP BAR, LOW VOC CHLORINATED RUBBER PAINT**  
**ESSEX JUNCTION:**  
 STA PE 29+56.00 RT  
 STA PE 30+04.32 LT, TH-4  
 STA PE 30+04.32 LT, TH-4  
 STA PE 30+51.00 LT  
 STA PE 30+51.00 LT

**REMOVAL OF EXISTING PAVEMENT MARKINGS**  
**ESSEX JUNCTION:**  
 STA PE 30+04.32 CROSSWALK LT, TH-4  
 STA PE 30+32.00 - STA PE 31+13.00, ISLAND EDGE LINES LT  
 STA PE 30+41.00 - STA PE 30+70.00 HATCHED AREA LT  
 STA PE 31+00.00 - STA PE 31+45.00 CROSSWALK LT

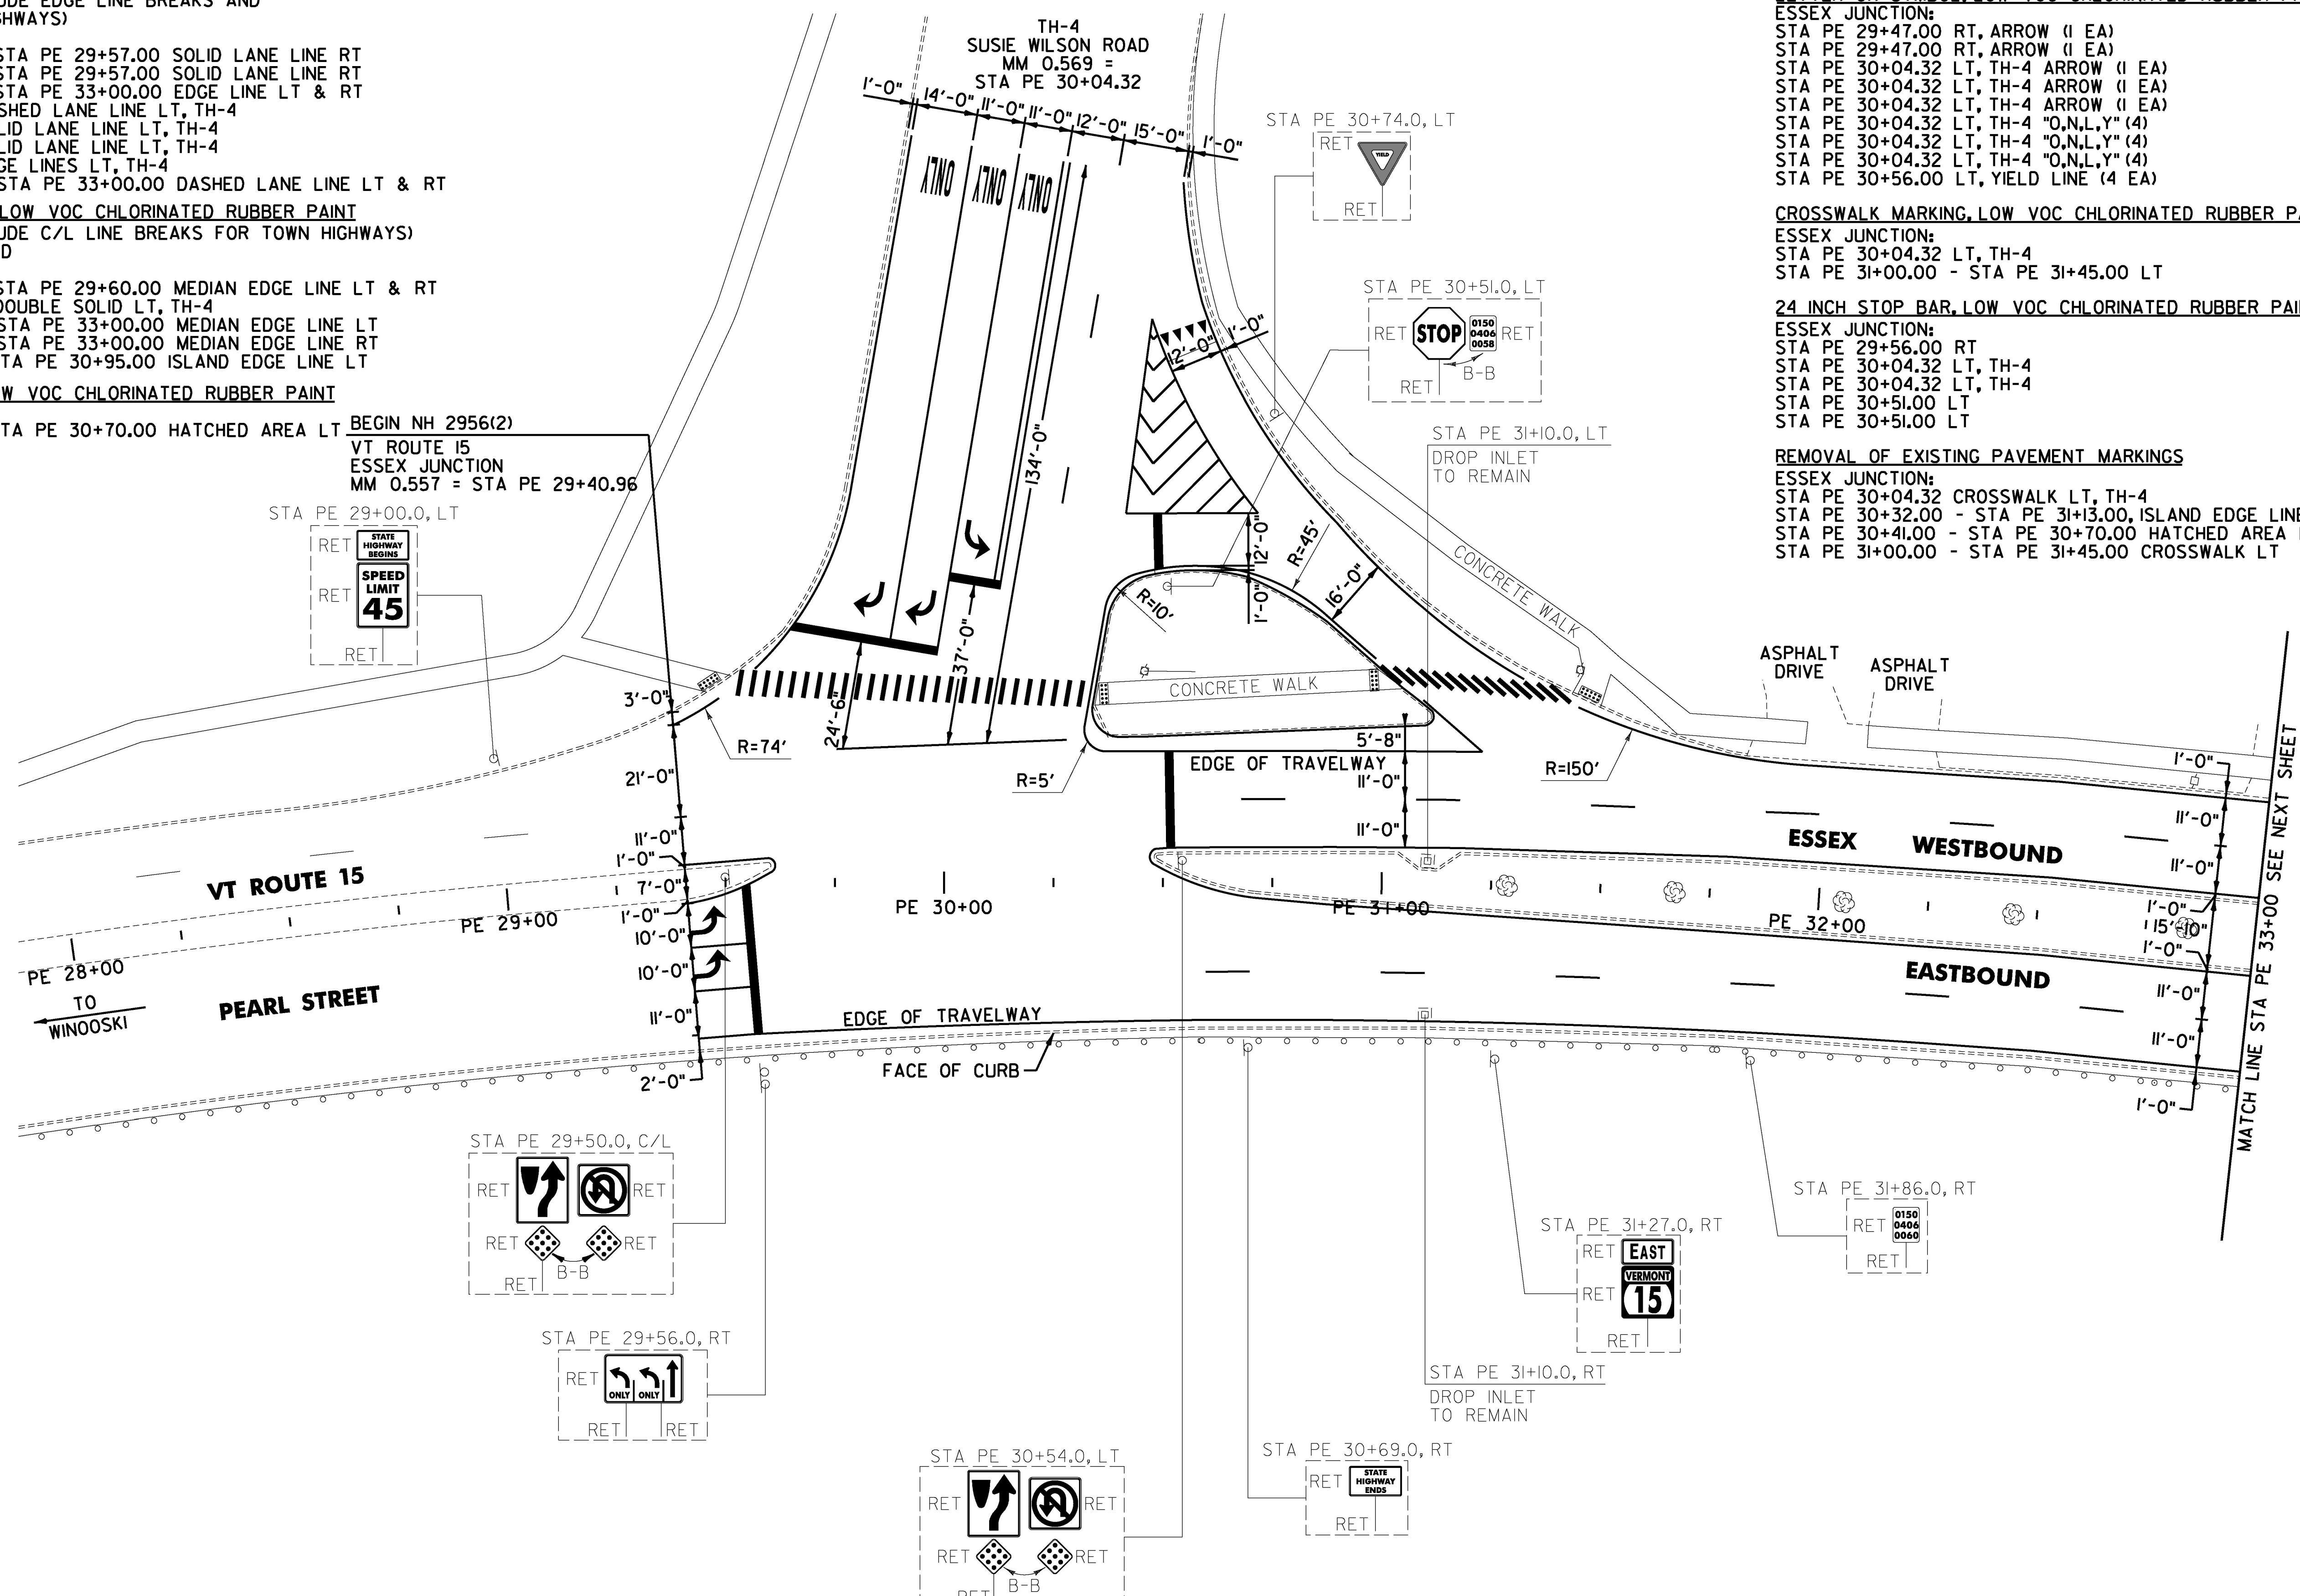

**PAINTED CURB (YELLOW)**  
**ESSEX JUNCTION:**  
 STA PE 29+40.96 - STA PE 29+60.00 LT & RT  
 STA PE 30+35.00 LT  
 STA PE 30+41.00 LT  
 STA PE 30+47.00 - STA PE 30+77.00 LT & RT  
 STA PE 30+70.00 LT  
 STA PE 31+11.00 LT

**SIGN LEGEND**  
 R = REMOVE  
 S = SALVAGE  
 N = NEW  
 RET = RETAIN  
 B-B = BACK TO BACK  
 EXISTING =   
 NEW =   
 R = RETURN TO VILLAGE OF ESSEX JUNCTION

NOT TO SCALE



PROJECT NAME: ESSEX JUNCTION  
 PROJECT NUMBER: NH 2956(2)

FILE NAME: z15v026bdr.dgn  
 PROJECT LEADER: D.GOZALKOWSKI  
 DESIGNED BY: J. SCUDDER  
 PLAN SHEET 1

PLOT DATE: 4/19/2016  
 DRAWN BY: C. KAHLBAUGH  
 CHECKED BY: J. SHIELDS  
 SHEET 83 OF 171

