
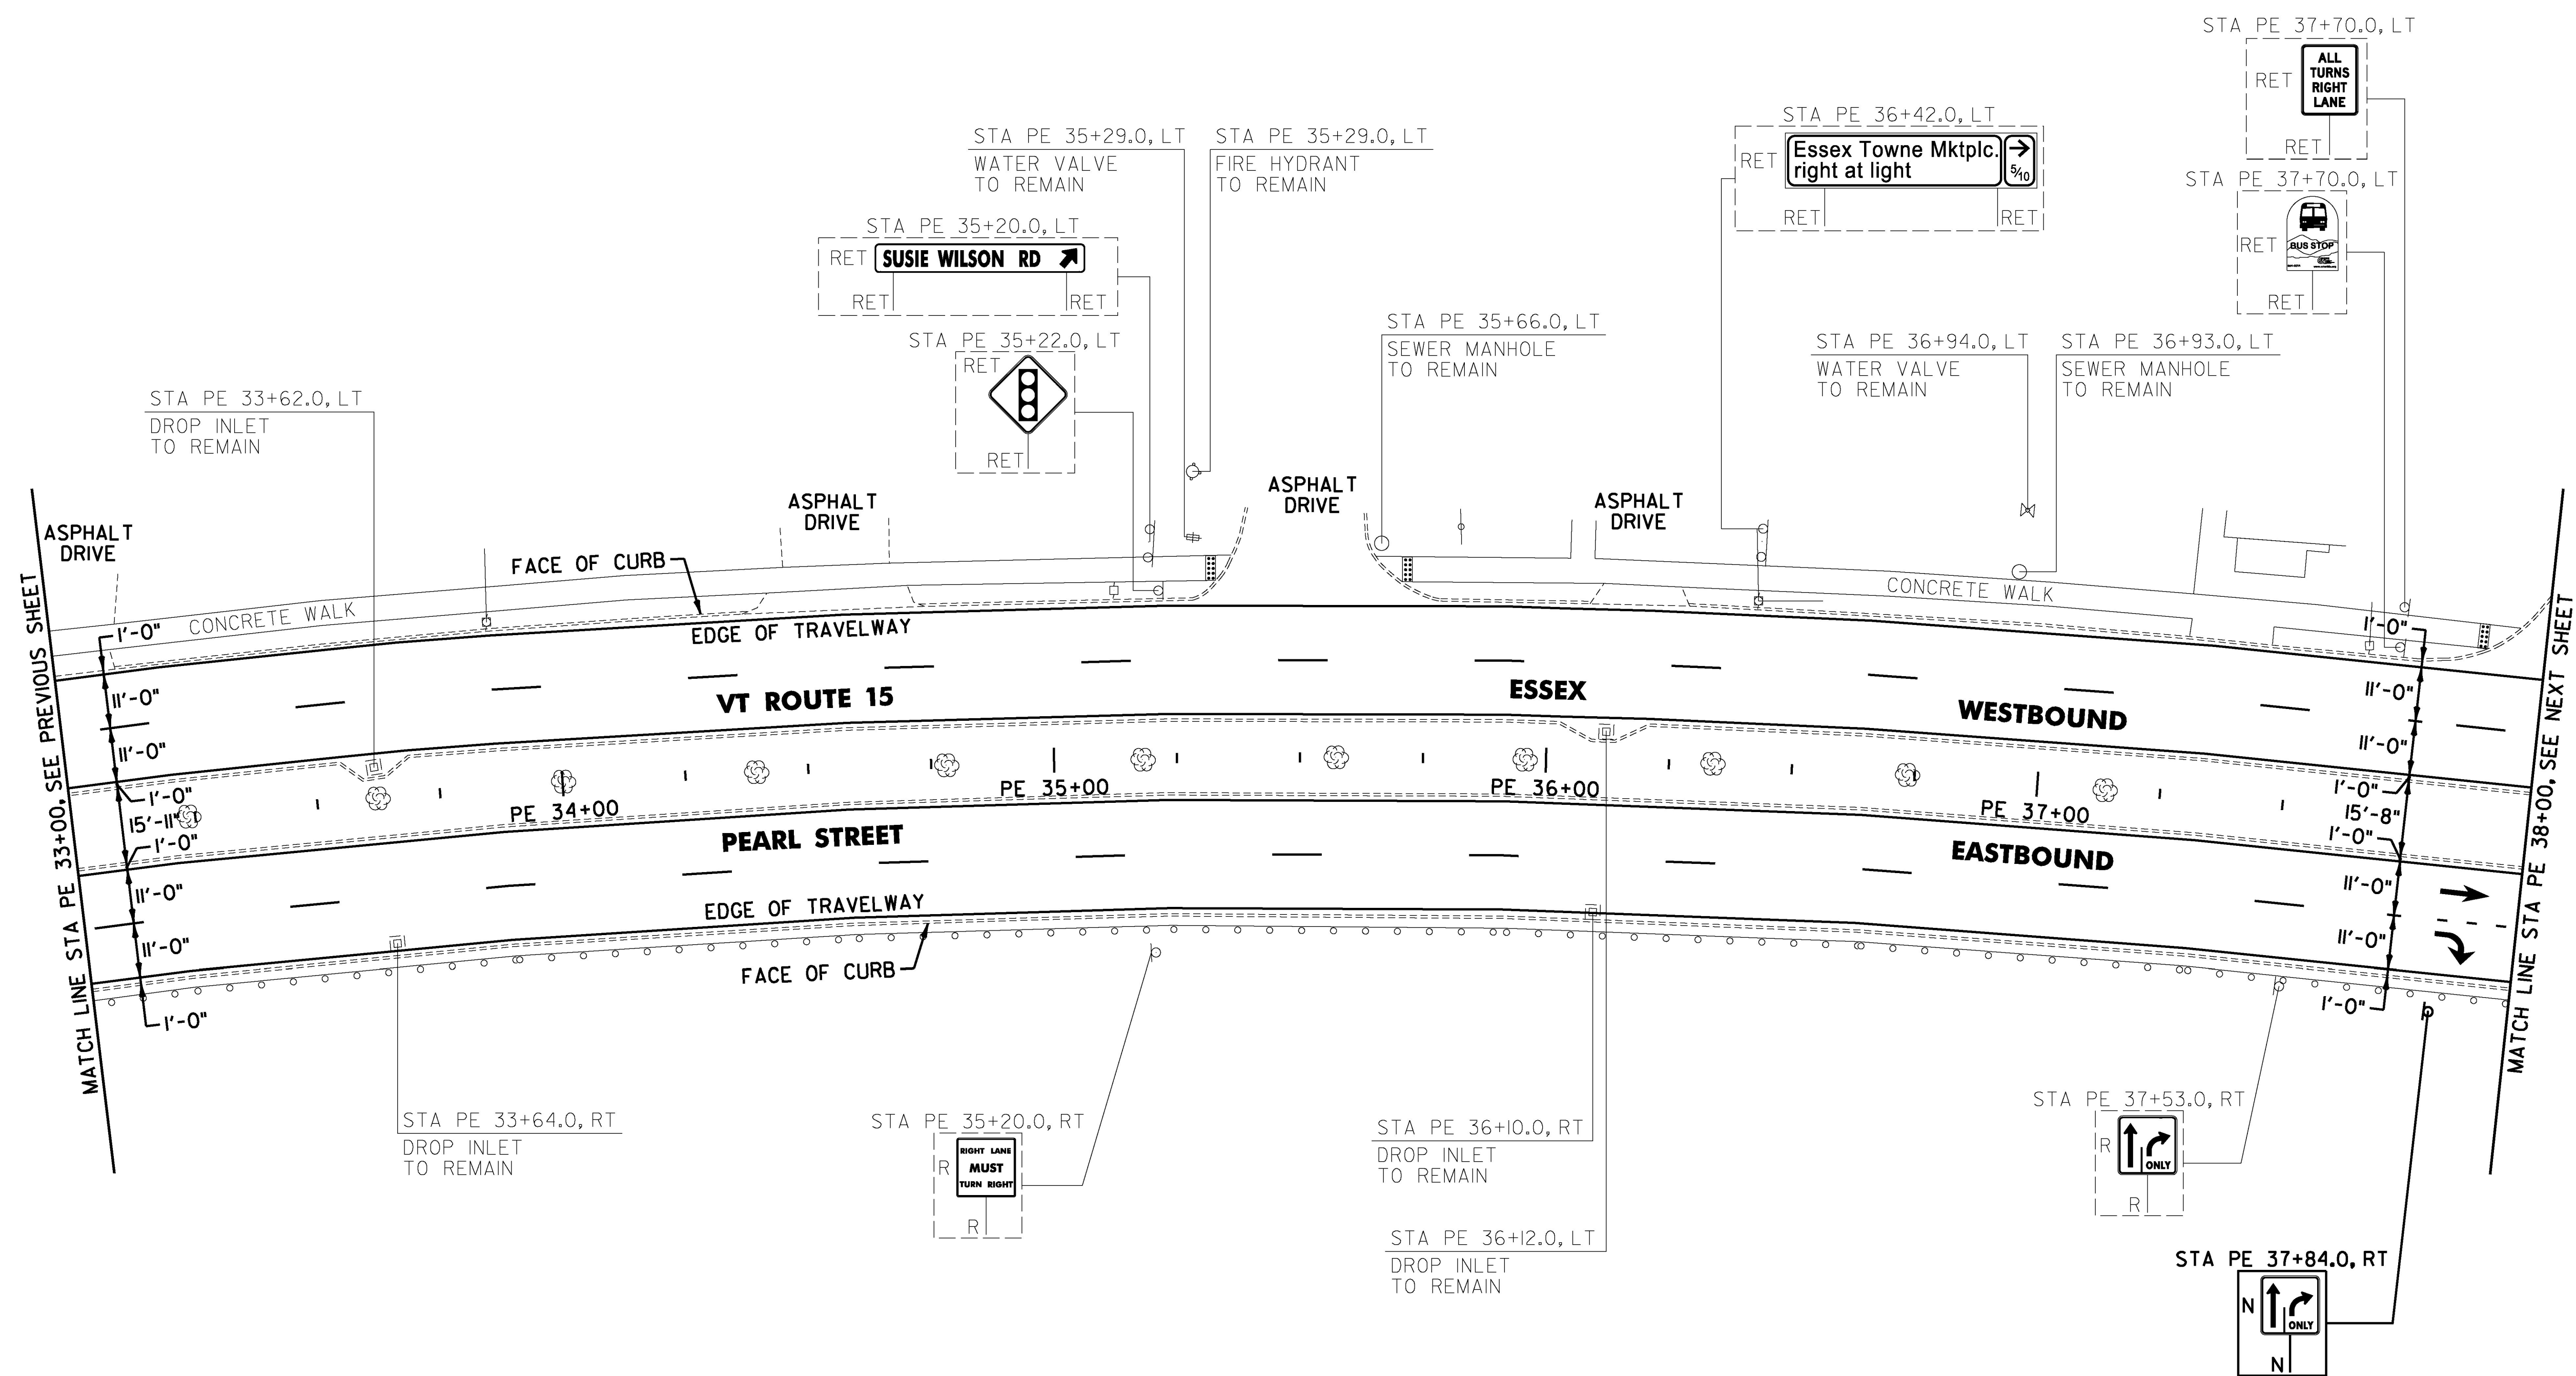


4 INCH WHITE LINE, LOW VOC CHLORINATED RUBBER PAINT
 (ALL LINES WILL INCLUDE EDGE LINE BREAKS AND RADIUS FOR TOWN HIGHWAYS)
ESSEX JUNCTION:
 STA PE 33+00.00 - STA PE 38+00.00 EDGE LINE LT & RT
 STA PE 33+00.00 - STA PE 38+00.00 DASHED LANE LINE LT
 STA PE 33+00.00 - STA PE 37+84.00 DASHED LANE LINE RT
 STA PE 37+84.00 - STA PE 38+00.00 DOTTED LANE LINE RT

LETTER OR SYMBOL, LOW VOC CHLORINATED RUBBER PAINT
ESSEX JUNCTION:
 STA PE 37+88.00 RT, ARROW (I EA)
 STA PE 37+88.00 RT, ARROW (I EA)
REMOVAL OF EXISTING PAVEMENT MARKINGS
ESSEX JUNCTION:
 STA PE 37+55.00 RT, "O,N,L,Y"
 STA PE 37+84.00 - STA PE 38+00.00 DASHED LANE LINE RT

4 INCH YELLOW LINE, LOW VOC CHLORINATED RUBBER PAINT
 (ALL LINES WILL INCLUDE C/L LINE BREAKS FOR TOWN HIGHWAYS)
S = SOLID, D = DASHED
ESSEX JUNCTION:
 STA PE 33+00.00 - STA PE 38+00.00 MEDIAN EDGE LINE LT
 STA PE 33+00.00 - STA PE 38+00.00 MEDIAN EDGE LINE RT

REMOVING SIGNS AS SHOWN - 2

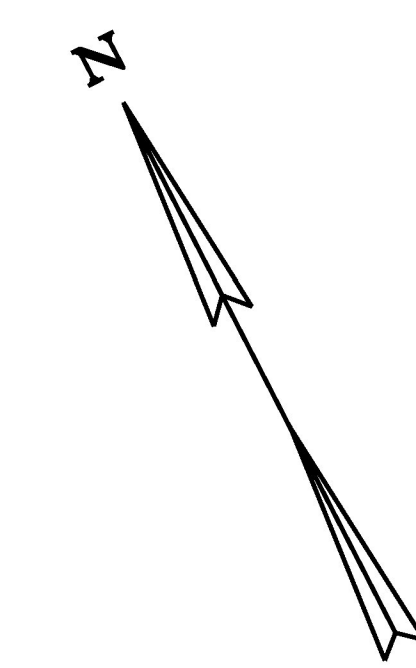

SIGN LEGEND
 R = REMOVE
 S = SALVAGE
 N = NEW
 RET = RETAIN
 B-B = BACK TO BACK
 EXISTING = _____
 NEW = _____
 R = RETURN TO VILLAGE OF ESSEX JUNCTION

NOT TO SCALE

CHA

PROJECT NAME: ESSEX JUNCTION	
PROJECT NUMBER: NH 2956(2)	
FILE NAME: z15v026bdr.dgn	PLOT DATE: 4/19/2016
PROJECT LEADER: D.GOZALKOWSKI	DRAWN BY: C. KAHLBAUGH
DESIGNED BY: J. SCUDDER	CHECKED BY: J. SHIELDS
PLAN SHEET 2	SHEET 84 OF 171