

4 INCH WHITE LINE, LOW VOC CHLORINATED RUBBER PAINT
 (ALL LINES WILL INCLUDE EDGE LINE BREAKS AND RADIUS FOR TOWN HIGHWAYS)
 ESSEX JUNCTION:
 STA PE 48+00.00 - STA PE 52+91.00 DASHED LANE LINE LT
 STA PE 48+00.00 - STA PE 49+89.00 SOLID LANE LINE RT
 STA PE 48+00.00 - STA PE 53+00.00 EDGE LINE LT & RT
 STA PE 51+10.00 - STA PE 52+14.00 DOTTED LANE LINE RT
 STA PE 51+71.00 - STA PE 52+93.00 MEDIAN EDGE LINE RT
 STA PE 52+14.00 - STA PE 52+92.00 SOLID LANE LINE RT

LETTER OR SYMBOL, LOW VOC CHLORINATED RUBBER PAINT
 ESSEX JUNCTION:
 STA PE 48+67.00 RT, "O,N,L,Y" (4 EA)
 STA PE 49+50.00 RT, ARROW (1 EA)
 STA PE 49+50.00 RT, ARROW (1 EA)
 STA PE 50+33.00 RT, "O,N,L,Y" (4 EA)
 STA PE 51+16.00 RT, ARROW (1 EA)
 STA PE 51+99.00 RT, "O,N,L,Y" (4 EA)
 STA PE 52+18.00 C/L, ARROW (1 EA)
 STA PE 52+82.00 C/L, ARROW (1 EA)
 STA PE 52+82.00 RT, ARROW (1 EA)

24 INCH STOP BAR, LOW VOC CHLORINATED RUBBER PAINT
 ESSEX JUNCTION:
 STA PE 52+90.00 C/L & RT
 STA PE 52+90.00 RT


REMOVAL OF EXISTING PAVEMENT MARKINGS
 ESSEX JUNCTION:
 STA PE 48+00.00 - STA PE 49+89.00 DASHED LANE LINE RT
 STA PE 48+89.00 RT, ARROWS
 STA PE 49+87.00 RT, "O,N,L,Y"
 STA PE 51+76.00 RT, ARROW
 STA PE 52+21.00 RT, "O,N,L,Y"
 STA PE 52+36.00 RT, ARROW (NOTHING TO REMOVE)

REMOVING SIGNS AS SHOWN - 6

4 INCH YELLOW LINE, LOW VOC CHLORINATED RUBBER PAINT
 (ALL LINES WILL INCLUDE C/L LINE BREAKS FOR TOWN HIGHWAYS)
 S = SOLID, D = DASHED
 ESSEX JUNCTION:
 STA PE 48+00.00 - STA PE 52+93.00 MEDIAN EDGE LINE LT
 STA PE 48+00.00 - STA PE 52+93.00 MEDIAN EDGE LINE RT
 STA PE 51+71.00 - STA PE 52+93.00 MEDIAN EDGE LINE RT

TEMPORARY 4 INCH WHITE LINE, PAINT
 (ALL LINES WILL INCLUDE EDGE LINE BREAKS AND RADIUS FOR TOWN HIGHWAYS)
 ESSEX JUNCTION:
 STA PE 52+91.00 - STA PE 53+00.00 EDGE LINE LT & RT

TEMPORARY 4 INCH YELLOW LINE, PAINT
 (ALL LINES WILL INCLUDE C/L LINE BREAKS FOR TOWN HIGHWAYS)
 S = SOLID, D = DASHED
 ESSEX JUNCTION:
 STA PE 52+91.00 - STA PE 52+93.00 MEDIAN EDGE LINE LT
 STA PE 52+91.00 - STA PE 52+93.00 MEDIAN EDGE LINE RT

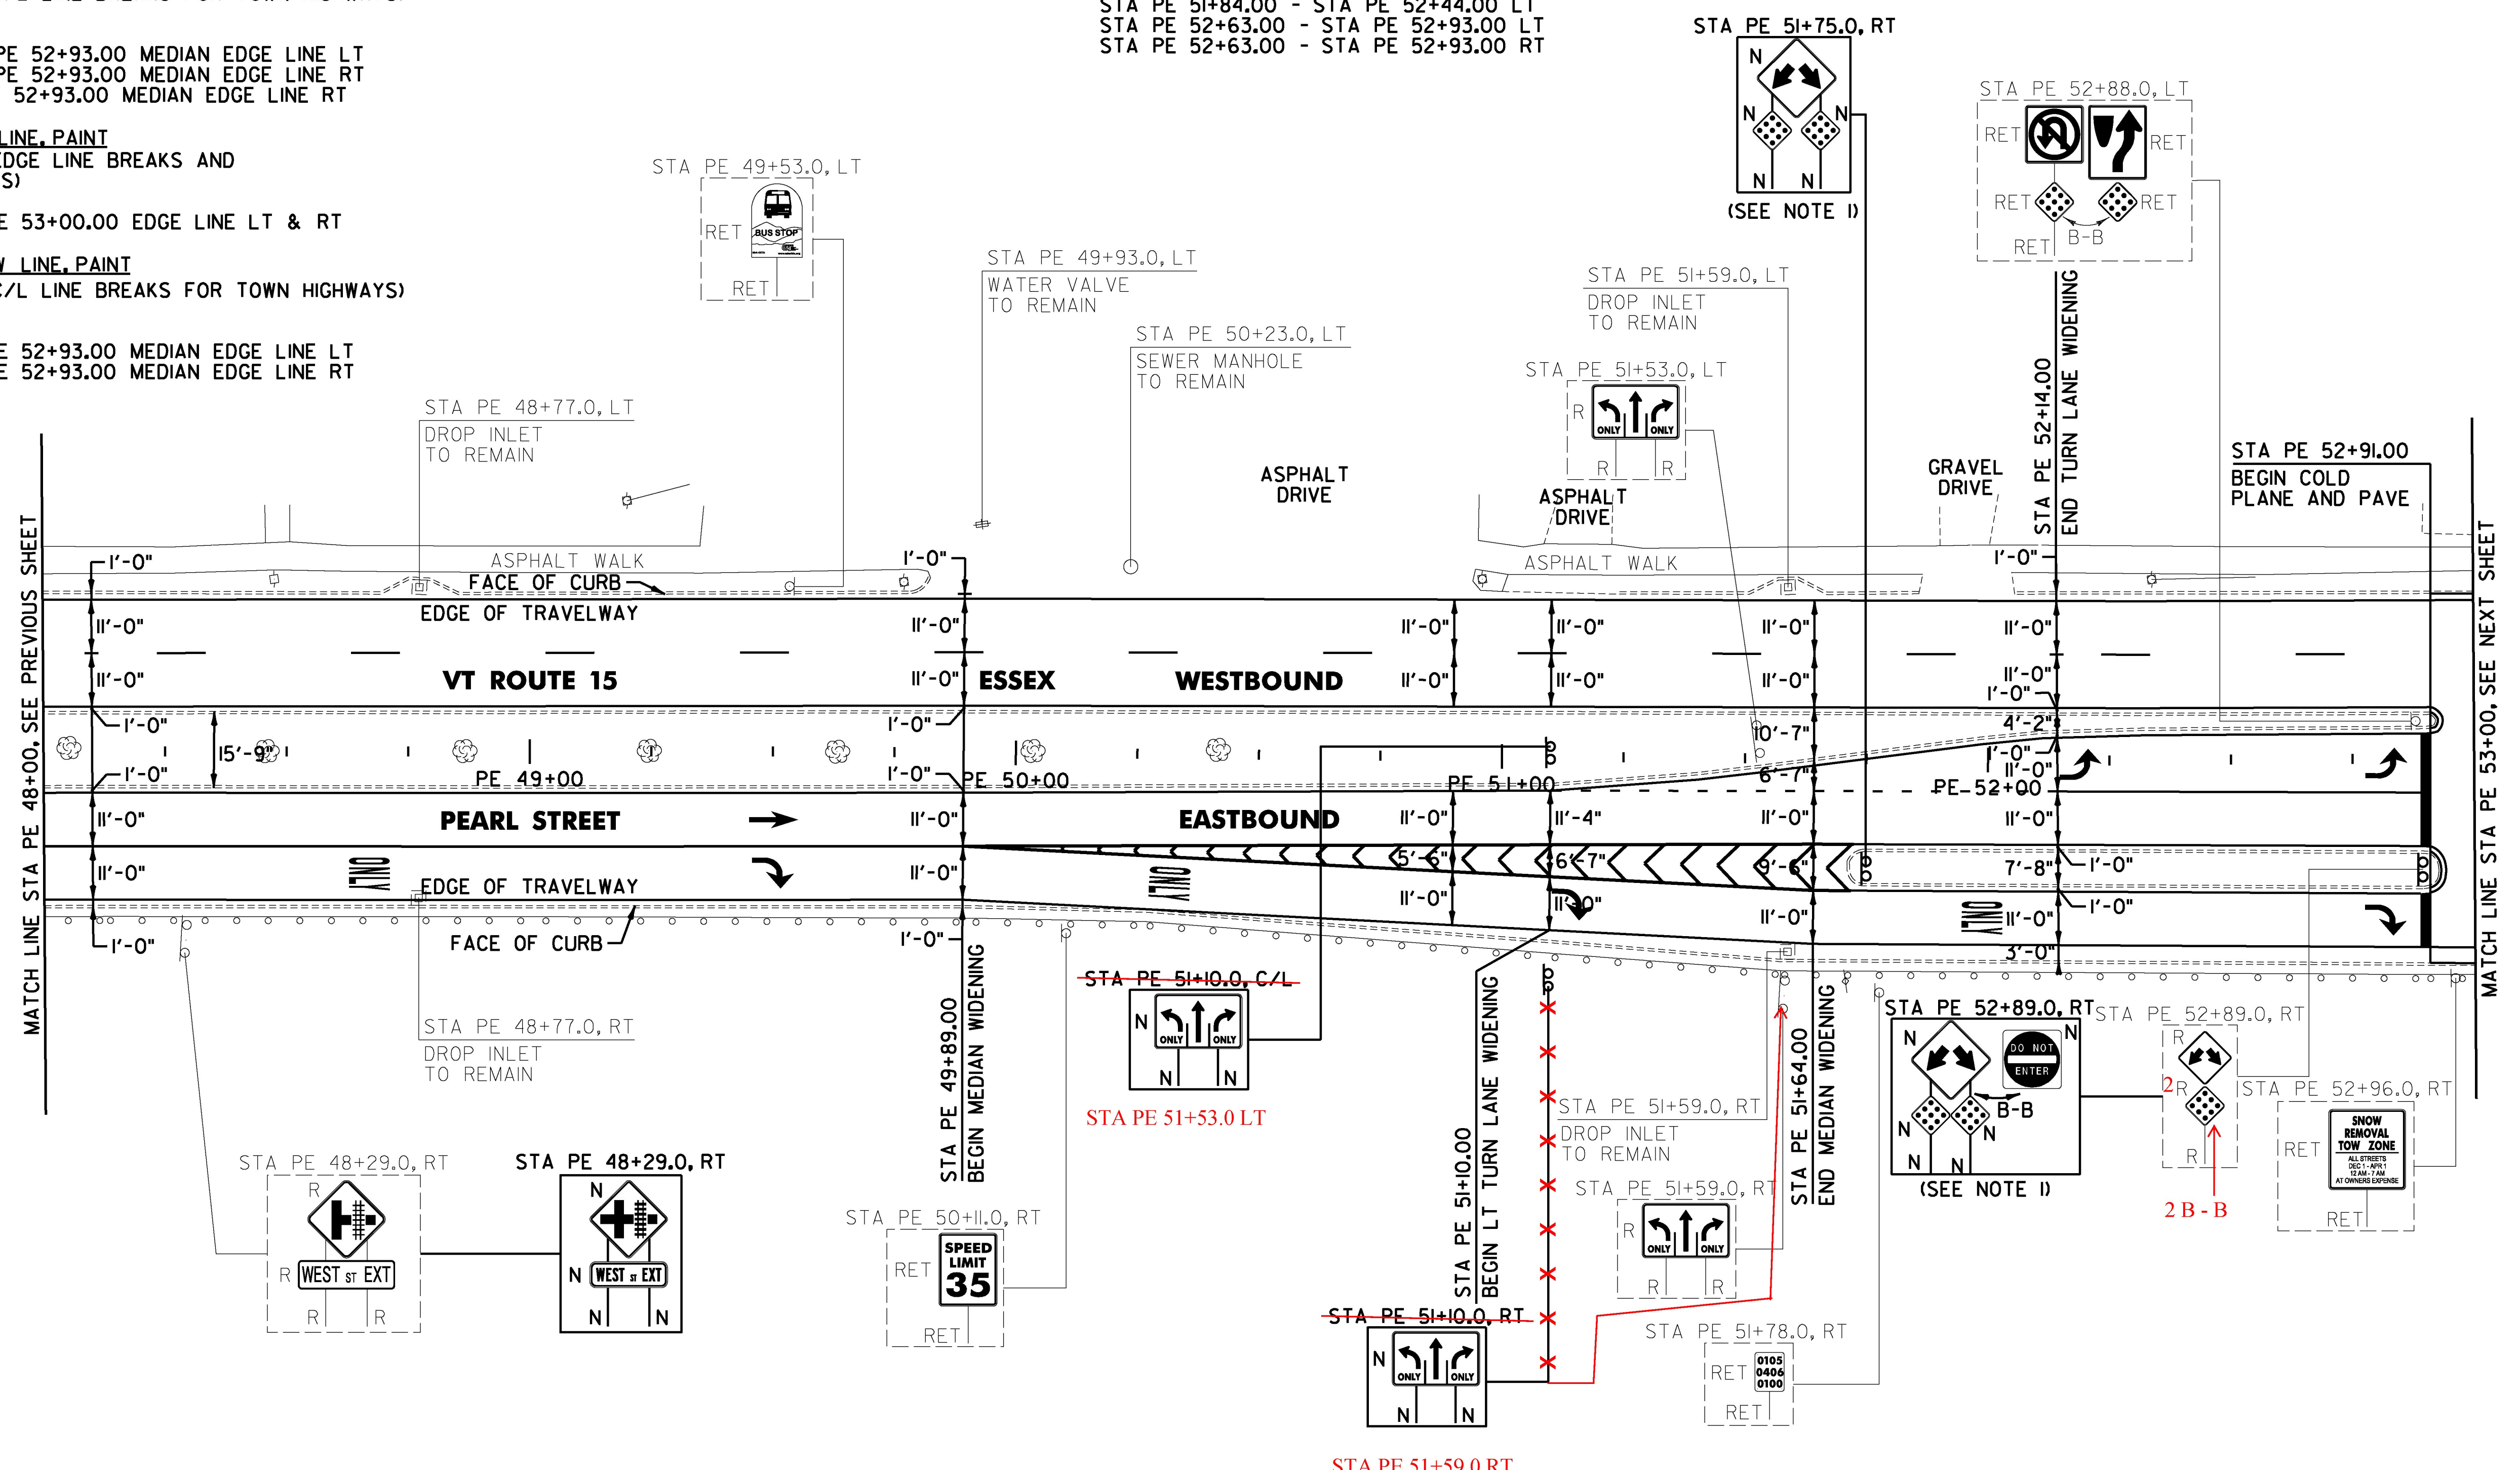

SIGN LEGEND
 R = REMOVE
 S = SALVAGE
 N = NEW
 RET = RETAIN
 B-B = BACK TO BACK
 EXISTING =
 NEW =
 R = RETURN TO VILLAGE OF ESSEX JUNCTION

NOTE:
 I. RETROREFLECTIVE YELLOW STRIPS SHALL BE INSTALLED ON SIGN POSTS.

NOT TO SCALE
CHA

PROJECT NAME: ESSEX JUNCTION	PLOT DATE: 4/19/2016
PROJECT NUMBER: NH 2956(2)	DRAWN BY: C. KAHLBAUGH
FILE NAME: z15v026bdr.dgn	CHECKED BY: J. SHIELDS
PROJECT LEADER: D.GOZALKOWSKI	SHEET 87 OF 171
DESIGNED BY: J. SCUDDER	
PLAN SHEET 5	