

4 INCH WHITE LINE, LOW VOC CHLORINATED RUBBER PAINT AND TEMPORARY 4 INCH WHITE LINE, PAINT

(ALL LINES WILL INCLUDE EDGE LINE BREAKS AND RADIUS FOR TOWN HIGHWAYS)

ESSEX JUNCTION:

STA PE 56+00.00 - STA PE 56+38.00 EDGE LINE LT
 STA PE 56+00.00 - STA PE 61+00.00 BIKE LANE LINE RT
 STA PE 56+00.00 - STA PE 61+00.00 HATCH BUFFER RT
 STA PE 56+25.00 - STA PE 57+75.00 DOTTED LANE LINE RT
 STA PE 56+38.00 - STA PE 58+00.00 BIKE LANE LINE LT
 STA PE 56+38.00 - STA PE 58+00.00 HATCH BUFFER LT
 STA PE 57+75.00 - STA PE 58+25.00 SOLID LANE LINE RT
 STA PE 58+00.00 - STA PE 58+90.00 DOTTED BIKE LANE LINES LT
 STA PE 58+50.24 EDGE LINES LT, WARNER AVENUE
 STA PE 58+90.00 - STA PE 60+92.00 BIKE LANE LINE LT
 STA PE 58+90.00 - STA PE 60+92.00 HATCH BUFFER RT
 STA PE 58+78.00 - STA PE 61+00.00 SOLID LANE LINE RT
 STA PE 60+92.00 - STA PE 61+00.00 DOTTED BIKE LANE LINES LT

6 INCH WHITE LINE, LOW VOC CHLORINATED RUBBER PAINT AND TEMPORARY 6 INCH WHITE LINE, PAINT

(ALL LINES WILL INCLUDE EDGE LINE BREAKS AND RADIUS FOR TOWN HIGHWAYS)

ESSEX JUNCTION:

STA PE 56+00.00 - STA PE 61+00.00 BIKE LANE EDGE LINE RT
 STA PE 56+38.00 - STA PE 58+00.00 BIKE LANE EDGE LINE LT
 STA PE 58+90.00 - STA PE 61+00.00 BIKE LANE EDGE LINE LT

4 INCH YELLOW LINE, LOW VOC CHLORINATED RUBBER PAINT AND TEMPORARY 4 INCH YELLOW LINE, PAINT

(ALL LINES WILL INCLUDE C/L LINE BREAKS FOR TOWN HIGHWAYS)

S = SOLID, D = DASHED

ESSEX JUNCTION:

STA PE 56+00.00 - STA PE 58+25.00 MEDIAN EDGE LINE LT
 STA PE 56+00.00 - STA PE 58+25.00 MEDIAN EDGE LINE RT
 STA PE 58+50.24 DOUBLE SOLID LT, WARNER AVE
 STA PE 58+78.00 - STA PE 61+00.00 DOUBLE SOLID LT

TEMPORARY LETTER OR SYMBOL, PAINT

ESSEX JUNCTION:

STA PE 57+79.00 RT, ARROW (2 EA)
 STA PE 57+89.00 LT, BIKE LANE SYMBOL (2 EA)
 STA PE 58+21.00 RT, ARROW (2 EA)
 STA PE 58+82.00 C/L, ARROW (2 EA)
 STA PE 58+21.00 RT, ARROW (2 EA)
 STA PE 60+36.00 RT, ARROW (2 EA)
 STA PE 60+37.00 LT, BIKE LANE SYMBOL (2 EA)

LETTER OR SYMBOL, LOW VOC CHLORINATED RUBBER PAINT

ESSEX JUNCTION:

STA PE 57+79.00 RT, ARROW (1 EA)
 STA PE 57+89.00 LT, BIKE LANE SYMBOL (1 EA)
 STA PE 58+21.00 RT, ARROW (1 EA)
 STA PE 58+82.00 C/L, ARROW (1 EA)
 STA PE 59+25.00 RT, BIKE LANE SYMBOL (1 EA)
 STA PE 59+59.00 RT, "O,N,L,Y," (4 EA)
 STA PE 60+36.00 RT, ARROW (1 EA)
 STA PE 60+37.00 LT, BIKE LANE SYMBOL (1 EA)

24 INCH STOP BAR, LOW VOC CHLORINATED RUBBER PAINT AND TEMPORARY 24 INCH STOP BAR, PAINT

SWANTON:

STA PE 58+50.24 LT, WARNER AVENUE

CROSSWALK MARKING, LOW VOC CHLORINATED RUBBER PAINT AND TEMPORARY CROSSWALK MARKING, PAINT

ESSEX JUNCTION:

STA PE 56+00.00 - STA PE 56+17.00 LT
 STA PE 58+50.24 LT, WARNER AVENUE

PAINTED CURB (YELLOW)

ESSEX JUNCTION:

STA PE 56+00.00 - STA PE 56+55.00 LT/RT
 STA PE 57+93.00 - STA PE 58+23.00 LT/RT



8 INCH YELLOW LINE, LOW VOC CHLORINATED RUBBER PAINT

ESSEX JUNCTION:

STA PE 56+50.00 - STA PE 58+25.00 HATCHED AREA LT

REMOVING SIGNS

AS SHOWN - 15

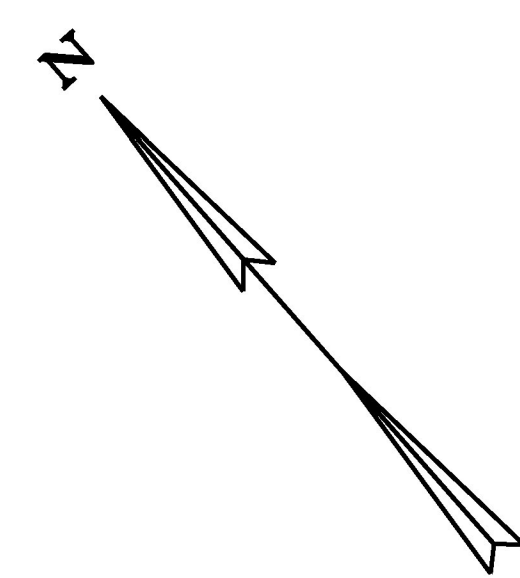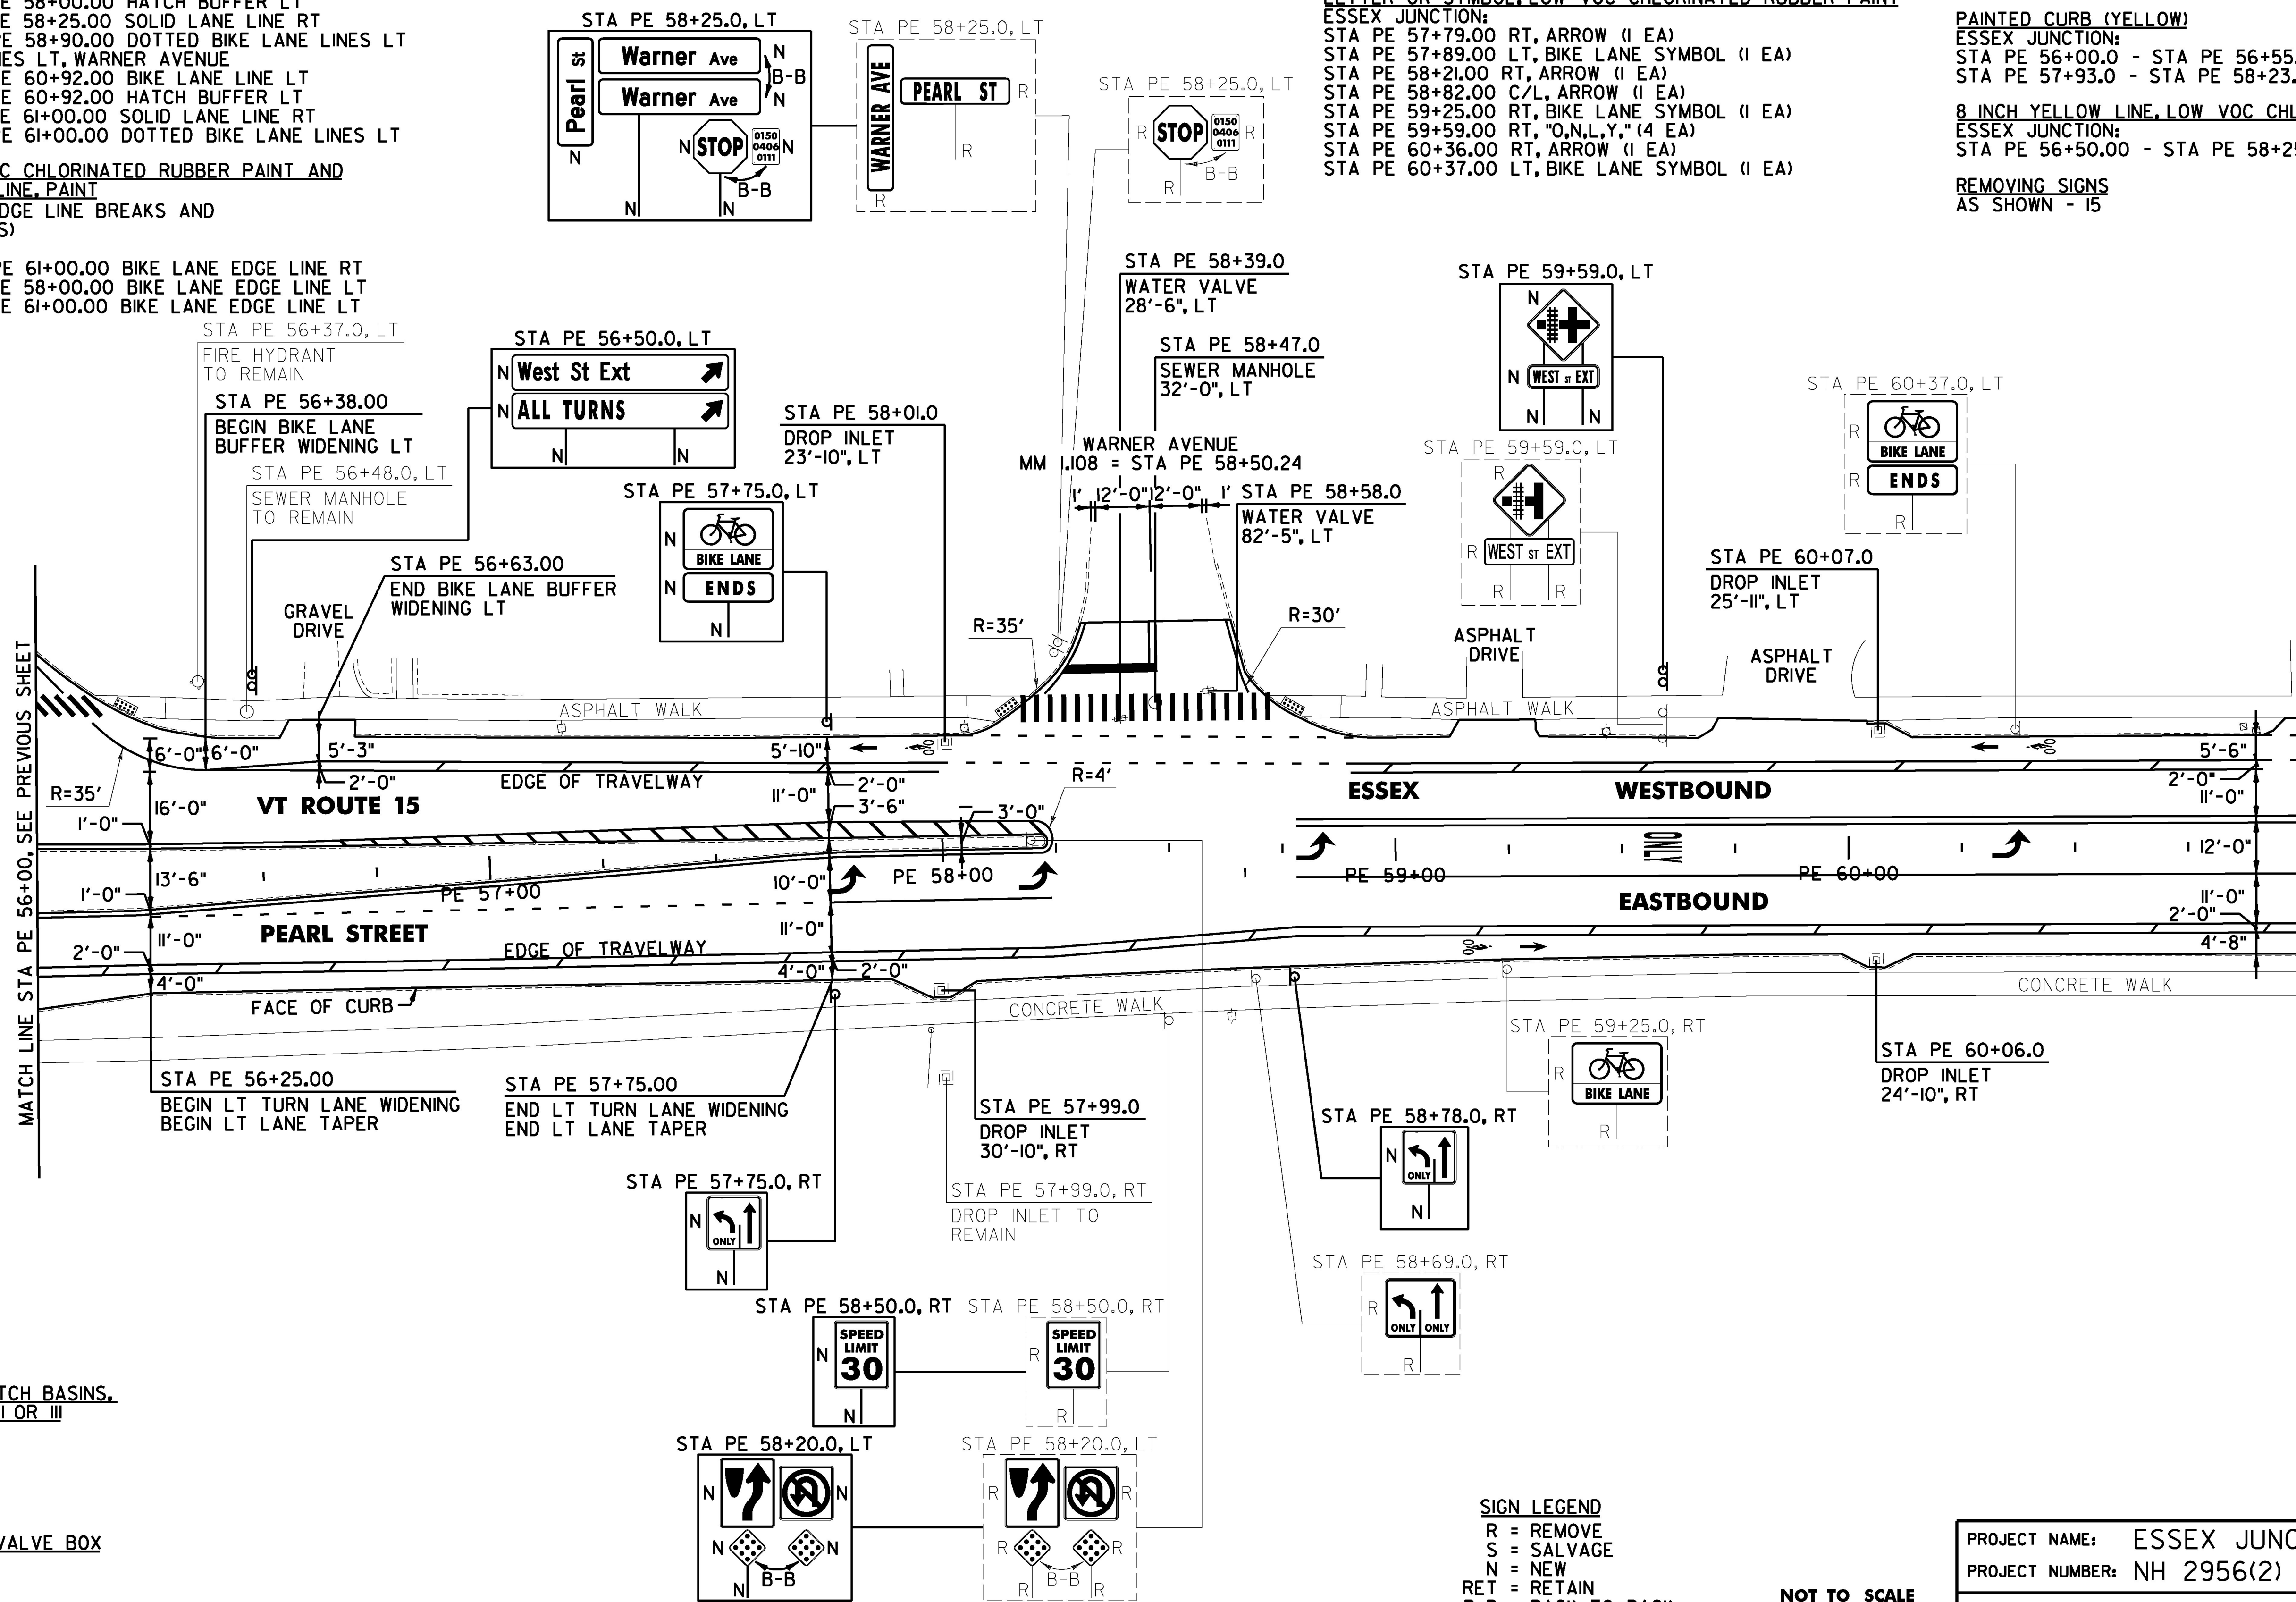

REHAB, DROP INLETS, CATCH BASINS, OR MANHOLES, CLASS I, II OR III

ESSEX JUNCTION:

~~STA PE 57+99.0 RT~~
~~STA PE 58+01.0 LT~~
~~STA PE 60+06.0 RT~~
~~STA PE 60+07.0 LT~~

ADJUST ELEVATION OF VALVE BOX

ESSEX JUNCTION:

STA PE 58+39.0 LT
 STA PE 58+58.0 LT

CHANGING ELEVATION OF SEWER MANHOLES

ESSEX JUNCTION:

STA PE 58+47.0 LT PE 58+01 LT

SIGN LEGEND

R = REMOVE
 S = SALVAGE
 N = NEW
 RET = RETAIN
 B-B = BACK TO BACK
 EXISTING = _____
 NEW = _____
 R = RETURN TO VILLAGE OF ESSEX JUNCTION

NOT TO SCALE



PROJECT NAME: ESSEX JUNCTION

PROJECT NUMBER: NH 2956(2)

FILE NAME: z15v026bdr.dgn

PROJECT LEADER: D.GOZALKOWSKI

DESIGNED BY: J. SCUDDER

PLAN SHEET 7

PLOT DATE: 4/19/2016

DRAWN BY: C. KAHLBAUGH

CHECKED BY: J. SHIELDS

SHEET 89 OF 171