

4 INCH WHITE LINE, LOW VOC CHLORINATED RUBBER PAINT AND TEMPORARY 4 INCH WHITE LINE, PAINT

(ALL LINES WILL INCLUDE EDGE LINE BREAKS AND RADIUS FOR TOWN HIGHWAYS)

ESSEX JUNCTION:

- STA PE 81+00.00 - STA PE 81+23.00 DOTTED LANE LINE LT
- STA PE 81+00.00 - STA PE 81+20.00 BIKE LANE LINE RT
- STA PE 81+00.00 - STA PE 81+20.00 HATCH BUFFER RT
- STA PE 81+00.00 - STA PE 81+80.00 BIKE LANE LINE LT
- STA PE 81+00.00 - STA PE 81+80.00 HATCH BUFFER LT
- STA PE 81+20.00 - STA PE 81+85.00 DOTTED BIKE LANE LINES RT
- STA PE 81+80.00 - STA PE 82+48.00 DOTTED BIKE LANE LINES LT
- STA PE 81+68.00 - STA PE 82+39.00 SOLID LANE LINE LT
- STA PE 81+85.00 - STA PE 82+32.00 BIKE LANE LINE RT
- STA PE 81+85.00 - STA PE 82+32.00 HATCH BUFFER RT
- STA PE 82+32.00 - STA PE 82+69.00 DOTTED BIKE LANE LINES RT
- STA PE 82+48.00 - STA PE 83+19.00 BIKE LANE LINE LT
- STA PE 82+48.00 - STA PE 83+19.00 HATCH BUFFER LT
- STA PE 82+59.00 - STA PE 83+14.00 SOLID LANE LINE LT
- STA PE 82+69.00 - STA PE 83+06.00 BIKE LANE LINE RT
- STA PE 82+69.00 - STA PE 83+06.00 HATCH BUFFER RT
- STA PE 83+06.00 - STA PE 83+39.00 DOTTED BIKE LANE LINES RT
- STA PE 83+19.00 - STA PE 83+84.00 DOTTED BIKE LANE LINES LT
- STA PE 83+39.00 - STA PE 84+19.00 BIKE LANE LINE RT
- STA PE 83+39.00 - STA PE 84+19.00 HATCH BUFFER RT
- STA PE 83+55.00 - STA PE 84+27.00 SOLID LANE LINE RT
- STA PE 83+84.00 - STA PE 84+09.00 BIKE LANE LINE LT
- STA PE 84+09.00 - STA PE 86+00.00 EDGE LINE LT
- STA PE 84+19.00 - STA PE 86+00.00 EDGE LINE RT

4 INCH YELLOW LINE, LOW VOC CHLORINATED RUBBER PAINT AND TEMPORARY 4 INCH YELLOW LINE, PAINT

(ALL LINES WILL INCLUDE C/L LINE BREAKS FOR TOWN HIGHWAYS)

S = SOLID, D = DASHED

ESSEX JUNCTION:

- STA PE 81+00.00 - STA PE 81+23.00 DOUBLE SOLID MEDIAN LT & RT
- STA PE 81+68.00 - STA PE 82+39.00 DOUBLE SOLID RT
- STA PE 82+59.00 - STA PE 83+14.00 DOUBLE SOLID RT
- STA PE 83+55.00 - STA PE 84+27.00 DOUBLE SOLID LT
- STA PE 84+60.00 - STA PE 86+00.00 SOLID/DASH TURN LANE LINES LT & RT

8 INCH YELLOW LINE, LOW VOC CHLORINATED RUBBER PAINT

ESSEX JUNCTION:

- STA PE 81+00.00 - STA PE 81+23.00 HATCHED MEDIAN LT/RT

TEMPORARY LETTER OR SYMBOL, PAINT

ESSEX JUNCTION:

- STA PE 81+72.00 C/L, ARROW (2 EA)
- STA PE 82+34.00 C/L, ARROW (2 EA)
- STA PE 82+66.00 C/L, ARROW (2 EA)
- STA PE 83+06.00 C/L, ARROW (2 EA)
- STA PE 83+40.00 RT, BIKE LANE SYMBOL (2 EA)
- STA PE 83+69.00 C/L, ARROW (2 EA)
- STA PE 83+96.00 LT, BIKE LANE SYMBOL (2 EA)
- STA PE 84+23.00 C/L, ARROW (2 EA)
- STA PE 84+65.00 RT, SHARED LANE SYMBOL (2 EA)
- STA PE 84+84.00 C/L, ARROW (2 EA)
- STA PE 84+97.00 C/L, ARROW (2 EA)
- STA PE 85+54.00 LT, SHARED LANE SYMBOL (2 EA)
- STA PE 85+78.00 C/L, ARROW (2 EA)
- STA PE 85+91.00 C/L, ARROW (2 EA)

LETTER OR SYMBOL, LOW VOC CHLORINATED RUBBER PAINT

ESSEX JUNCTION:

- STA PE 81+72.00 C/L, ARROW (1 EA)
- STA PE 82+34.00 C/L, ARROW (1 EA)
- STA PE 82+66.00 C/L, ARROW (1 EA)
- STA PE 83+06.00 C/L, ARROW (1 EA)
- STA PE 83+40.00 RT, BIKE LANE SYMBOL (1 EA)
- STA PE 83+69.00 C/L, ARROW (1 EA)
- STA PE 83+96.00 LT, BIKE LANE SYMBOL (1 EA)
- STA PE 84+23.00 C/L, ARROW (1 EA)
- STA PE 84+65.00 RT, SHARED LANE SYMBOL (1 EA)
- STA PE 84+84.00 C/L, ARROW (1 EA)
- STA PE 84+97.00 C/L, ARROW (1 EA)
- STA PE 85+54.00 LT, SHARED LANE SYMBOL (1 EA)
- STA PE 85+78.00 C/L, ARROW (1 EA)
- STA PE 85+91.00 C/L, ARROW (1 EA)

6 INCH WHITE LINE, LOW VOC CHLORINATED RUBBER PAINT AND TEMPORARY 6 INCH WHITE LINE, PAINT

(ALL LINES WILL INCLUDE EDGE LINE BREAKS AND RADIUS FOR TOWN HIGHWAYS)

ESSEX JUNCTION:

- STA PE 81+00.00 - STA PE 81+20.00 BIKE LANE EDGE LINE RT
- STA PE 81+00.00 - STA PE 81+80.00 BIKE LANE EDGE LINE LT
- STA PE 81+85.00 - STA PE 82+32.00 BIKE LANE EDGE LINE RT
- STA PE 82+48.00 - STA PE 83+19.00 BIKE LANE EDGE LINE LT
- STA PE 82+69.00 - STA PE 83+06.00 BIKE LANE EDGE LINE RT
- STA PE 83+39.00 - STA PE 84+19.00 BIKE LANE EDGE LINE RT
- STA PE 83+84.00 - STA PE 84+09.00 BIKE LANE EDGE LINE LT


PAINTED CURB (YELLOW)

ESSEX JUNCTION:

- STA PE 82+42.00 - STA PE 82+72.00 LT (60 LF)
- STA PE 82+94.00 - STA PE 83+24.00 LT (60 LF)

ERECTING SALVAGED SIGNS AS SHOWN - 1

REMOVING SIGNS AS SHOWN - 12

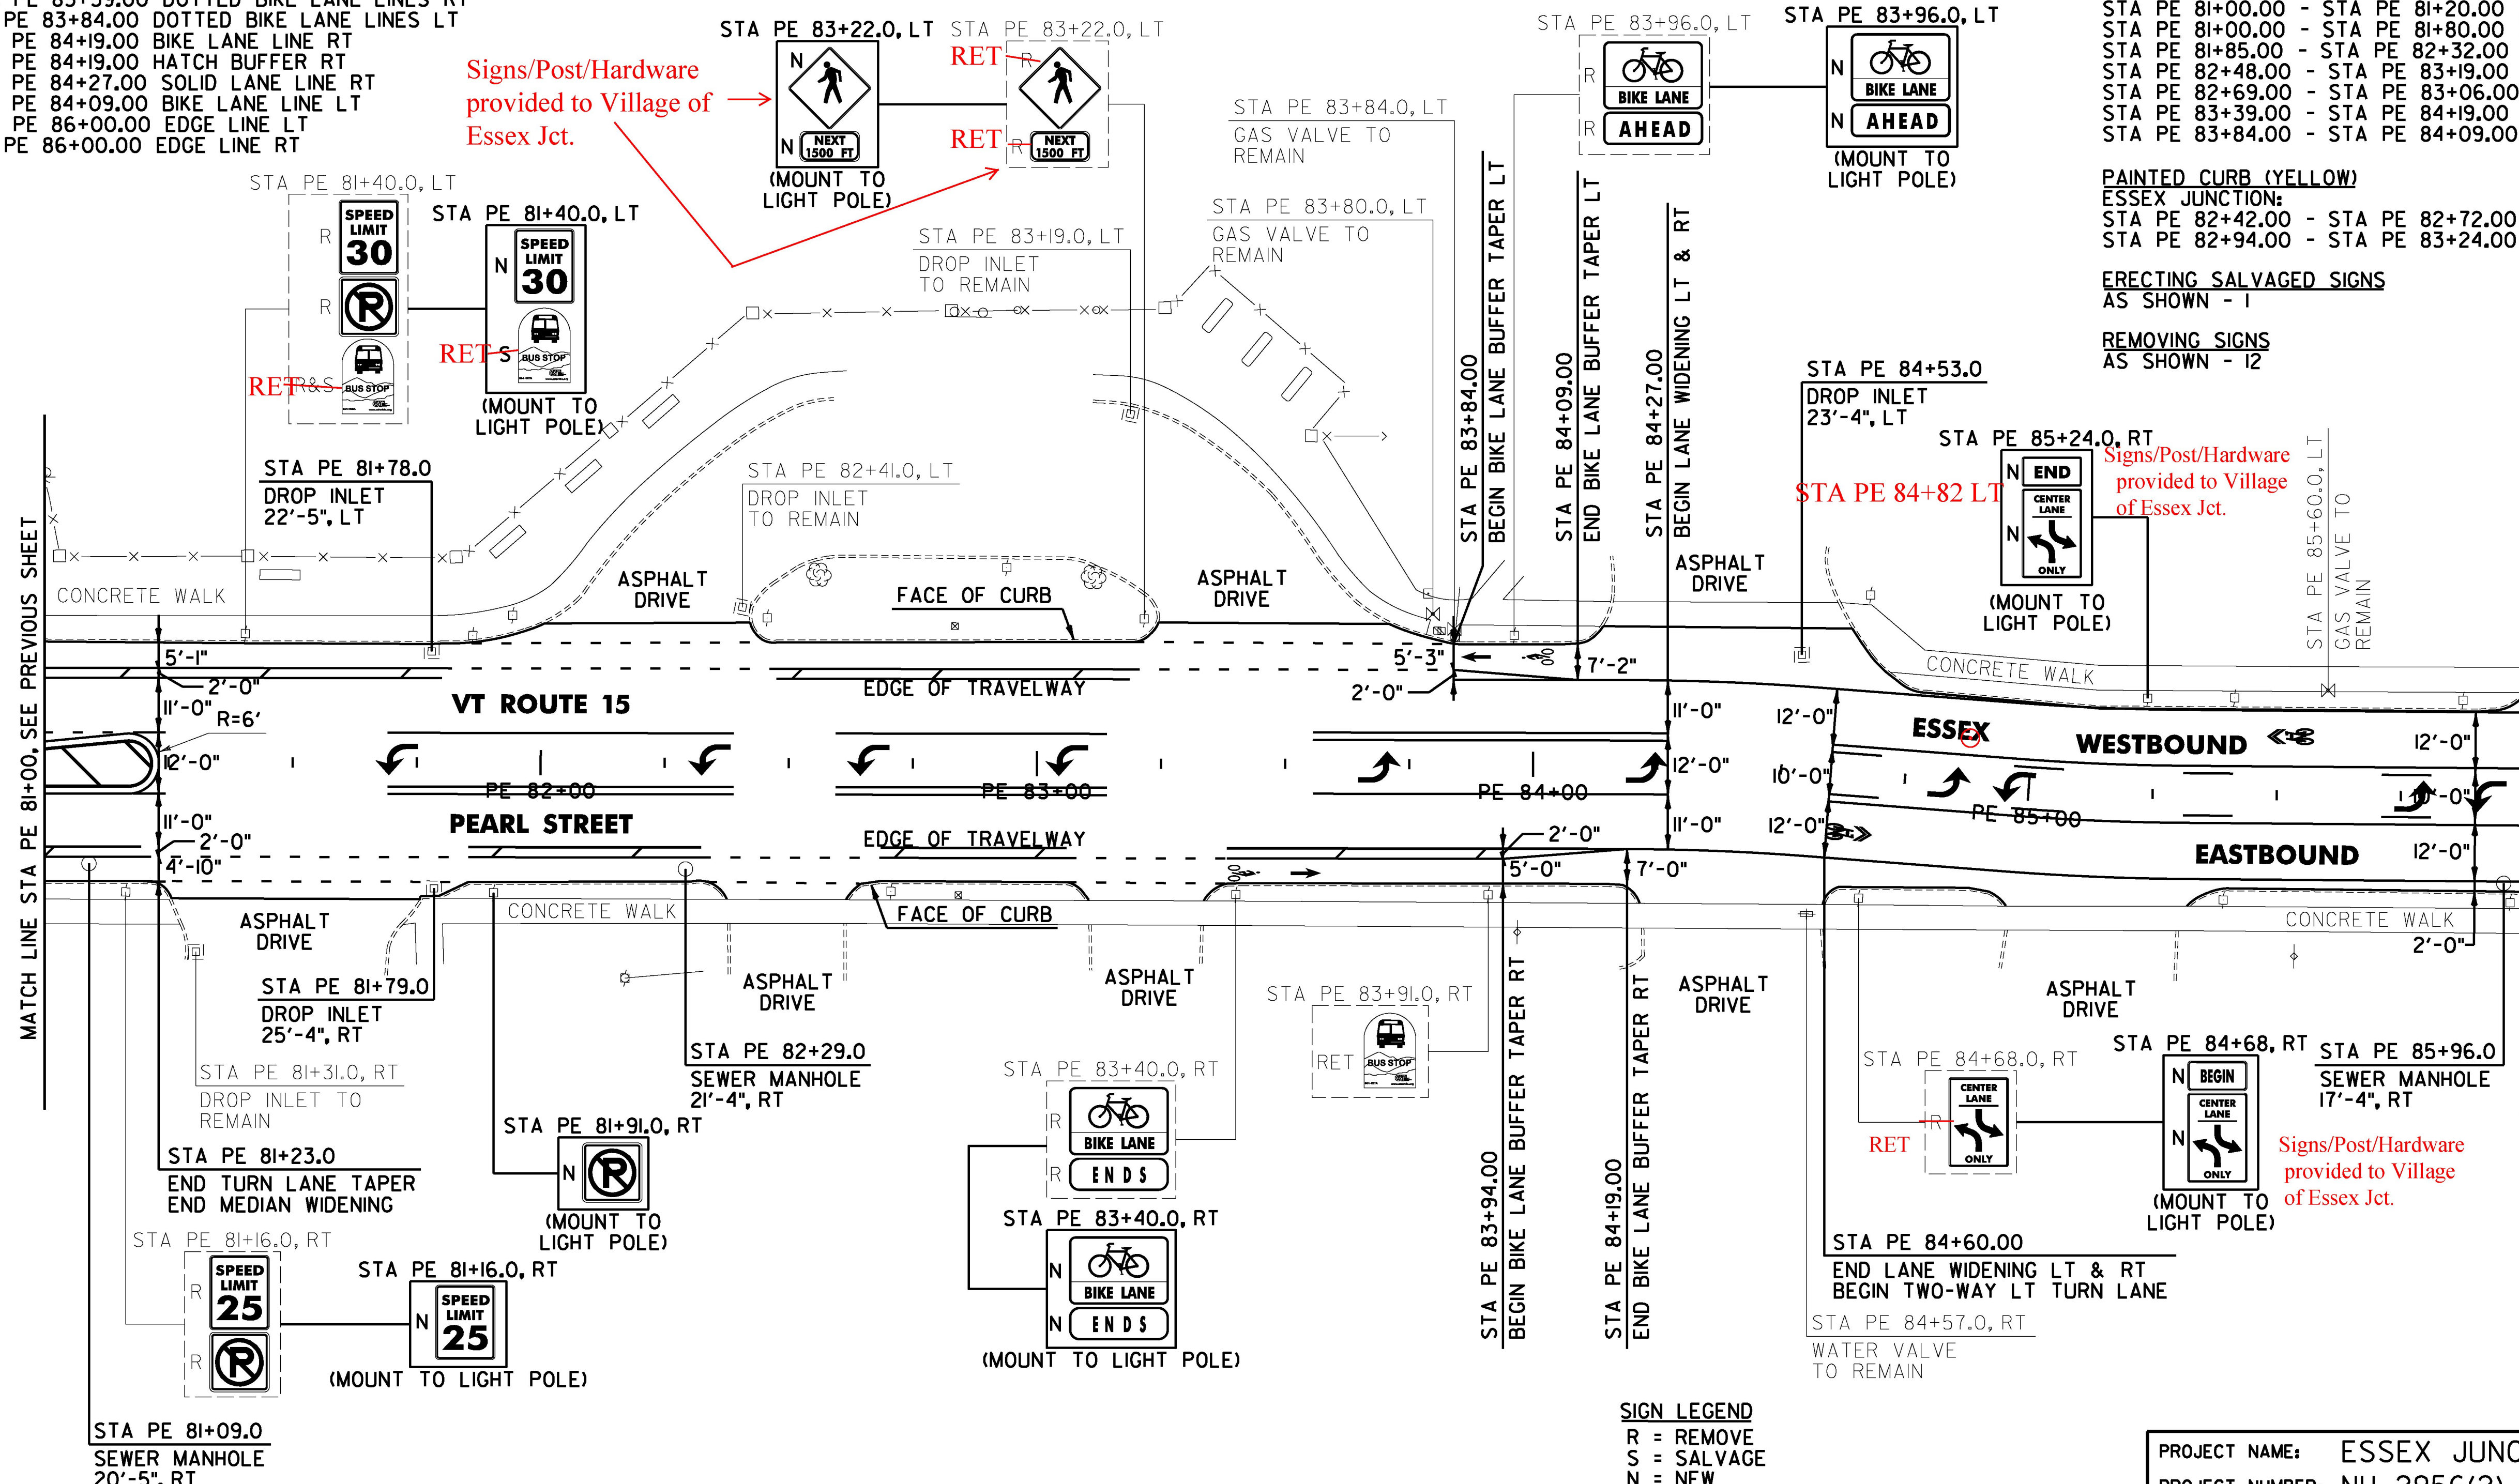

Signs/Post/Hardware provided to Village of Essex Jct.

Signs/Post/Hardware provided to Village of Essex Jct.

Signs/Post/Hardware provided to Village of Essex Jct.

- SIGN LEGEND**
- R = REMOVE
 - S = SALVAGE
 - N = NEW
 - RET = RETAIN
 - B-B = BACK TO BACK
 - EXISTING = - - - - -
 - NEW = _____
 - R = RETURN TO VILLAGE OF ESSEX JUNCTION



PROJECT NAME:	ESSEX JUNCTION
PROJECT NUMBER:	NH 2956(2)
FILE NAME:	z15v026bdr.dgn
PLOT DATE:	4/19/2016
PROJECT LEADER:	D.GOZALKOWSKI
DRAWN BY:	C. KAHLBAUGH
DESIGNED BY:	J. SCUDDER
CHECKED BY:	J. SHIELDS
PLAN SHEET 12	SHEET 94 OF 171

- REHAB. DROP INLETS, CATCH BASINS, OR MANHOLES, CLASS I, II OR III**
- ESSEX JUNCTION:
- STA PE 81+78.0 LT
 - STA PE 81+79.0 RT
 - STA PE 84+53.0 LT
 - STA PE 82+29.0 RT
 - STA PE 85+96.0 RT
- CHANGING ELEVATION OF SEWER MANHOLES**
- ESSEX JUNCTION:
- STA PE 81+09.0 RT
 - STA PE 82+29.0 RT
 - STA PE 85+96.0 RT

MATCH LINE STA PE 81+00, SEE PREVIOUS SHEET

MATCH LINE STA PE 86+00, SEE NEXT SHEET

