


24 INCH STOP BAR, LOW VOC CHLORINATED RUBBER PAINT AND TEMPORARY 24 INCH STOP BAR, PAINT  
 ESSEX JUNCTION:  
 STA PE 90+63.00 LT & RT  
 8 INCH YELLOW LINE, LOW VOC CHLORINATED RUBBER PAINT  
 ESSEX JUNCTION:  
 STA PE 86+56.00 - STA PE 86+86.00 HATCHED MEDIAN LT & RT

4 INCH WHITE LINE, LOW VOC CHLORINATED RUBBER PAINT AND TEMPORARY 4 INCH WHITE LINE, PAINT  
 (ALL LINES WILL INCLUDE EDGE LINE BREAKS AND RADIUS FOR TOWN HIGHWAYS)  
 ESSEX JUNCTION:  
 STA PE 86+00.00 - STA PE 90+80.00 EDGE LINE LT & RT  
 STA PE 87+10.00 - STA PE 88+62.00 SOLID LANE LINE LT  
 STA PE 88+62.00 - STA PE 89+62.00 DOTTED LANE LINE LT & RT  
 STA PE 89+62.00 - STA PE 90+64.00 SOLID LANE LINE RT

TEMPORARY LETTER OR SYMBOL, PAINT  
 ESSEX JUNCTION:  
 STA PE 86+71.00 RT, SHARED LANE SYMBOL (2 EA)  
 STA PE 87+14.00 C/L, ARROW (2 EA)  
 STA PE 88+04.00 LT, SHARED LANE SYMBOL (2 EA)  
 STA PE 88+58.00 RT, SHARED LANE SYMBOL (2 EA)  
 STA PE 88+58.00 C/L, ARROW (2 EA)  
 STA PE 89+66.00 C/L, ARROW (2 EA)  
 STA PE 90+54.00 C/L, ARROW (2 EA)  
 STA PE 90+54.00 LT, SHARED LANE SYMBOL (2 EA)

LETTER OR SYMBOL, LOW VOC CHLORINATED RUBBER PAINT  
 ESSEX JUNCTION:  
 STA PE 86+71.00 RT, SHARED LANE SYMBOL (1 EA)  
 STA PE 87+14.00 C/L, ARROW (1 EA)  
 STA PE 87+86.00 C/L, "O,N,L,Y" (4 EA)  
 STA PE 88+04.00 LT, SHARED LANE SYMBOL (1 EA)  
 STA PE 88+58.00 RT, SHARED LANE SYMBOL (1 EA)  
 STA PE 88+58.00 C/L, ARROW (1 EA)  
 STA PE 89+66.00 C/L, ARROW (1 EA)  
 STA PE 90+10.00 C/L, "O,N,L,Y" (4 EA)  
 STA PE 90+54.00 C/L, ARROW (1 EA)  
 STA PE 90+54.00 LT, SHARED LANE SYMBOL (1 EA)

REMOVING SIGNS AS SHOWN - 4

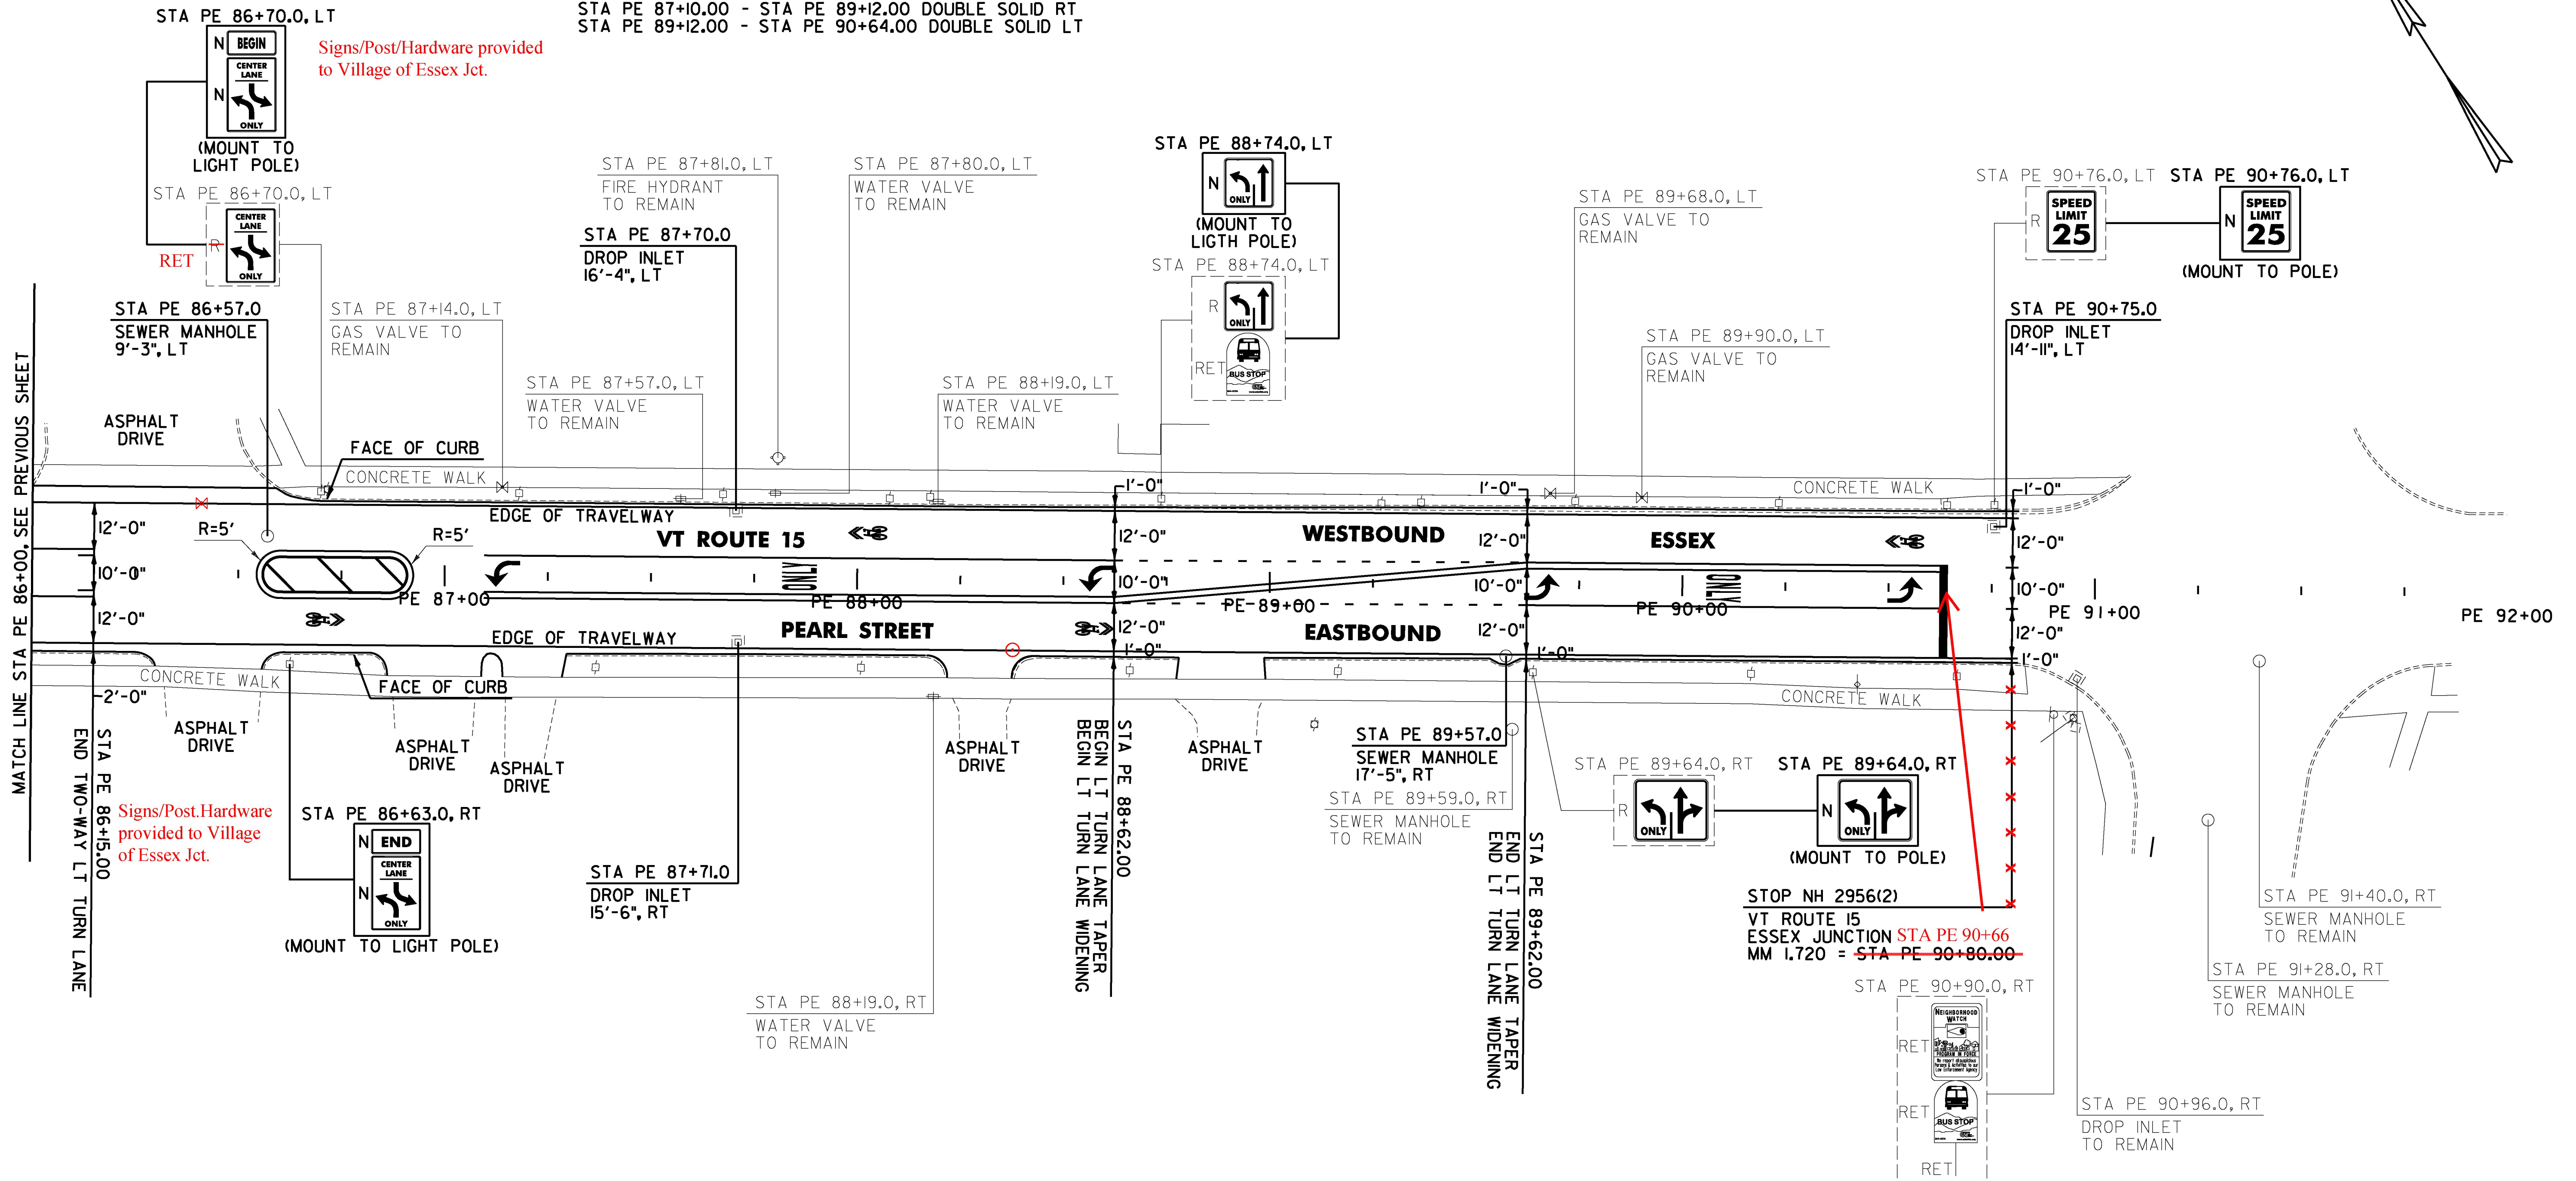

Signs/Post/Hardware provided to Village of Essex Jct.

Signs/Post/Hardware provided to Village of Essex Jct.

REHAB. DROP INLETS, CATCH BASINS, OR MANHOLES, CLASS I, II OR III

ESSEX JUNCTION:  
~~STA PE 87+70.0 LT~~  
~~STA PE 87+71.0 RT~~  
~~STA PE 90+75.0 LT~~

CHANGING ELEVATION OF SEWER MANHOLES  
 ESSEX JUNCTION:  
 STA PE 86+57.0 LT PE 87+70 LT  
 STA PE 89+57.0 RT PE 88+32 RT

ADJUST ELEVATION OF VALVE BOX  
 PE 86+45 LT

SIGN LEGEND  
 R = REMOVE  
 S = SALVAGE  
 N = NEW  
 RET = RETAIN  
 B-B = BACK TO BACK  
 EXISTING = \_\_\_\_\_  
 NEW = \_\_\_\_\_  
 R = RETURN TO VILLAGE OF ESSEX JUNCTION

NOT TO SCALE



PROJECT NAME: ESSEX JUNCTION  
 PROJECT NUMBER: NH 2956(2)

FILE NAME: z15v026bdr.dgn  
 PROJECT LEADER: D.GOZALKOWSKI  
 DESIGNED BY: J. SCUDDER  
 PLAN SHEET 13

PLOT DATE: 4/19/2016  
 DRAWN BY: C. KAHLBAUGH  
 CHECKED BY: J. SHIELDS  
 SHEET 95 OF 171