



4 INCH WHITE LINE, LOW VOC CHLORINATED RUBBER PAINT AND TEMPORARY 4 INCH WHITE LINE, PAINT  
 (ALL LINES WILL INCLUDE EDGE LINE BREAKS AND RADIUS FOR TOWN HIGHWAYS)  
 ESSEX JUNCTION:  
 STA MN 127+00.00 - STA MN 132+00.00 EDGE LINE LT & RT  
 STA MN 129+04.32 EDGE LINE LT, GROVE STREET

24 INCH STOP BAR, LOW VOC CHLORINATED RUBBER PAINT AND TEMPORARY 24 INCH STOP BAR, PAINT  
 ESSEX JUNCTION:  
 STA MN 129+04.32 LT, GROVE STREET

4 INCH YELLOW LINE, LOW VOC CHLORINATED RUBBER PAINT AND TEMPORARY 4 INCH YELLOW LINE, PAINT  
 (ALL LINES WILL INCLUDE C/L LINE BREAKS FOR TOWN HIGHWAYS)  
 S = SOLID, D = DASHED  
 ESSEX JUNCTION:  
 STA MN 127+00.00 - STA MN 131+06.00 LT & RT  
 STA MN 131+06.00 - STA MN 132+00.00 DOUBLE SOLID MEDIAN LT & RT  
 STA MN 129+04.32 DOUBLE SOLID LT, GROVE STREET

8 INCH YELLOW LINE, LOW VOC CHLORINATED RUBBER PAINT  
 ESSEX JUNCTION:  
 STA MN 131+06.00 - STA MN 132+00.00 HATCHED MEDIAN LT & RT  
 8 INCH WHITE LINE, LOW VOC CHLORINATED RUBBER PAINT  
 ESSEX JUNCTION:  
 STA MN 129+45.00 - STA MN 129+57.00 LT, FIRE HYDRANT, NO PARKING  
 CROSSWALK MARKING, LOW VOC CHLORINATED RUBBER PAINT AND TEMPORARY CROSSWALK MARKING, PAINT  
 ESSEX JUNCTION:  
 STA MN 128+83.00 LT & RT  
 STA MN 129+04.32 LT, GROVE STREET

REMOVING SIGNS AS SHOWN - 10

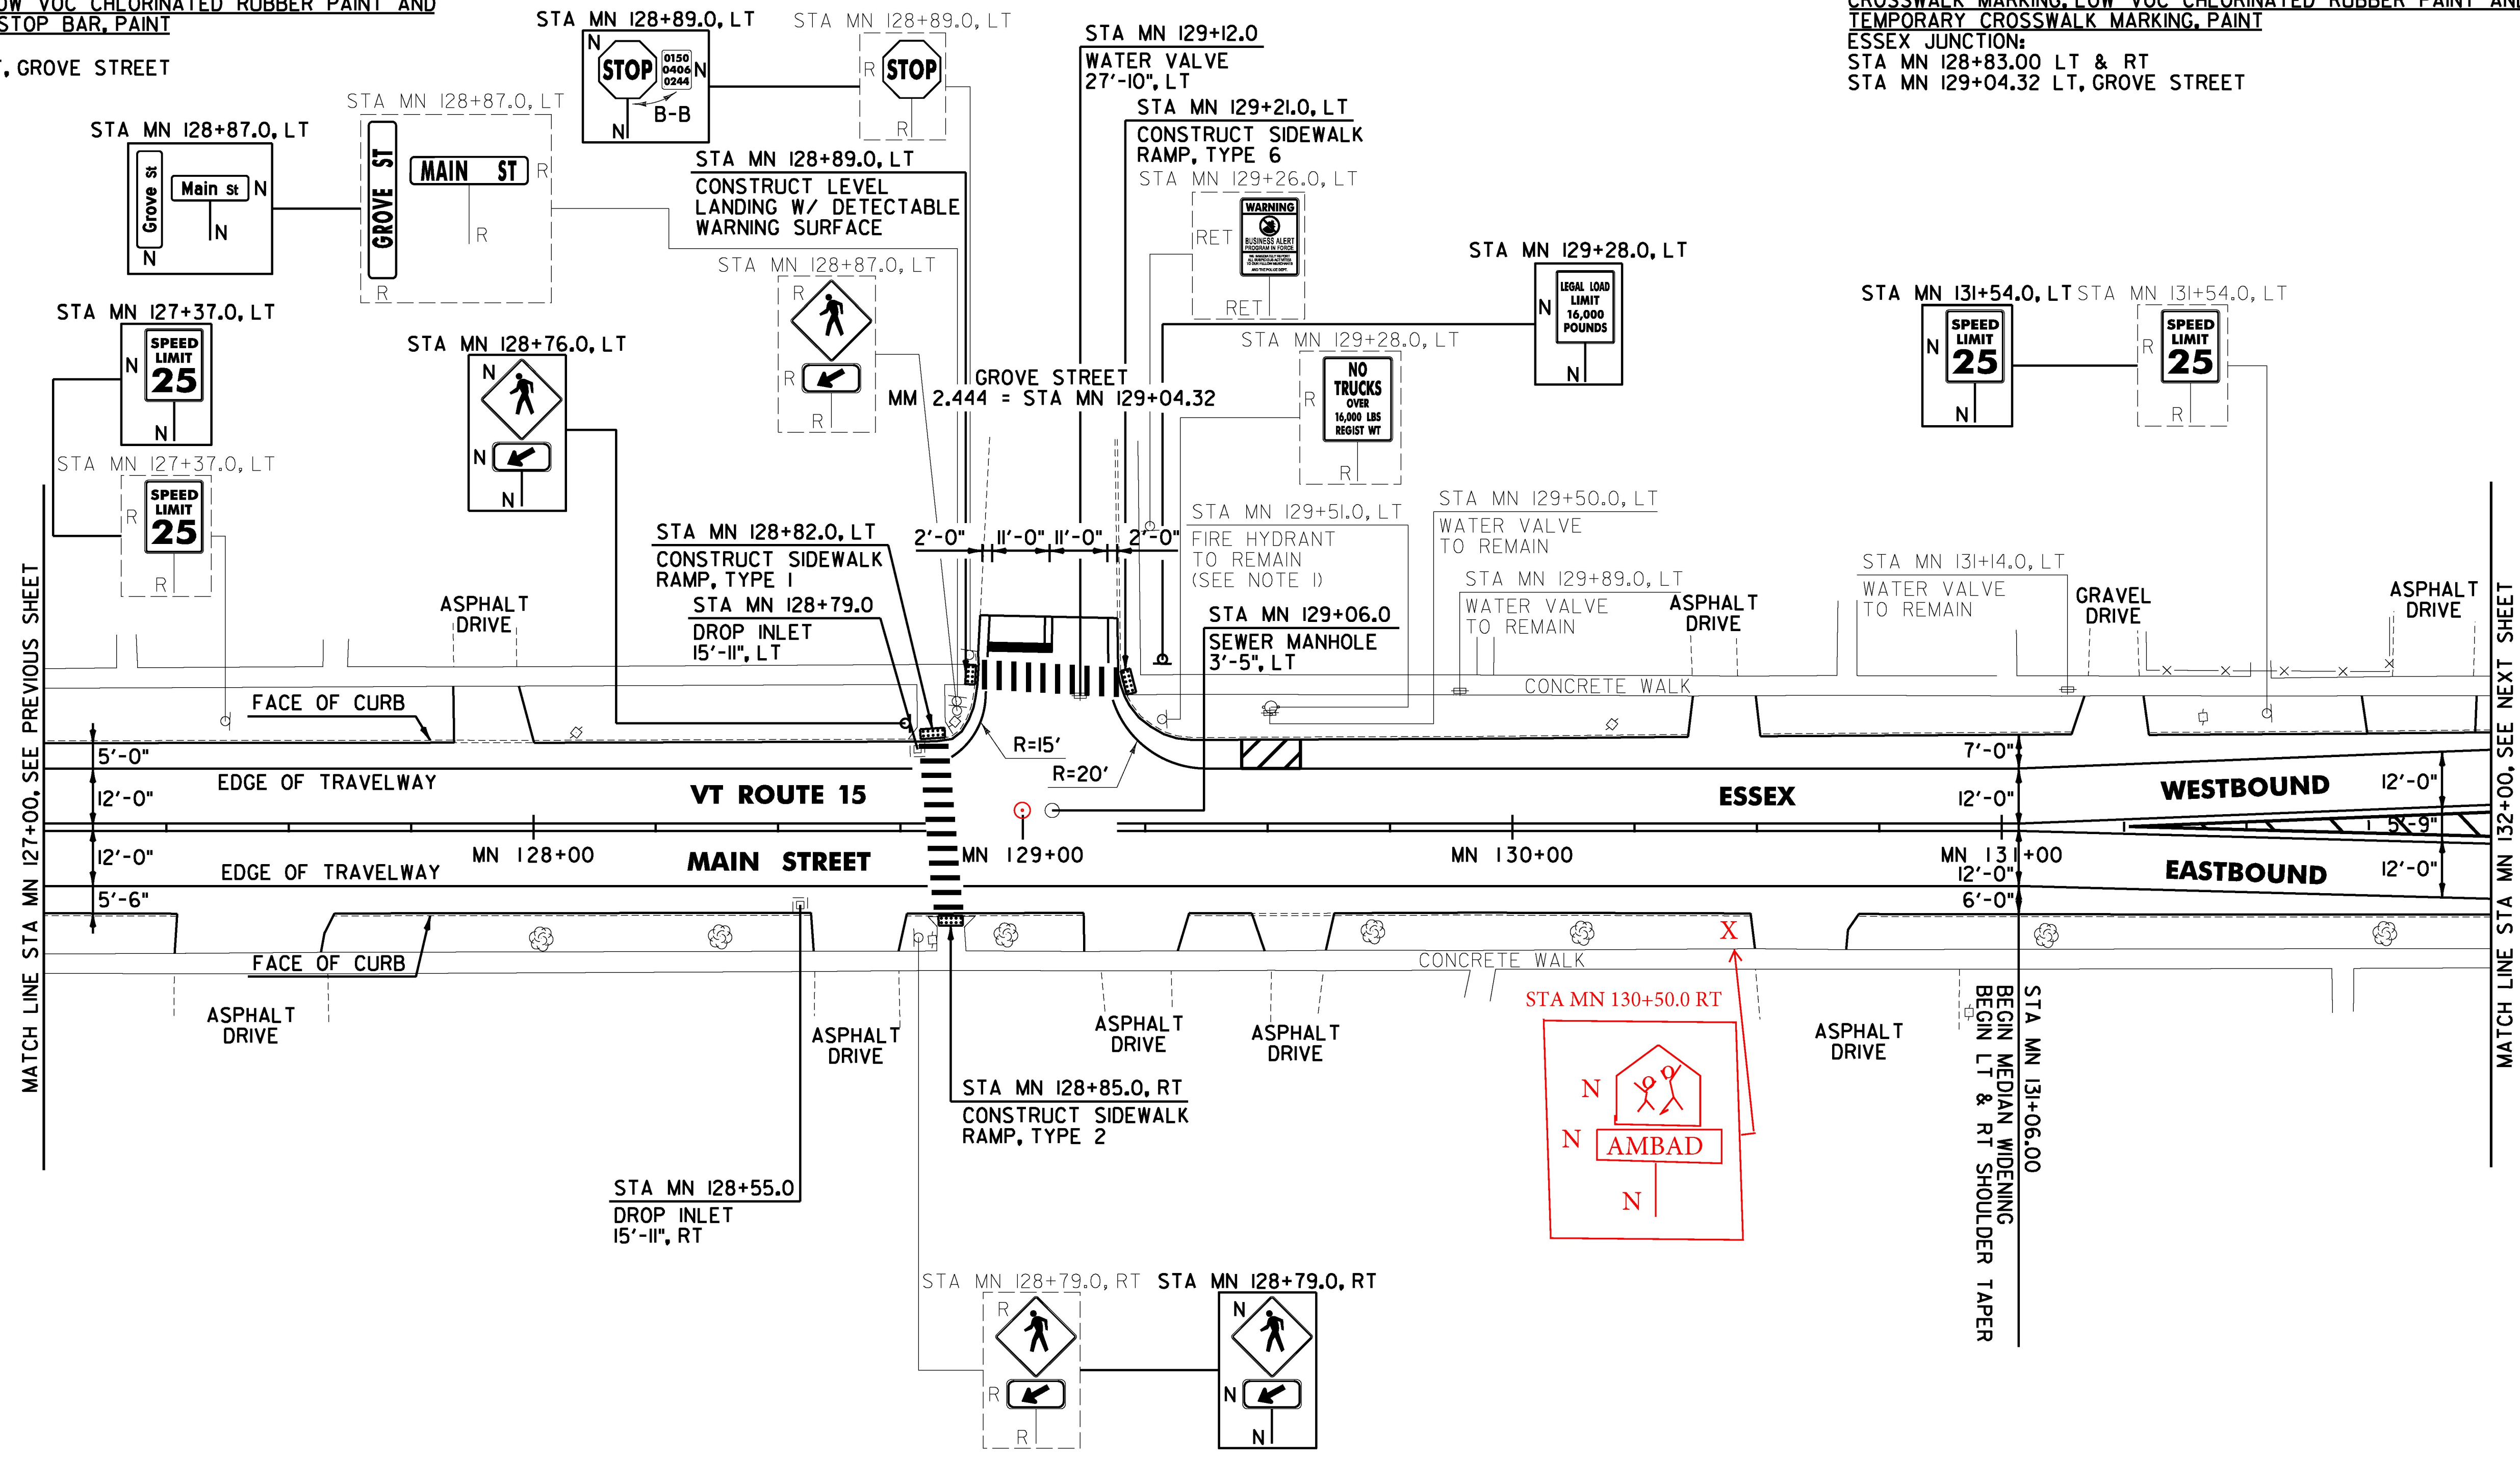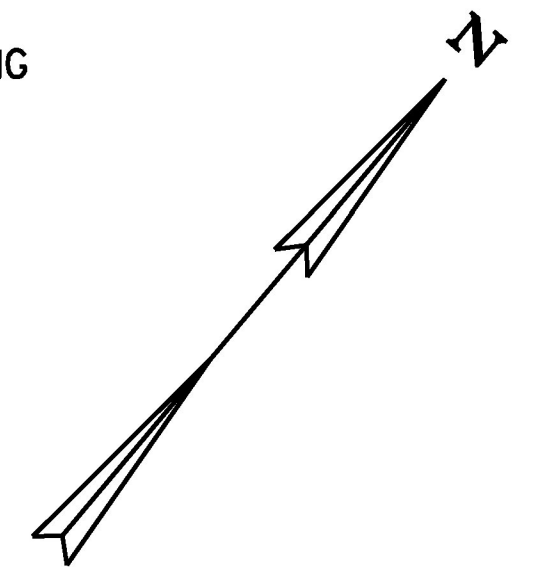

**DETECTABLE WARNING SURFACE**  
 ESSEX JUNCTION:  
 STA MN 128+82.0 LT  
 STA MN 128+85.0 RT  
 STA MN 128+89.0 LT  
 STA MN 129+21.0 LT

**REMOVAL OF EXISTING CURB**  
 ESSEX JUNCTION:  
 STA MN 128+82.0 LT  
 STA MN 128+85.0 RT  
 STA MN 128+89.0 LT  
 STA MN 129+21.0 LT

**CHANGING ELEVATION OF SEWER MANHOLES**  
 ESSEX JUNCTION:  
~~STA MN 129+06.0 LT~~ MN 129+00 LT

**REHAB. DROP INLETS, CATCH BASINS, OR MANHOLES, CLASS I, II OR III**  
 ESSEX JUNCTION:  
 STA MN 128+55.0 RT MN 129+06 LT  
 STA MN 128+79.0 LT

**ADJUST ELEVATION OF VALVE BOX**  
 ESSEX JUNCTION:  
 STA MN 129+12.0 LT

**PORTLAND CEMENT CONCRETE SIDEWALK, 5 INCH**  
 ESSEX JUNCTION:  
 STA MN 128+82.0 LT  
 STA MN 128+85.0 RT  
 STA MN 128+89.0 LT  
 STA MN 129+21.0 LT

**CAST-IN-PLACE CONCRETE CURB, TYPE B**  
 ESSEX JUNCTION:  
 STA MN 128+82.0 LT  
 STA MN 128+85.0 RT  
 STA MN 128+89.0 LT  
 STA MN 129+21.0 LT

**SIGN LEGEND**  
 R = REMOVE  
 S = SALVAGE  
 N = NEW  
 RET = RETAIN  
 B-B = BACK TO BACK  
 EXISTING =   
 NEW =   
 RETURN TO VILLAGE OF ESSEX JUNCTION

**NOT TO SCALE**

**NOTE:**  
 I. SEE SHEET 10 FOR FIRE HYDRANT PAVEMENT MARKING DETAIL.

PROJECT NAME: ESSEX JUNCTION	PLOT DATE: 4/19/2016
PROJECT NUMBER: NH 2956(2)	DRAWN BY: C. KAHLBAUGH
FILE NAME: z15v026bdr.dgn	CHECKED BY: J. SHIELDS
PROJECT LEADER: D.GOZALKOWSKI	SHEET 98 OF 171
DESIGNED BY: J. SCUDDER	
PLAN SHEET 16	