

4 INCH WHITE LINE, LOW VOC CHLORINATED RUBBER PAINT AND TEMPORARY 4 INCH WHITE LINE, PAINT
 (ALL LINES WILL INCLUDE EDGE LINE BREAKS AND RADIUS FOR TOWN HIGHWAYS)
 ESSEX JUNCTION:
 STA MN 132+00.00 - STA MN 137+00.00 EDGE LINE LT & RT
 STA MN 132+31.68 EDGE LINES RT, PLEASANT STREET
 STA MN 132+54.00 - STA MN 132+94.00 SOLID LANE LINE LT
 STA MN 132+94.00 - STA MN 133+94.00 DOTTED LANE LINE LT & RT
 STA MN 133+94.00 - STA MN 134+44.00 SOLID LANE LINE RT
 STA MN 134+90.40 SOLID LANE LINE LT, EDUCATIONAL DRIVE
 STA MN 134+90.40 EDGE LINE LT, EDUCATIONAL DRIVE


CROSSWALK MARKING, LOW VOC CHLORINATED RUBBER PAINT AND TEMPORARY CROSSWALK MARKING, PAINT
 ESSEX JUNCTION:
 STA MN 132+31.68 RT, PLEASANT STREET
 STA MN 132+48.00 LT & RT

24 INCH STOP BAR, LOW VOC CHLORINATED RUBBER PAINT AND TEMPORARY 24 INCH STOP BAR, PAINT
 ESSEX:
 STA MN 132+31.68 RT, PLEASANT STREET
 STA MN 134+90.40 LT, EDUCATIONAL DRIVE

4 INCH YELLOW LINE, LOW VOC CHLORINATED RUBBER PAINT AND TEMPORARY 4 INCH YELLOW LINE, PAINT
 (ALL LINES WILL INCLUDE C/L LINE BREAKS FOR TOWN HIGHWAYS)
 S = SOLID, D = DASHED
 ESSEX JUNCTION:
 STA MN 135+90.00 - STA MN 137+00.00 LT & RT
 STA MN 132+00.00 - STA MN 132+13.00 DOUBLE SOLID MEDIAN LT & RT
 STA MN 132+31.68 DOUBLE SOLID RT, PLEASANT STREET
 STA MN 132+54.00 - STA MN 133+52.00 DOUBLE SOLID RT
 STA MN 133+52.00 - STA MN 134+44.00 DOUBLE SOLID LT
 STA MN 134+90.40 MEDIAN EDGE LINES LT, EDUCATIONAL DRIVE
 STA MN 135+15.00 - STA MN 135+90.00 DOUBLE SOLID MEDIAN LT & RT

8 INCH YELLOW LINE, LOW VOC CHLORINATED RUBBER PAINT
 ESSEX JUNCTION:
 STA MN 132+00.00 - STA MN 132+13.00 HATCHED MEDIAN LT & RT
 STA MN 135+15.00 - STA MN 135+90.00 HATCHED MEDIAN LT & RT

MN 135+97 LT REMOVING SIGNS AS SHOWN - 16
 ERECTING SALVAGED SIGNS AS SHOWN - 3

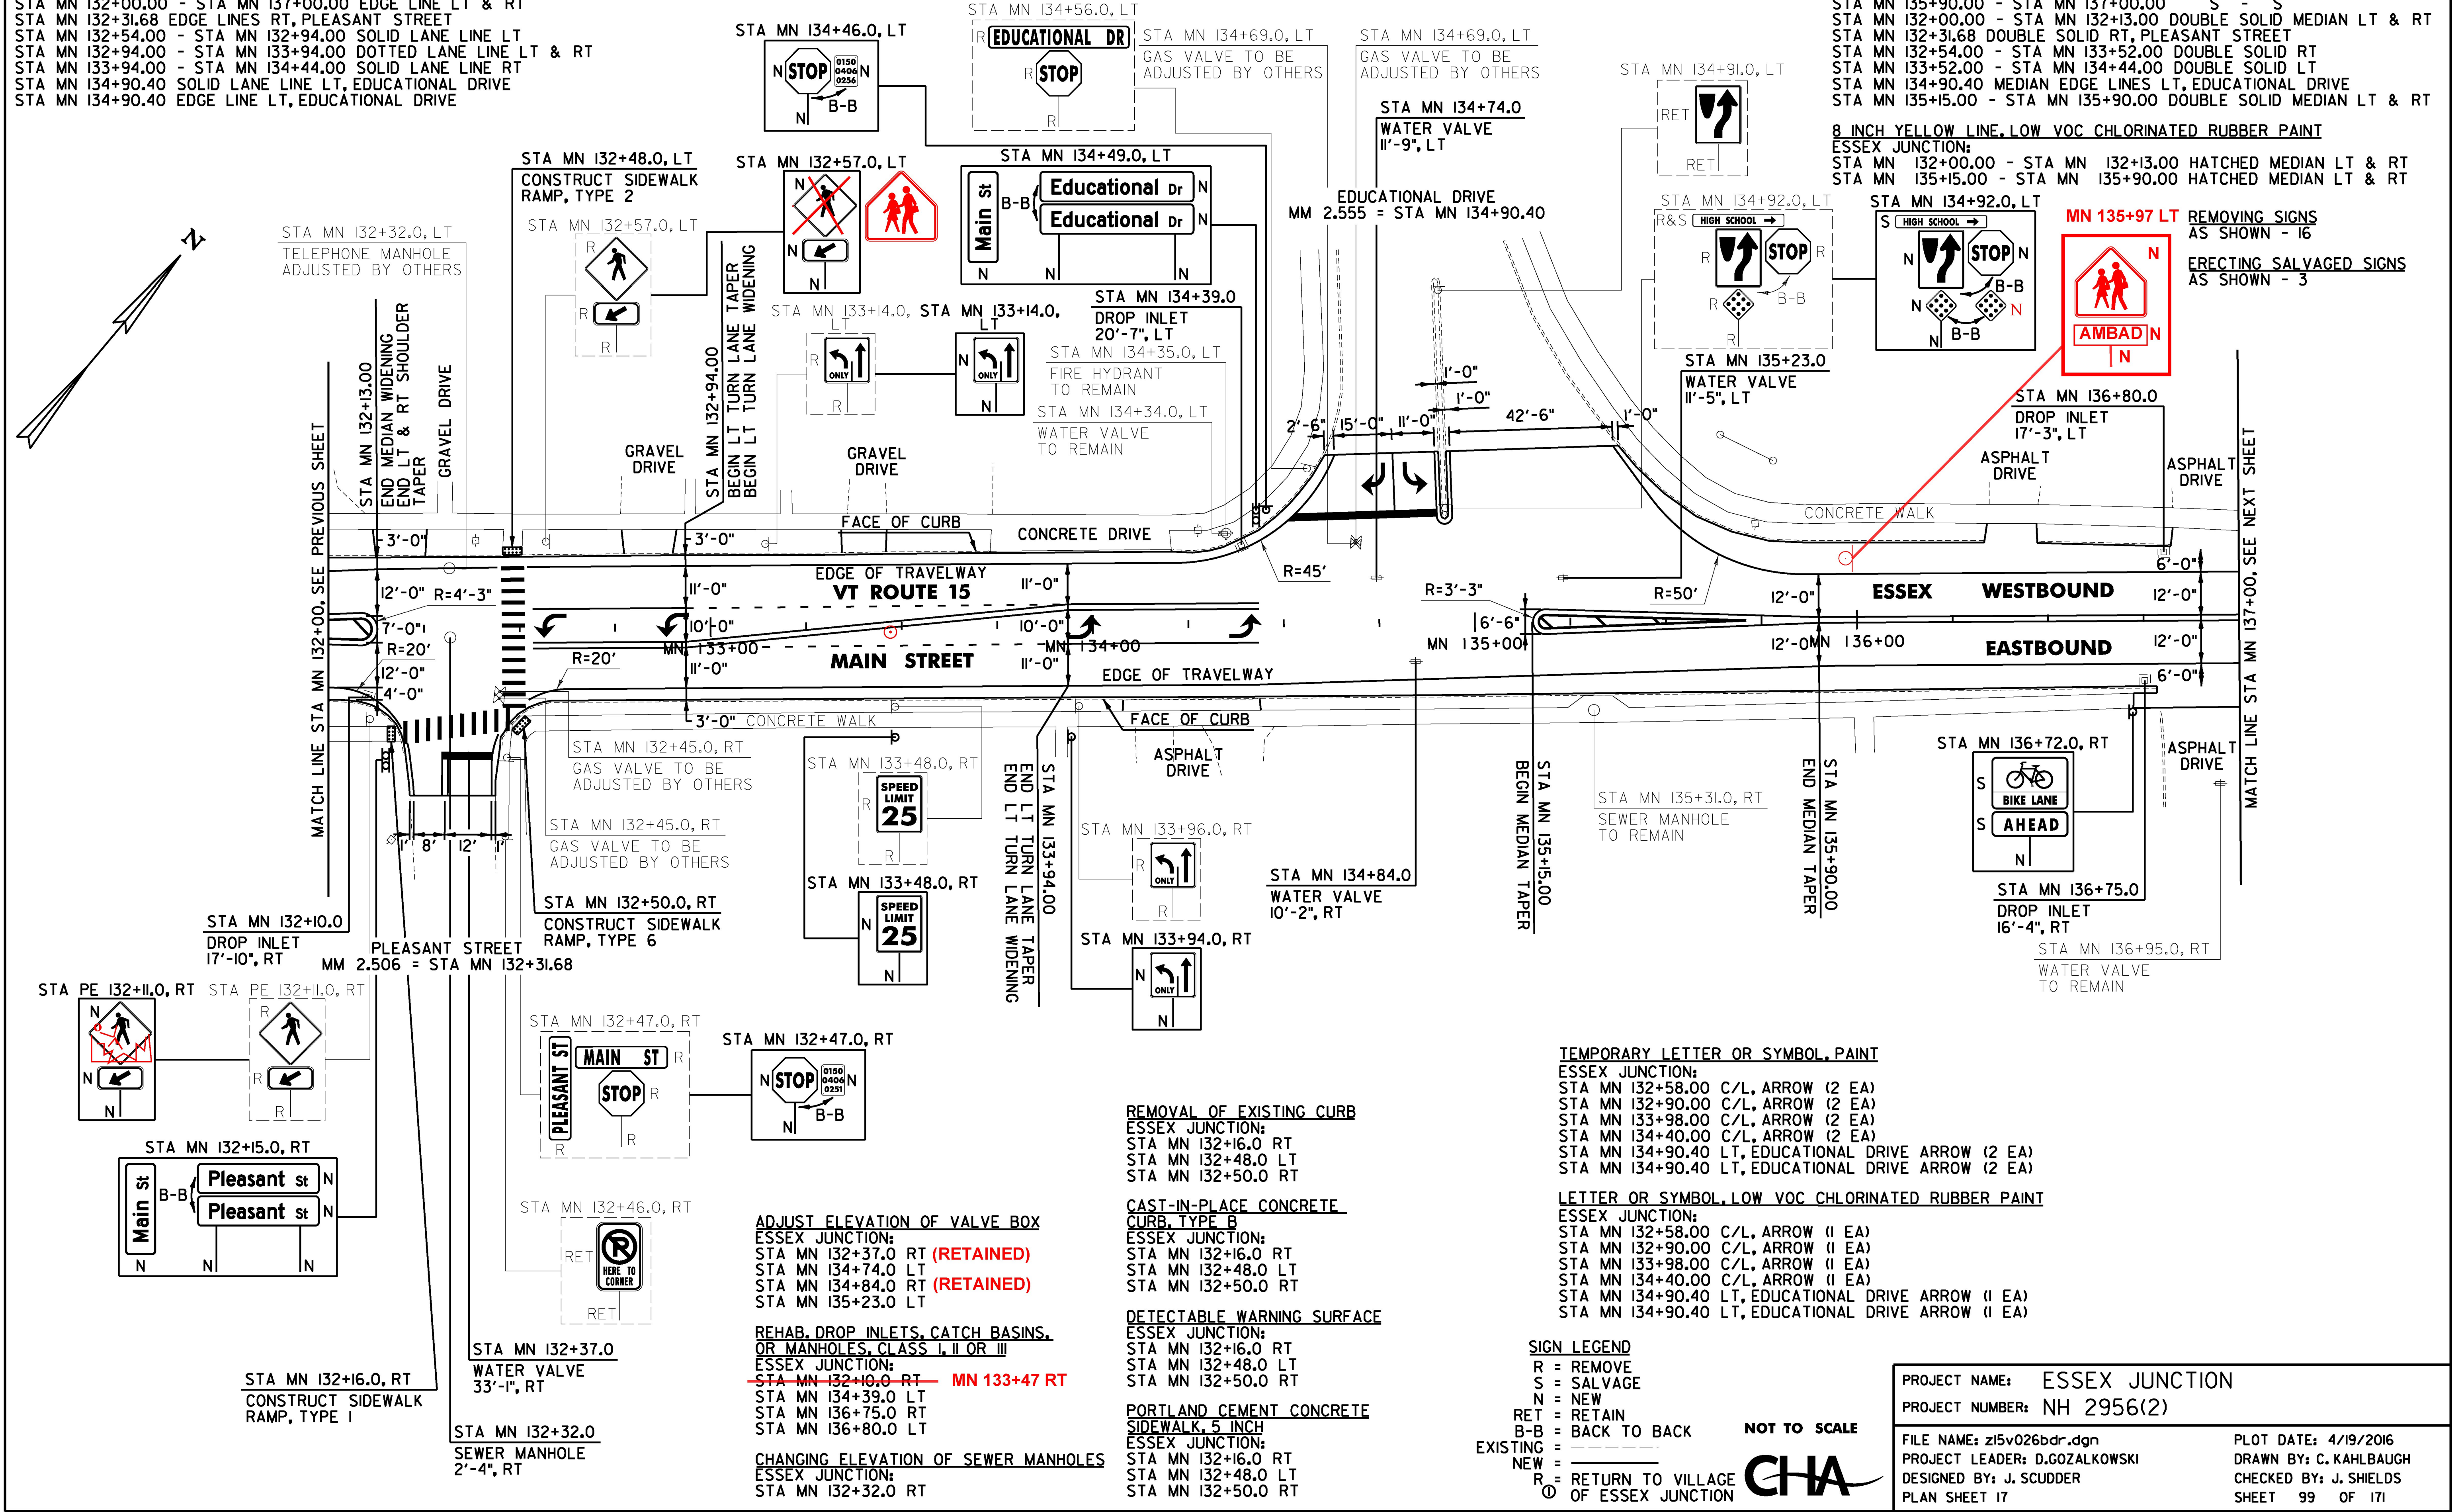

TEMPORARY LETTER OR SYMBOL, PAINT
 ESSEX JUNCTION:
 STA MN 132+58.00 C/L, ARROW (2 EA)
 STA MN 132+90.00 C/L, ARROW (2 EA)
 STA MN 133+98.00 C/L, ARROW (2 EA)
 STA MN 134+40.00 C/L, ARROW (2 EA)
 STA MN 134+90.40 LT, EDUCATIONAL DRIVE ARROW (2 EA)
 STA MN 134+90.40 LT, EDUCATIONAL DRIVE ARROW (2 EA)

LETTER OR SYMBOL, LOW VOC CHLORINATED RUBBER PAINT
 ESSEX JUNCTION:
 STA MN 132+58.00 C/L, ARROW (1 EA)
 STA MN 132+90.00 C/L, ARROW (1 EA)
 STA MN 133+98.00 C/L, ARROW (1 EA)
 STA MN 134+40.00 C/L, ARROW (1 EA)
 STA MN 134+90.40 LT, EDUCATIONAL DRIVE ARROW (1 EA)
 STA MN 134+90.40 LT, EDUCATIONAL DRIVE ARROW (1 EA)

SIGN LEGEND
 R = REMOVE
 S = SALVAGE
 N = NEW
 RET = RETAIN
 B-B = BACK TO BACK
 EXISTING =
 NEW =
 ○ = RETURN TO VILLAGE OF ESSEX JUNCTION

NOT TO SCALE

CHA

PROJECT NAME: ESSEX JUNCTION
 PROJECT NUMBER: NH 2956(2)
 FILE NAME: z15v026bdr.dgn
 PROJECT LEADER: D.GOZALKOWSKI
 PLAN SHEET 17

PLOT DATE: 4/19/2016
 DRAWN BY: C. KAHLBAUGH
 CHECKED BY: J. SHIELDS
 SHEET 99 OF 171