


4 INCH WHITE LINE, LOW VOC CHLORINATED RUBBER PAINT AND AND
 TEMPORARY 4 INCH WHITE LINE, PAINT
 (ALL LINES WILL INCLUDE EDGE LINE BREAKS AND
 RADIUS FOR TOWN HIGHWAYS)
 ESSEX JUNCTION:
 STA MN 147+00.00 - STA MN 147+92.00 DOTTED LANE LINE LT

6 INCH WHITE LINE, LOW VOC CHLORINATED RUBBER PAINT AND AND
 TEMPORARY 6 INCH WHITE LINE, PAINT
 (ALL LINES WILL INCLUDE EDGE LINE BREAKS AND
 RADIUS FOR TOWN HIGHWAYS)
 ESSEX JUNCTION:
 STA MN 147+00.00 - STA MN 151+32.00 BIKE LANE LINE RT
 STA MN 147+00.00 - STA MN 152+00.00 BIKE LANE LINE LT
 STA MN 151+32.00 - STA MN 152+00.00 DOTTED LANE LINE RT

4 INCH YELLOW LINE, LOW VOC CHLORINATED RUBBER PAINT AND
 TEMPORARY 4 INCH YELLOW LINE, PAINT
 (ALL LINES WILL INCLUDE C/L LINE BREAKS FOR TOWN HIGHWAYS)
 S = SOLID, D = DASHED
 ESSEX JUNCTION:
 STA MN 147+00.00 - STA MN 148+80.00 DOUBLE SOLID MEDIAN LT & RT
 STA MN 148+80.00 - STA MN 152+00.00 DOUBLE SOLID LT

8 INCH YELLOW LINE, LOW VOC CHLORINATED RUBBER PAINT
 ESSEX JUNCTION:
 STA MN 147+00.00 - STA MN 148+80.00 HATCH MEDIAN LT & RT

ERECTING SALVAGED SIGNS
 AS SHOWN - 1
 REMOVING SIGNS
 AS SHOWN - 4

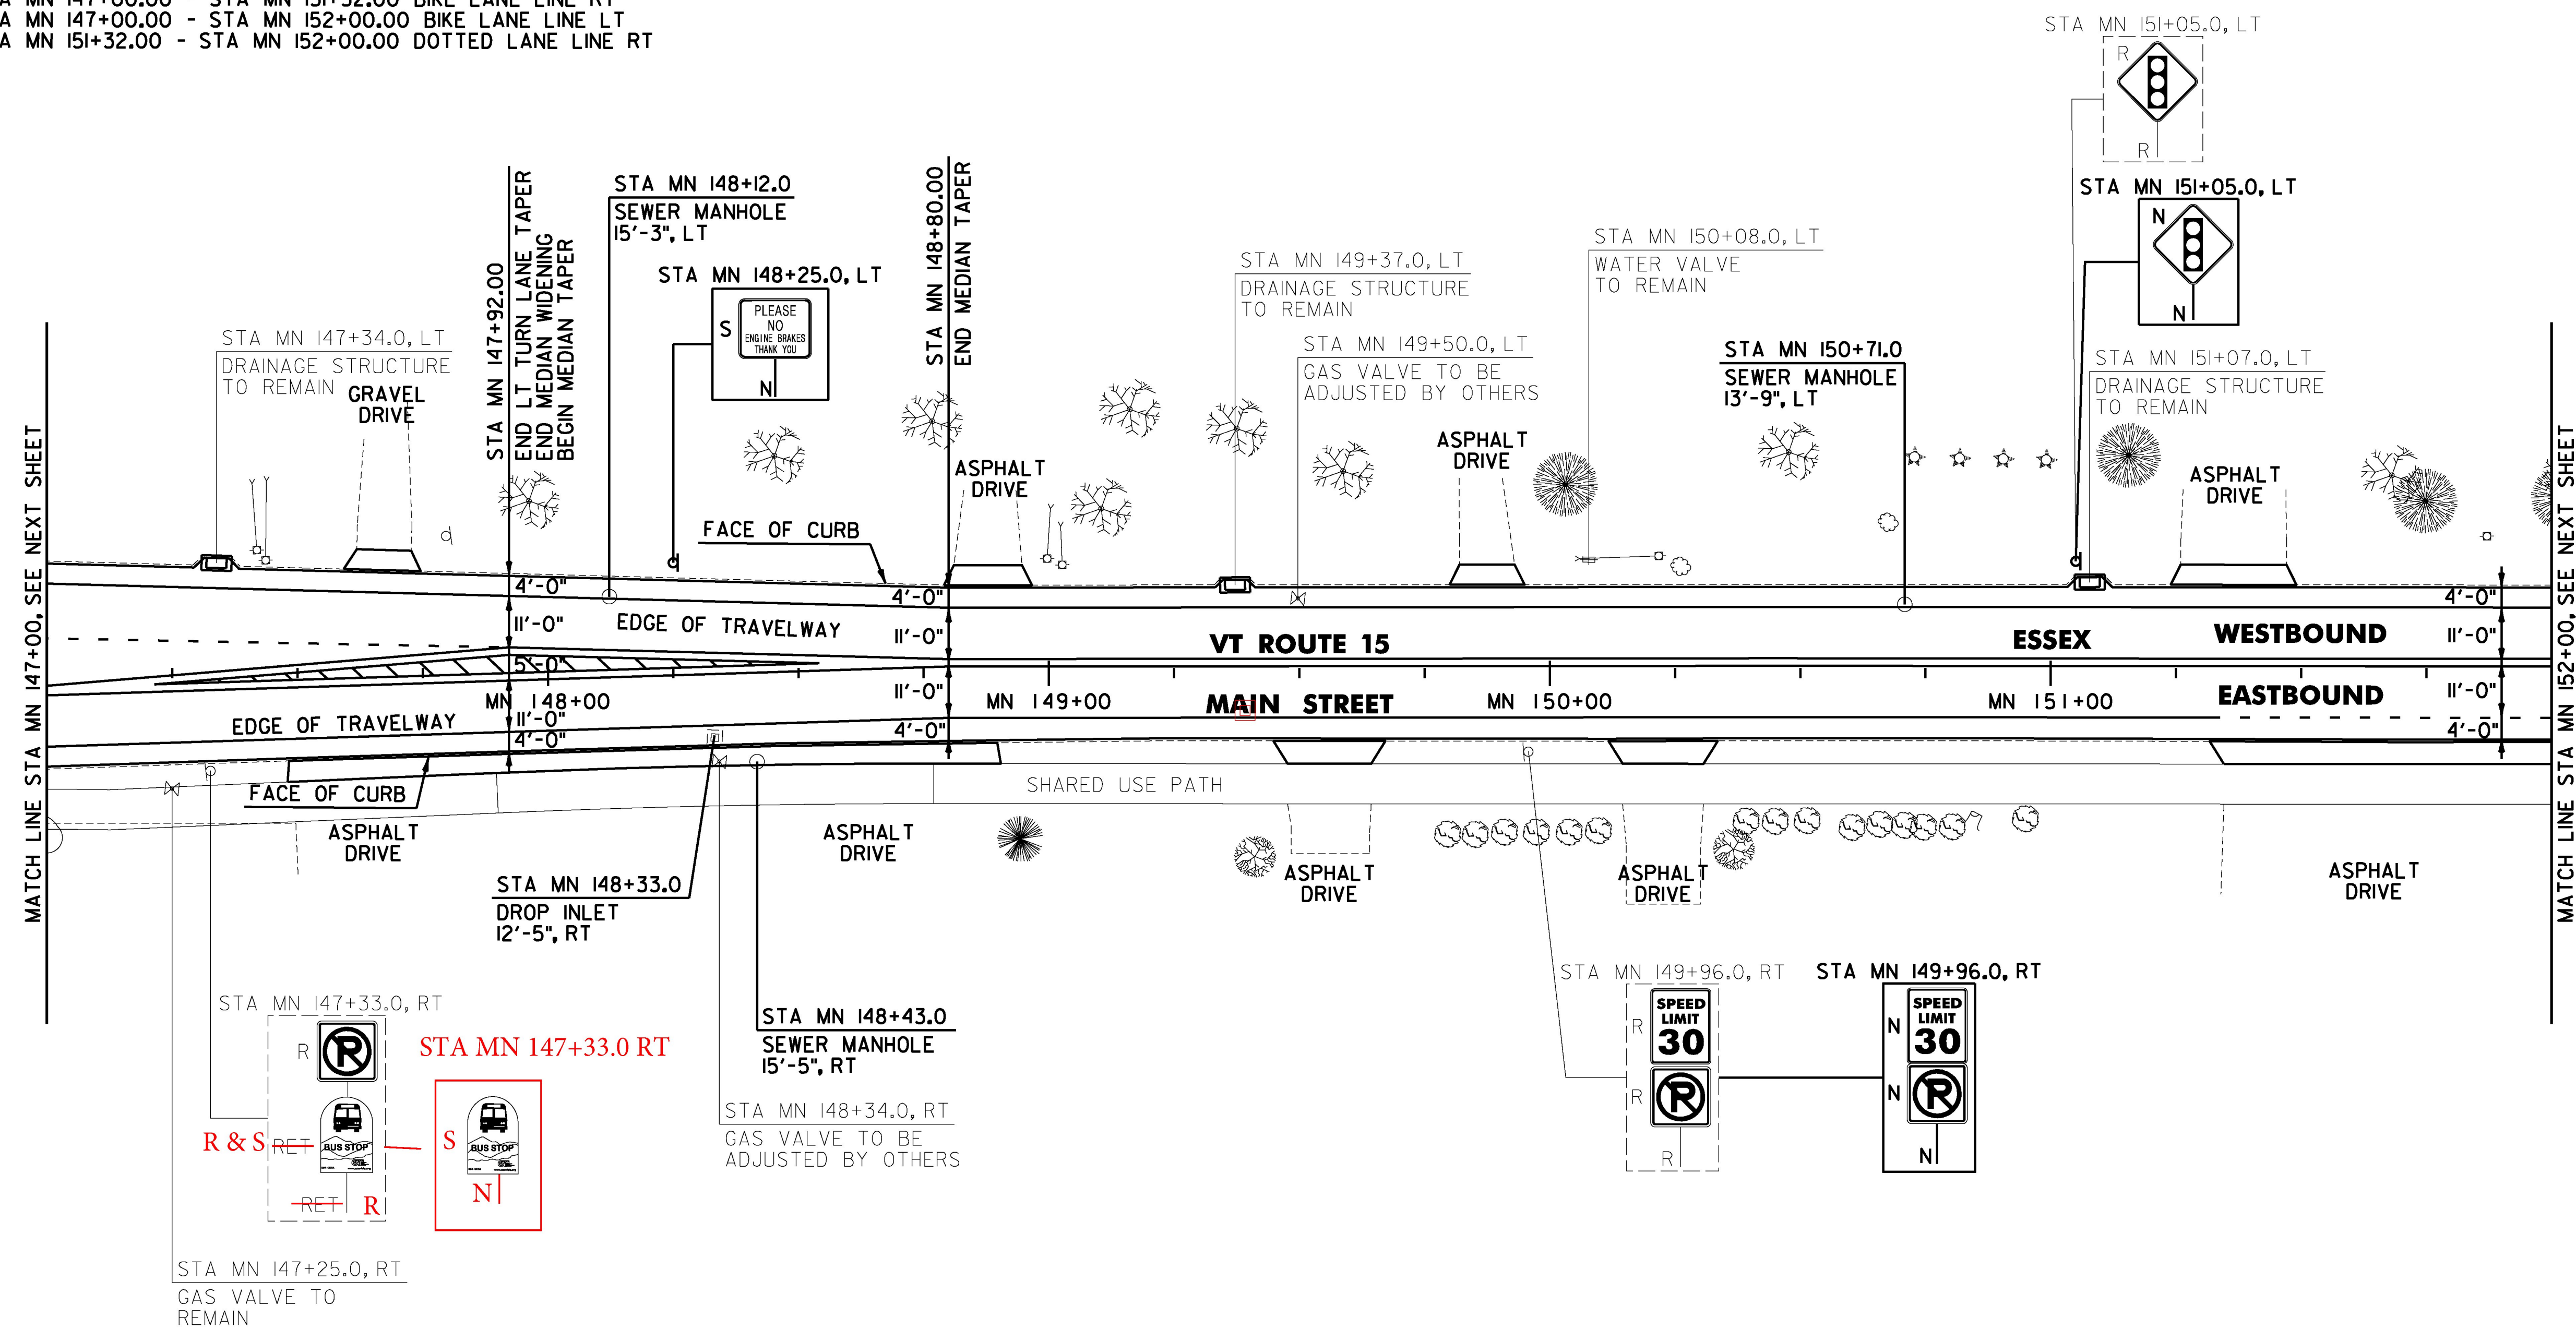

REHAB. DROP INLETS, CATCH BASINS,
 OR MANHOLES, CLASS I, II, OR III
 ESSEX JUNCTION:
 STA MN 148+33.0 RT MN 149+37 RT

CHANGING ELEVATION OF SEWER MANHOLES
 ESSEX JUNCTION:
 STA MN 148+12.0 LT
~~STA MN 148+43.0 RT~~
 STA MN 150+71.0 LT

SIGN LEGEND
 R = REMOVE
 S = SALVAGE
 N = NEW
 RET = RETAIN
 B-B = BACK TO BACK
 EXISTING = _____
 NEW = _____
 R = RETURN TO VILLAGE
 OF ESSEX JUNCTION

NOT TO SCALE



PROJECT NAME: ESSEX JUNCTION
 PROJECT NUMBER: NH 2956(2)

FILE NAME: z15v026bdr.dgn
 PROJECT LEADER: D.GOZALKOWSKI
 DESIGNED BY: J. SCUDDER
 PLAN SHEET 20

PLOT DATE: 4/19/2016
 DRAWN BY: C. KAHLBAUGH
 CHECKED BY: J. SHIELDS
 SHEET 102 OF 171