

4 INCH WHITE LINE, LOW VOC CHLORINATED RUBBER PAINT AND TEMPORARY 4 INCH WHITE LINE, PAINT  
 (ALL LINES WILL INCLUDE EDGE LINE BREAKS AND RADIUS FOR TOWN HIGHWAYS)  
 ESSEX JUNCTION:  
 STA MA 7+60.32 EDGE LINES RT, ELM STREET  
 STA MA 7+94.00 - STA MA 10+29.00 BIKE LANE LINE LT  
 STA MA 7+94.00 - STA MA 10+29.00 HATCH BUFFER LT  
 STA MA 8+12.00 - STA MA 12+00.00 BIKE LANE LINE RT  
 STA MA 8+12.00 - STA MA 12+00.00 HATCH BUFFER RT  
 STA MA 10+29.00 - STA MA 10+97.00 DOTTED BIKE LANE LINE LT  
 STA MA 10+61.28 EDGE LINES LT, EAST STREET  
 STA MA 10+97.00 - STA MA 12+00.00 BIKE LANE LINE LT  
 STA MA 10+97.00 - STA MA 12+00.00 HATCH BUFFER LT

6 INCH WHITE LINE, LOW VOC CHLORINATED RUBBER PAINT AND TEMPORARY 6 INCH WHITE LINE, PAINT  
 (ALL LINES WILL INCLUDE EDGE LINE BREAKS AND RADIUS FOR TOWN HIGHWAYS)  
 ESSEX JUNCTION:  
 STA MA 7+23.36 - STA MA 8+12.00 DOTTED LANE LINE RT  
 STA MA 7+23.36 - STA MA 10+29.00 BIKE LANE EDGE LINE LT  
 STA MA 8+12.00 - STA MA 12+00.00 BIKE LANE EDGE LINE RT  
 STA MA 10+97.00 - STA MA 12+00.00 BIKE LANE EDGE LINE LT


4 INCH YELLOW LINE, LOW VOC CHLORINATED RUBBER PAINT AND TEMPORARY 4 INCH YELLOW LINE, PAINT  
 (ALL LINES WILL INCLUDE C/L LINE BREAKS FOR TOWN HIGHWAYS)  
 S = SOLID, D = DASHED  
 ESSEX JUNCTION:  
 STA MA 7+23.36 - STA MA 12+00.00 S - S  
 STA MA 7+60.32 DOUBLE SOLID RT, ELM STREET  
 STA MA 10+61.28 DOUBLE SOLID LT, EAST STREET

CROSSWALK MARKING, LOW VOC CHLORINATED RUBBER PAINT AND TEMPORARY CROSSWALK MARKING, PAINT  
 ESSEX JUNCTION:  
 STA MA 7+60.32 RT, ELM STREET  
 STA MA 7+92.00 LT & RT  
 STA MA 10+61.28 LT, EAST STREET  
 24 INCH STOP BAR, LOW VOC CHLORINATED RUBBER PAINT AND TEMPORARY 24 INCH STOP BAR, PAINT  
 STA MA 7+60.32 RT, ELM STREET  
 STA MA 10+61.28 LT, EAST STREET

REMOVING SIGNS AS SHOWN - 15  
 ERECTING SALVAGED SIGNS AS SHOWN - 1

TEMPORARY LETTER OR SYMBOL, PAINT  
 ESSEX JUNCTION:  
 STA MA 8+12.00 RT, BIKE LANE SYMBOL (2 EA)  
 STA MA 10+00.00 LT, BIKE LANE SYMBOL (2 EA)

LETTER OR SYMBOL, LOW VOC CHLORINATED RUBBER PAINT  
 ESSEX JUNCTION:  
 STA MA 8+12.00 RT, BIKE LANE SYMBOL (1 EA)  
 STA MA 10+00.00 LT, BIKE LANE SYMBOL (1 EA)

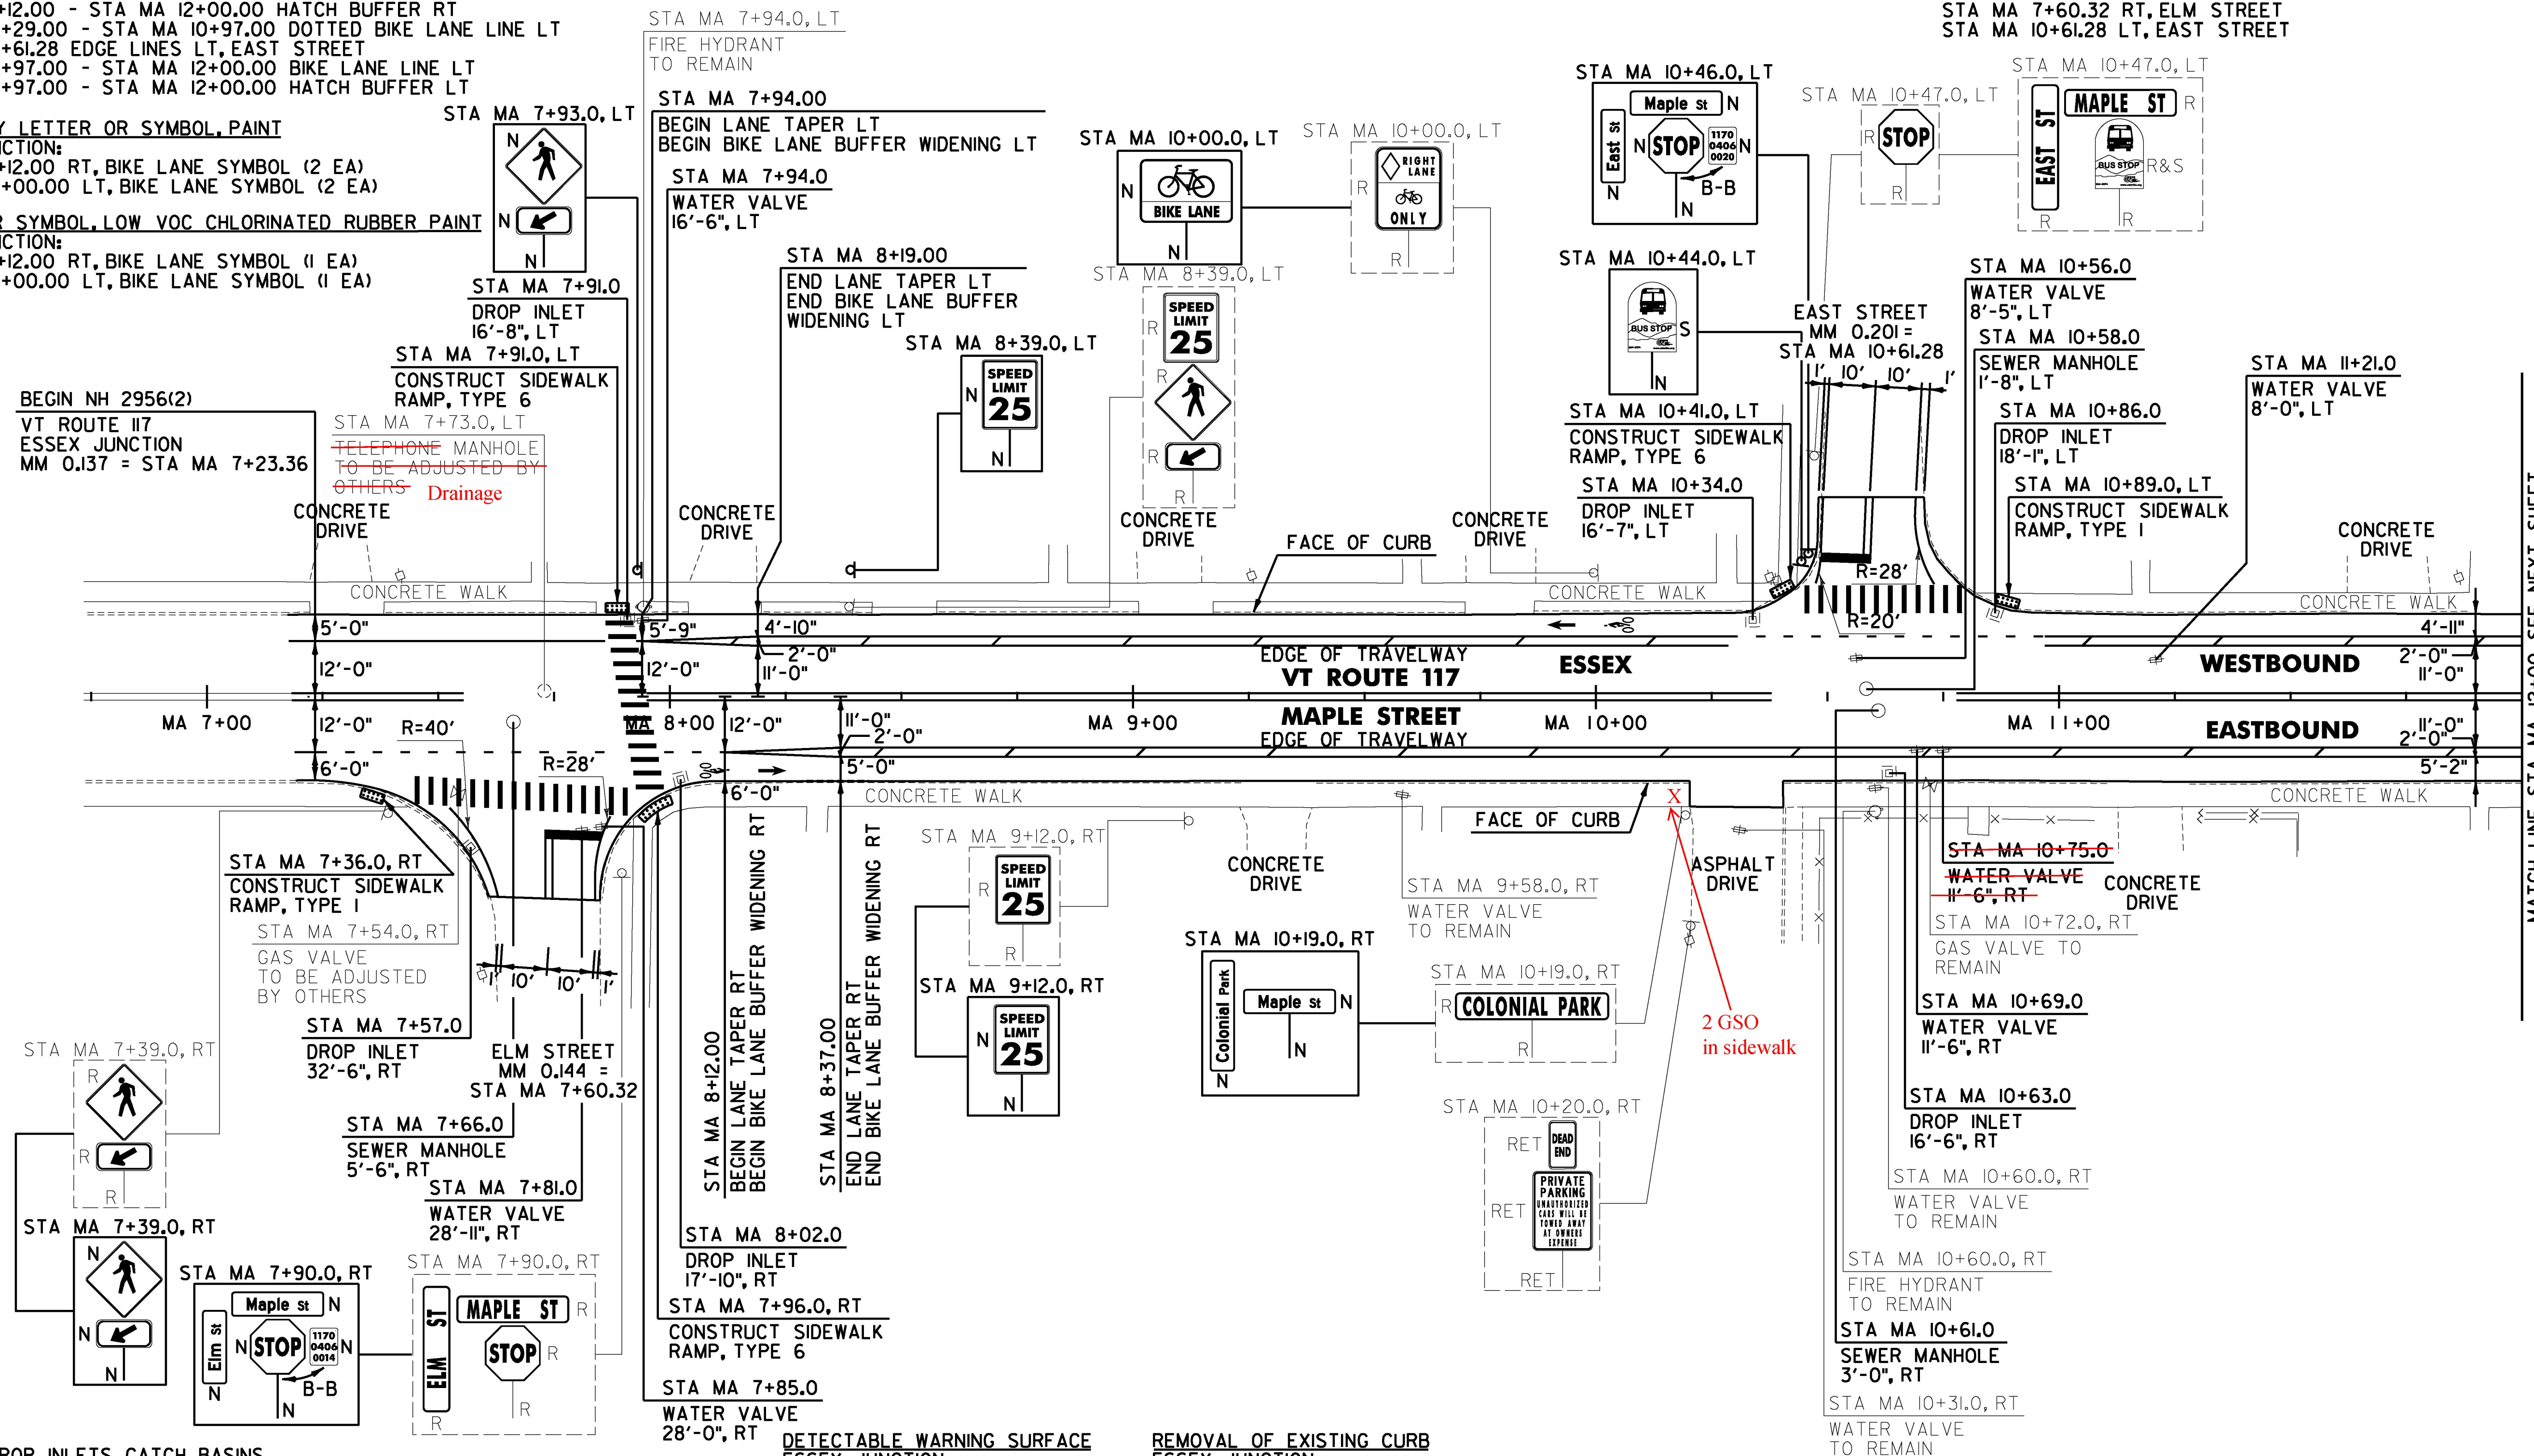

REHAB. DROP INLETS, CATCH BASINS, OR MANHOLES, CLASS I, II OR III  
 ESSEX JUNCTION:  
 STA MA 7+57.0 RT MA 7+66 RT  
 STA MA 7+91.0 LT MA 7+73 LT  
 STA MA 8+02.0 RT MA 7+96 RT  
 STA MA 10+34.0 LT MA 10+58 LT  
 STA MA 10+63.0 RT MA 10+61 LT  
 STA MA 10+86.0 LT

ADJUST ELEVATION OF VALVE BOX  
 ESSEX JUNCTION:  
 STA MA 7+81.0 RT  
 STA MA 7+85.0 RT  
 STA MA 7+94.0 LT  
 STA MA 10+56.0 LT  
 STA MA 10+69.0 RT  
 STA MA 10+75.0 RT  
 STA MA 11+21.0 LT

DETECTABLE WARNING SURFACE  
 ESSEX JUNCTION:  
 STA MA 7+36.0 RT  
 STA MA 7+91.0 LT  
 STA MA 7+96.0 RT  
 STA MA 10+41.0 LT  
 STA MA 10+89.0 LT

PORTLAND CEMENT CONCRETE SIDEWALK, 5 INCH  
 ESSEX JUNCTION:  
 STA MA 7+36.0 RT  
 STA MA 7+91.0 LT  
 STA MA 7+96.0 RT  
 STA MA 10+41.0 LT  
 STA MA 10+89.0 LT

REMOVAL OF EXISTING CURB, TYPE B  
 ESSEX JUNCTION:  
 STA MA 7+36.0 RT  
 STA MA 7+91.0 LT  
 STA MA 7+96.0 RT  
 STA MA 10+41.0 LT  
 STA MA 10+89.0 LT

CAST-IN-PLACE CONCRETE CURB, TYPE B  
 ESSEX JUNCTION:  
 STA MA 7+36.0 RT  
 STA MA 7+91.0 LT  
 STA MA 7+96.0 RT  
 STA MA 10+41.0 LT  
 STA MA 10+89.0 LT

SIGN LEGEND  
 R = REMOVE  
 S = SALVAGE  
 N = NEW  
 RET = RETAIN  
 B-B = BACK TO BACK  
 EXISTING =   
 NEW =   
 R = RETURN TO VILLAGE OF ESSEX JUNCTION

NOT TO SCALE

PROJECT NAME: ESSEX JUNCTION	PLOT DATE: 4/19/2016
PROJECT NUMBER: NH 2956(2)	DRAWN BY: C. KAHLBAUGH
FILE NAME: z15v026bdr.dgn	CHECKED BY: J. SHIELDS
PROJECT LEADER: D.GOZALKOWSKI	SHEET 107 OF 171
DESIGNED BY: J. SCUDDER	
PLAN SHEET 25	

MATCH LINE STA MA 12+00. SEE NEXT SHEET