

4 INCH WHITE LINE, LOW VOC CHLORINATED RUBBER PAINT AND TEMPORARY 4 INCH WHITE LINE, PAINT

(ALL LINES WILL INCLUDE EDGE LINE BREAKS AND RADIUS FOR TOWN HIGHWAYS)

ESSEX JUNCTION:

- STA MA 17+00.00 - STA MA 17+57.00 DOTTED BIKE LANE LINE RT
- STA MA 17+00.00 - STA MA 21+70.00 BIKE LANE LINE LT
- STA MA 17+00.00 - STA MA 21+70.00 HATCH BUFFER LT
- STA MA 17+57.00 - STA MA 20+43.00 BIKE LANE LINE RT
- STA MA 17+57.00 - STA MA 20+43.00 HATCH BUFFER RT
- STA MA 20+43.00 - STA MA 21+06.00 DOTTED BIKE LANE LINE RT
- STA MA 21+06.00 - STA MA 22+00.00 BIKE LANE LINE RT
- STA MA 21+06.00 - STA MA 22+00.00 HATCH BUFFER RT
- STA MA 21+70.00 - STA MA 22+00.00 DOTTED BIKE LANE LINE LT

24 INCH STOP BAR, LOW VOC CHLORINATED RUBBER PAINT AND TEMPORARY 24 INCH STOP BAR, PAINT

- STA MA 17+26.56 RT, GRANT STREET
- STA MA 20+75.04 RT, CAMP STREET

4 INCH YELLOW LINE, LOW VOC CHLORINATED RUBBER PAINT AND TEMPORARY 4 INCH YELLOW LINE, PAINT

(ALL LINES WILL INCLUDE C/L LINE BREAKS FOR TOWN HIGHWAYS)

ESSEX JUNCTION:

- STA MA 17+00.00 - STA MA 22+00.00 LT & RT
- S = SOLID, D = DASHED

6 INCH WHITE LINE, LOW VOC CHLORINATED RUBBER PAINT AND TEMPORARY 6 INCH WHITE LINE, PAINT

(ALL LINES WILL INCLUDE EDGE LINE BREAKS AND RADIUS FOR TOWN HIGHWAYS)

ESSEX JUNCTION:

- STA MA 17+00.00 - STA MA 21+70.00 BIKE LANE EDGE LINE LT
- STA MA 17+57.00 - STA MA 20+43.00 BIKE LANE EDGE LINE RT
- STA MA 21+06.00 - STA MA 22+00.00 BIKE LANE EDGE LINE RT

CROSSWALK MARKING, LOW VOC CHLORINATED RUBBER PAINT AND TEMPORARY CROSSWALK MARKING, PAINT

ESSEX JUNCTION:

- STA MA 17+26.56 RT, GRANT STREET
- STA MA 20+75.04 RT, CAMP STREET
- STA MA 21+80.00 LT & RT

TEMPORARY LETTER OR SYMBOL, PAINT

ESSEX JUNCTION:


- STA MA 17+83.00 RT, BIKE LANE SYMBOL (2 EA)
- STA MA 21+12.00 LT, BIKE LANE SYMBOL (2 EA)
- STA MA 21+12.00 RT, BIKE LANE SYMBOL (2 EA)

LETTER OR SYMBOL, LOW VOC CHLORINATED RUBBER PAINT

ESSEX JUNCTION:

- STA MA 17+83.00 RT, BIKE LANE SYMBOL (1 EA)
- STA MA 21+12.00 LT, BIKE LANE SYMBOL (1 EA)
- STA MA 21+12.00 RT, BIKE LANE SYMBOL (1 EA)

REMOVING SIGNS AS SHOWN - 19

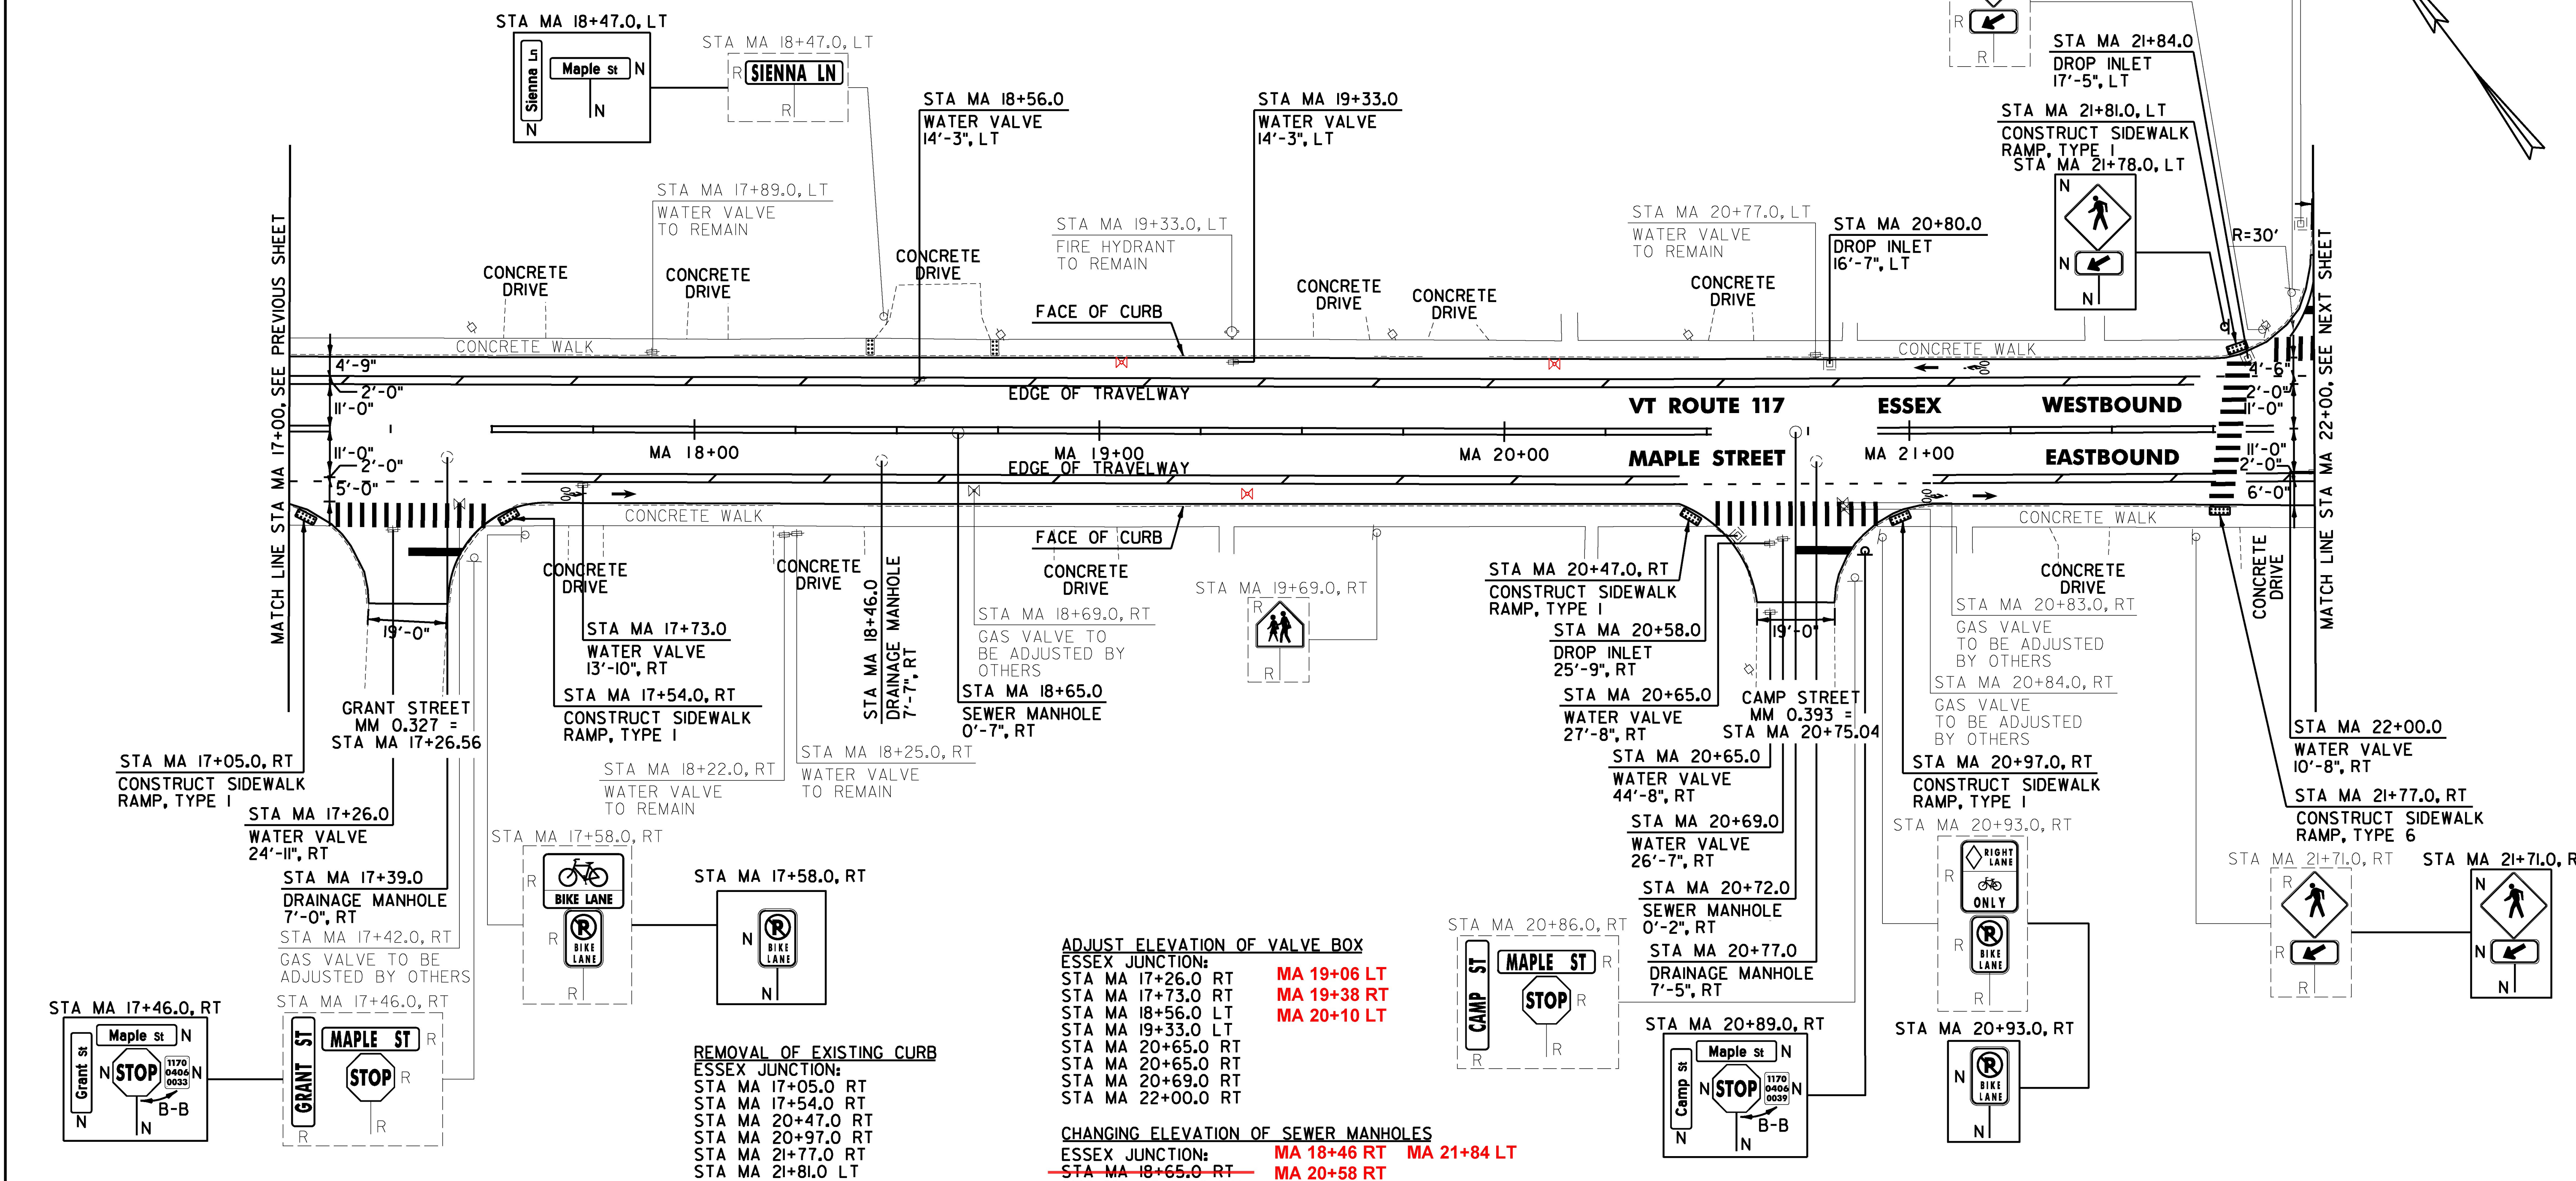

CAST-IN-PLACE CONCRETE CURB, TYPE B  
ESSEX JUNCTION:  
STA MA 17+05.0 RT  
STA MA 17+54.0 RT  
STA MA 20+47.0 RT  
STA MA 20+97.0 RT  
STA MA 21+77.0 RT  
STA MA 21+81.0 LT

REHAB. DROP INLETS, CATCH BASINS, OR MANHOLES, CLASS I, II OR III  
ESSEX JUNCTION:  
STA MA 17+39.0 RT  
~~STA MA 18+46.0 RT~~  
~~STA MA 20+58.0 RT~~  
~~STA MA 20+77.0 RT~~  
STA MA 20+80.0 LT  
~~STA MA 21+84.0 LT~~

PORTLAND CEMENT CONCRETE SIDEWALK, 5 INCH  
ESSEX JUNCTION:  
STA MA 17+05.0 RT  
STA MA 17+54.0 RT  
STA MA 20+47.0 RT  
STA MA 20+97.0 RT  
STA MA 21+77.0 RT  
STA MA 21+81.0 LT

ADJUST ELEVATION OF VALVE BOX  
ESSEX JUNCTION:  
STA MA 17+26.0 RT MA 19+06 LT  
STA MA 17+73.0 RT MA 19+38 RT  
STA MA 18+56.0 LT MA 20+10 LT  
STA MA 19+33.0 LT  
STA MA 20+65.0 RT  
STA MA 20+65.0 RT  
STA MA 20+69.0 RT  
STA MA 22+00.0 RT

CHANGING ELEVATION OF SEWER MANHOLES  
ESSEX JUNCTION:  
~~STA MA 18+65.0 RT~~ MA 18+46 RT MA 21+84 LT  
~~STA MA 20+72.0 RT~~ MA 20+58 RT  
MA 20+77 RT

DETECTABLE WARNING SURFACE  
ESSEX JUNCTION:  
STA MA 17+05.0 RT  
STA MA 17+54.0 RT  
STA MA 20+47.0 RT  
STA MA 20+97.0 RT  
STA MA 21+77.0 RT  
STA MA 21+81.0 LT

SIGN LEGEND  
R = REMOVE  
S = SALVAGE  
N = NEW  
RET = RETAIN  
B-B = BACK TO BACK  
EXISTING =  
NEW =  
R = RETURN TO VILLAGE OF ESSEX JUNCTION

NOT TO SCALE



PROJECT NAME: ESSEX JUNCTION	PLOT DATE: 4/19/2016
PROJECT NUMBER: NH 2956(2)	DRAWN BY: C. KAHLBAUGH
FILE NAME: z15v026bdr.dgn	CHECKED BY: J. SHIELDS
PROJECT LEADER: D.GOZALKOWSKI	SHEET 109 OF 171
DESIGNED BY: J. SCUDDER	
PLAN SHEET 27	