

4 INCH WHITE LINE, LOW VOC CHLORINATED RUBBER PAINT AND TEMPORARY 4 INCH WHITE LINE, PAINT
 (ALL LINES WILL INCLUDE EDGE LINE BREAKS AND RADIUS FOR TOWN HIGHWAYS)
 ESSEX JUNCTION:
 STA MA 32+00.00 - STA MA 34+30.00 BIKE LANE LINE LT
 STA MA 32+00.00 - STA MA 34+30.00 HATCH BUFFER LT
 STA MA 32+00.00 - STA MA 37+00.00 BIKE LANE LINE RT
 STA MA 32+00.00 - STA MA 37+00.00 HATCH BUFFER RT
 STA MA 34+30.00 - STA MA 37+00.00 EDGE LINE LT

6 INCH WHITE LINE, LOW VOC CHLORINATED RUBBER PAINT AND TEMPORARY 6 INCH WHITE LINE, PAINT
 (ALL LINES WILL INCLUDE EDGE LINE BREAKS AND RADIUS FOR TOWN HIGHWAYS)
 ESSEX JUNCTION:
 STA MA 32+00.00 - STA MA 34+30.00 BIKE LANE EDGE LINE LT
 STA MA 32+00.00 - STA MA 37+00.00 BIKE LANE EDGE LINE RT


4 INCH YELLOW LINE, LOW VOC CHLORINATED RUBBER PAINT AND TEMPORARY 4 INCH YELLOW LINE, PAINT
 (ALL LINES WILL INCLUDE C/L LINE BREAKS FOR TOWN HIGHWAYS)
 S = SOLID, D = DASHED
 ESSEX JUNCTION:
 STA MA 32+00.00 - STA MA 37+00.00

LT C RT
S - S

CROSSWALK MARKING, LOW VOC CHLORINATED RUBBER PAINT AND TEMPORARY CROSSWALK MARKING, PAINT
 ESSEX JUNCTION:
 STA MA 32+63.00 LT & RT
 STA MA 34+55.00 - STA MA 34+94.00 LT
 TEMPORARY LETTER OR SYMBOL, PAINT
 ESSEX JUNCTION:
 STA MA 33+96.00 LT, BIKE LANE SYMBOL (2 EA)
 STA MA 35+50.00 RT, BIKE LANE SYMBOL (2 EA)

REMOVING SIGNS AS SHOWN - 9
 ERECTING SALVAGED SIGNS AS SHOWN - 1

LETTER OR SYMBOL, LOW VOC CHLORINATED RUBBER PAINT
 ESSEX JUNCTION:
 STA MA 33+96.00 LT, BIKE LANE SYMBOL (1 EA)
 STA MA 35+50.00 RT, BIKE LANE SYMBOL (1 EA)
24 INCH STOP BAR, LOW VOC CHLORINATED RUBBER PAINT AND TEMPORARY 24 INCH STOP BAR, PAINT
 ESSEX JUNCTION:
 STA MA 34+77.00 LT, SCHOOL DRIVE

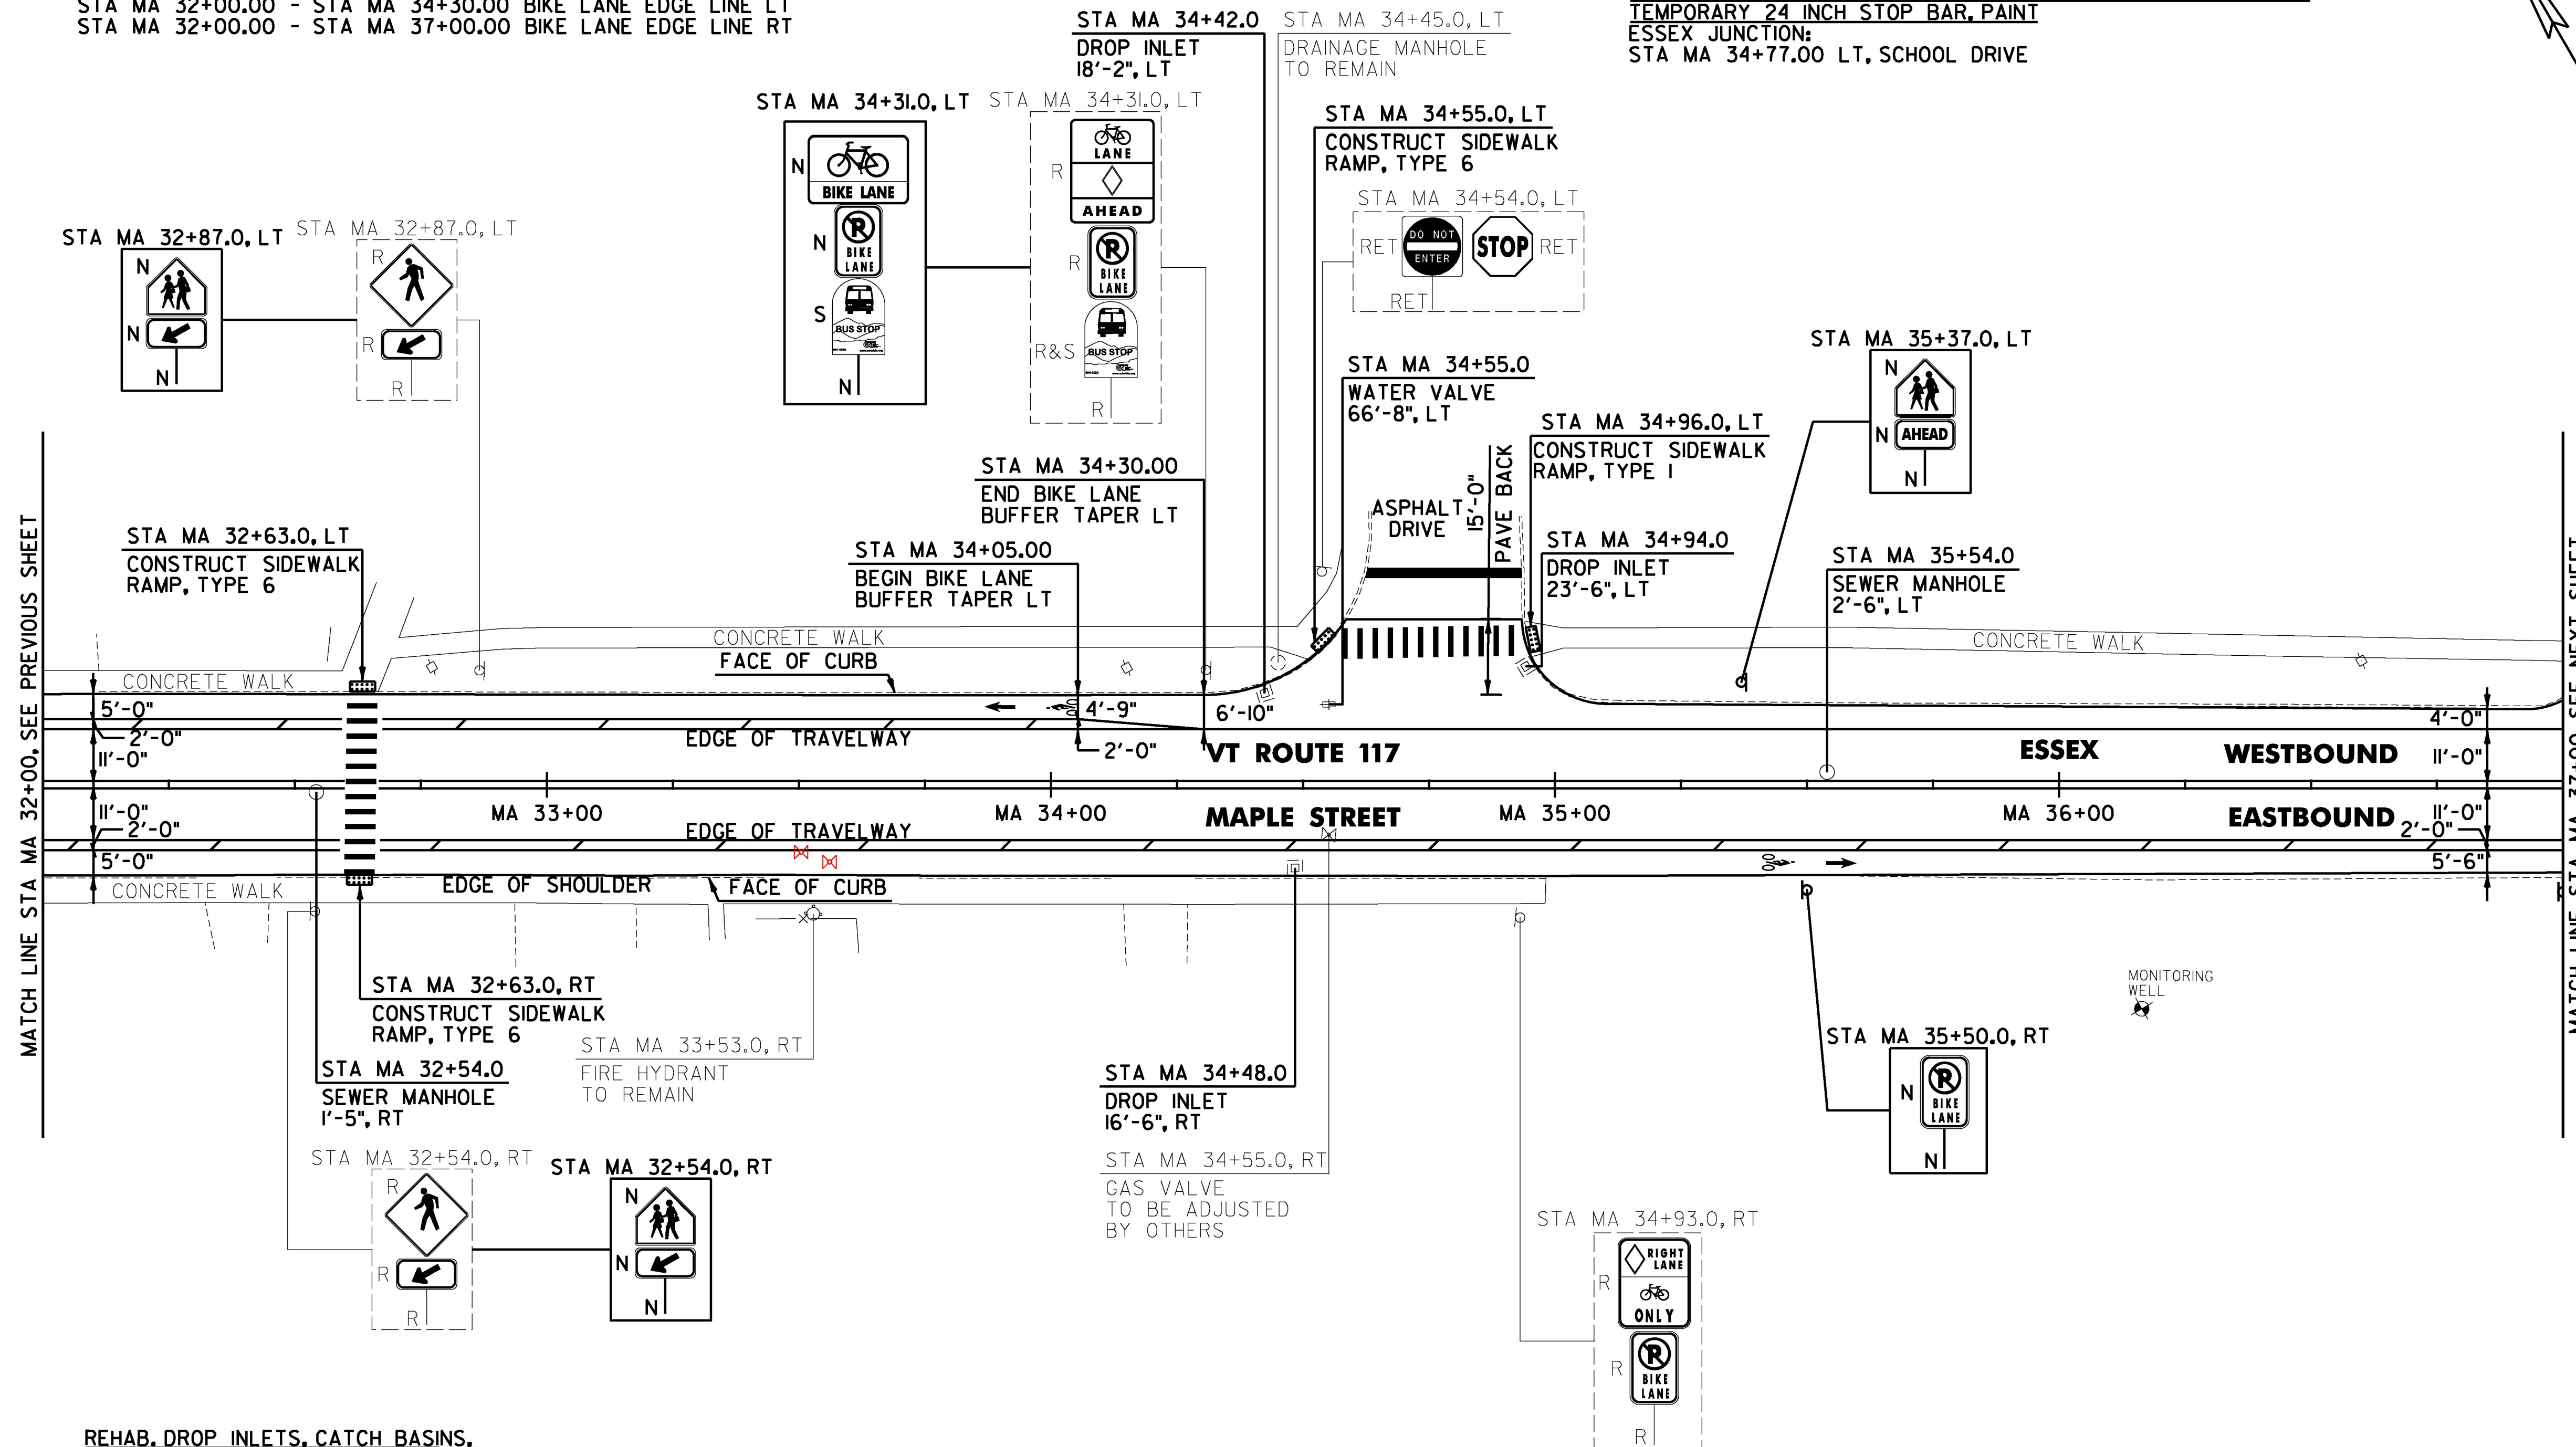

REHAB. DROP INLETS, CATCH BASINS, OR MANHOLES, CLASS I, II OR III
 ESSEX JUNCTION:
 STA MA 34+42.0 LT
 STA MA 34+48.0 RT
~~STA MA 34+94.0 LT~~

ADJUST ELEVATION OF VALVE BOX
 ESSEX JUNCTION: MA 33+53 RT
 STA MA 34+55.0 LT MA 33+54 RT

CHANGING ELEVATION OF SEWER MANHOLES
 ESSEX JUNCTION:
 STA MA 32+54.0 RT MA 34+94 LT
 STA MA 35+54.0 LT

DETECTABLE WARNING SURFACE
 ESSEX JUNCTION:
 STA MA 32+63.0 LT
 STA MA 32+63.0 RT
 STA MA 34+55.0 LT
 STA MA 34+96.0 LT

PORTLAND CEMENT CONCRETE SIDEWALK, 5 INCH
 ESSEX JUNCTION:
 STA MA 32+63.0 LT
 STA MA 32+63.0 RT
 STA MA 34+55.0 LT
 STA MA 34+96.0 LT

REMOVAL OF EXISTING CURB
 ESSEX JUNCTION:
 STA MA 32+63.0 LT
 STA MA 32+63.0 RT
 STA MA 34+55.0 LT
 STA MA 34+96.0 LT

CAST-IN-PLACE CONCRETE CURB, TYPE B
 ESSEX JUNCTION:
 STA MA 32+63.0 LT
 STA MA 32+63.0 RT
 STA MA 34+55.0 LT
 STA MA 34+96.0 LT

SIGN LEGEND
 R = REMOVE
 S = SALVAGE
 N = NEW
 RET = RETAIN
 B-B = BACK TO BACK
 EXISTING =
 NEW =
 R = RETURN TO VILLAGE OF ESSEX JUNCTION

NOT TO SCALE



PROJECT NAME: ESSEX JUNCTION
 PROJECT NUMBER: NH 2956(2)

FILE NAME: z15v026bdr.dgn
 PROJECT LEADER: D.GOZALKOWSKI
 DESIGNED BY: J. SCUDDER
 PLAN SHEET 30

PLOT DATE: 4/19/2016
 DRAWN BY: C. KAHLBAUGH
 CHECKED BY: J. SHIELDS
 SHEET 112 OF 171