
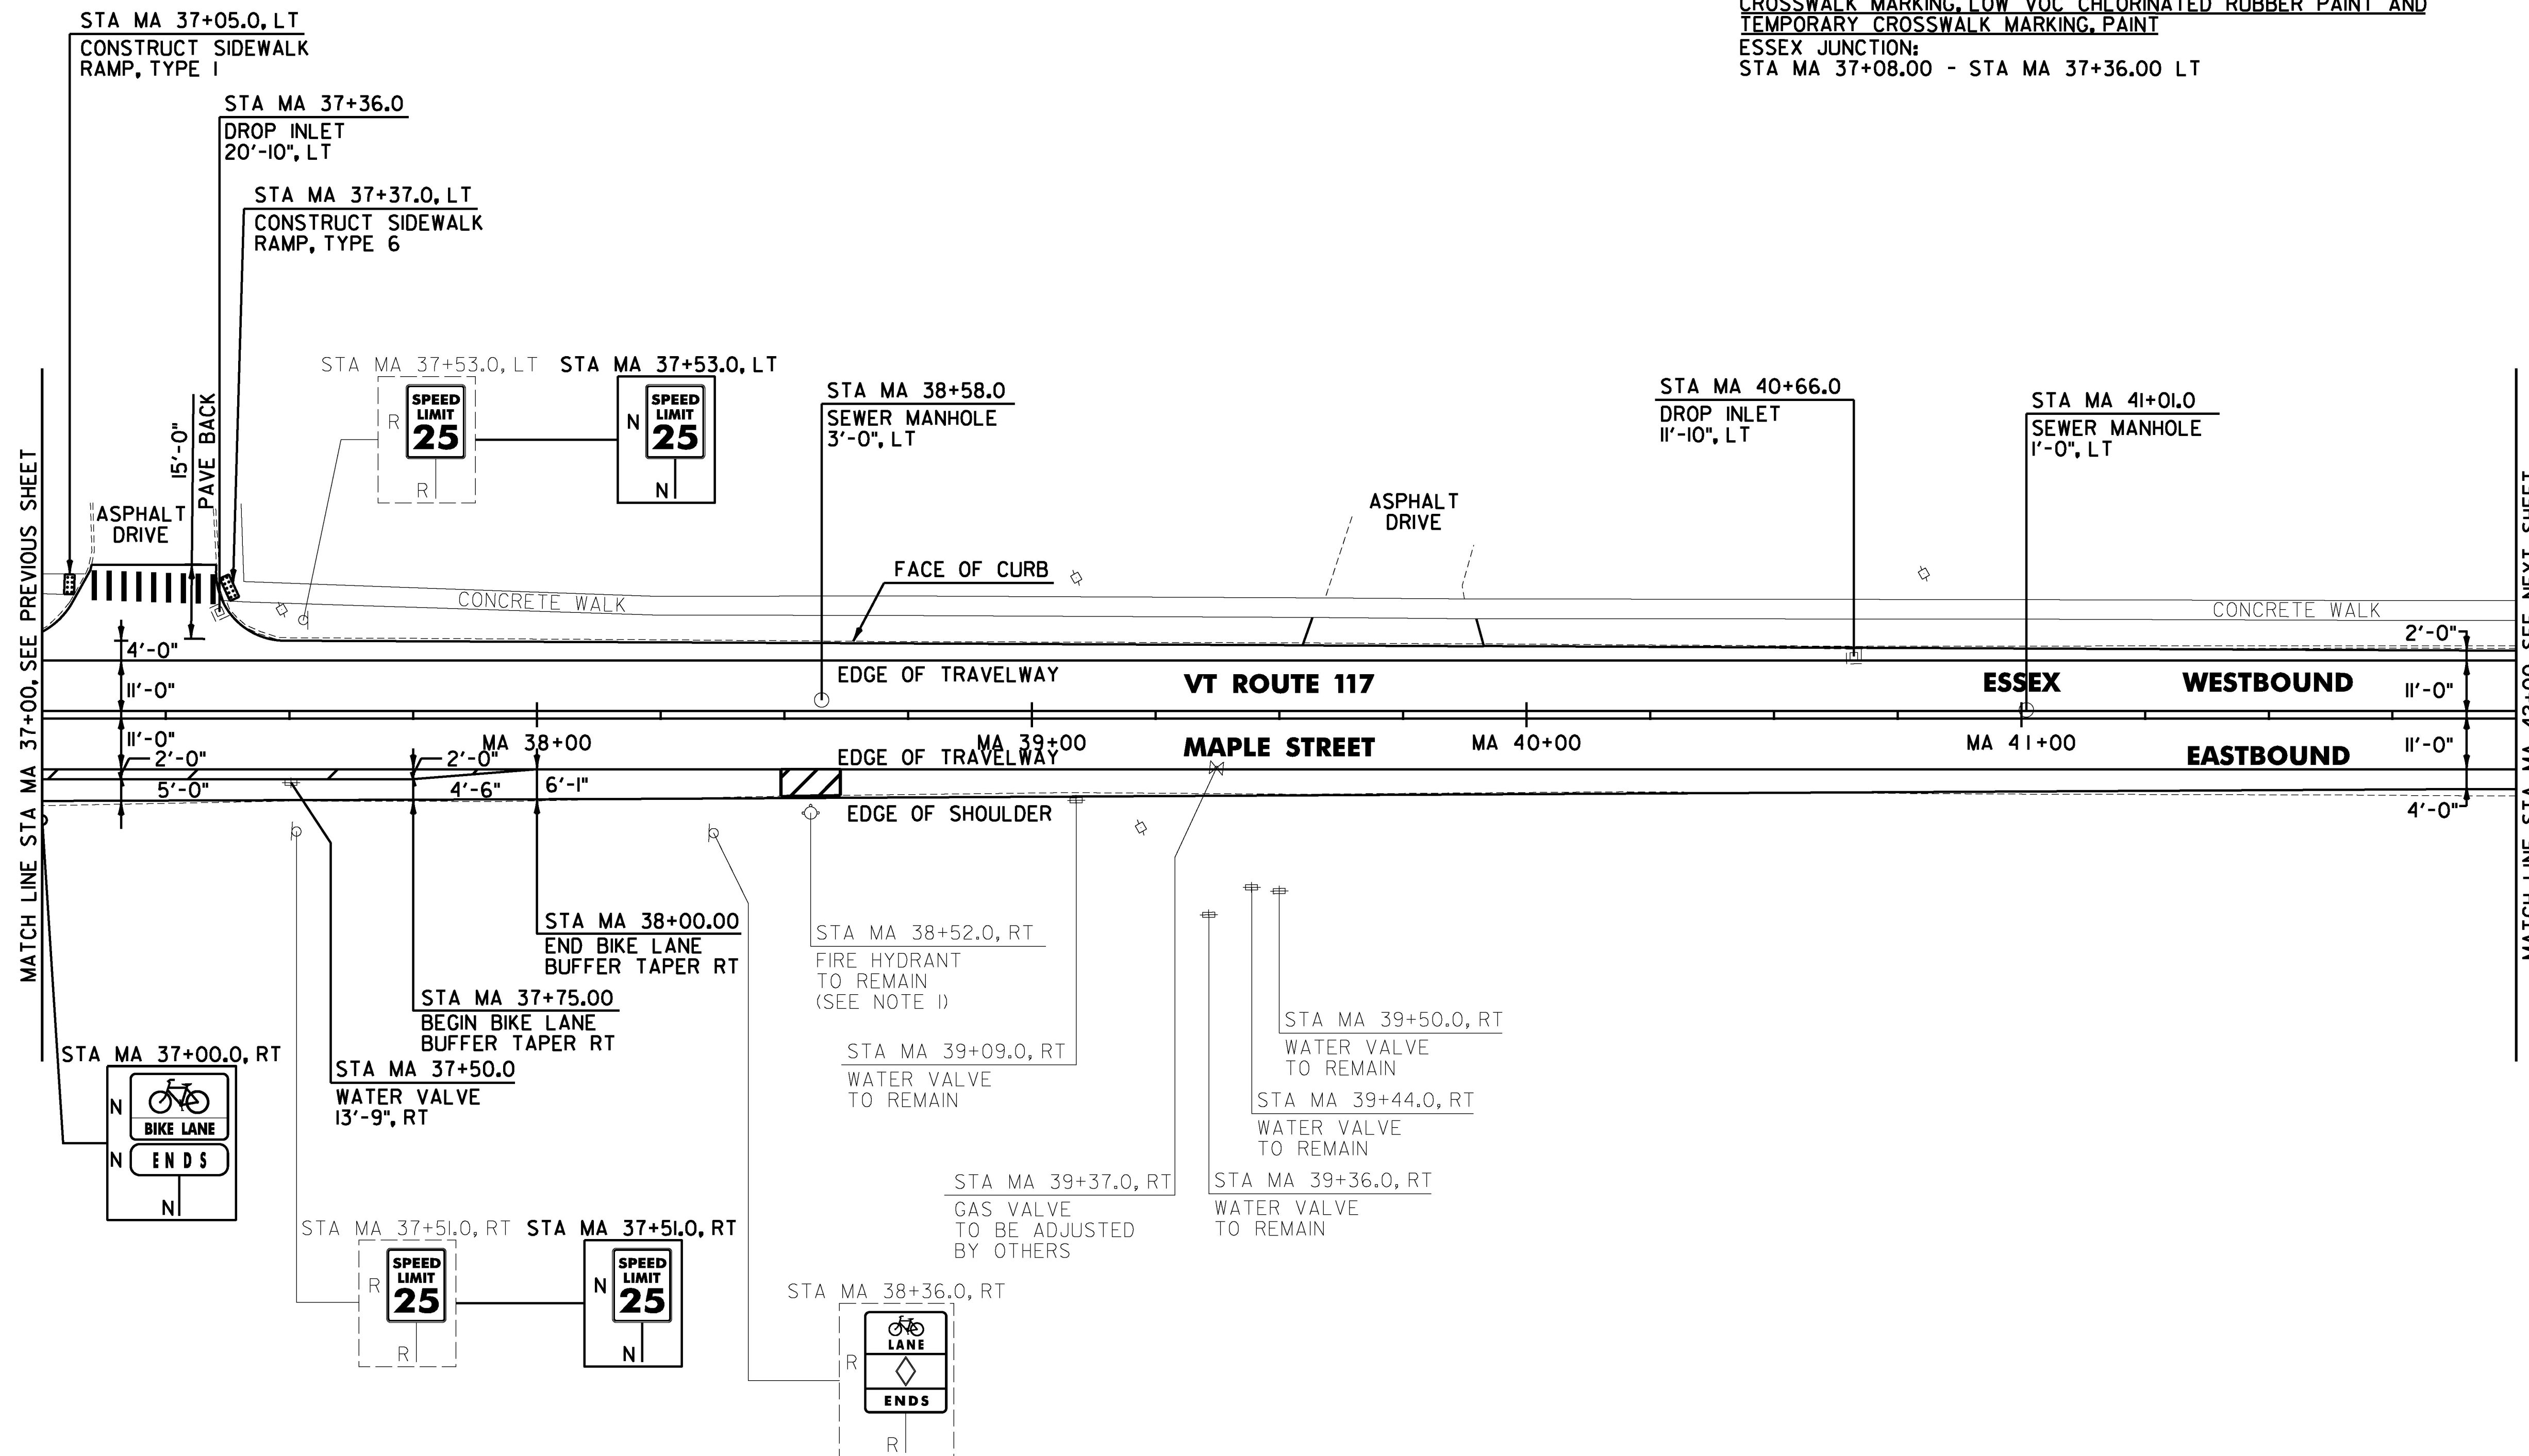


4 INCH WHITE LINE, LOW VOC CHLORINATED RUBBER PAINT AND TEMPORARY 4 INCH WHITE LINE, PAINT
 (ALL LINES WILL INCLUDE EDGE LINE BREAKS AND RADIUS FOR TOWN HIGHWAYS)
 ESSEX JUNCTION:
 STA MA 37+00.00 - STA MA 38+00.00 BIKE LANE LINE RT
 STA MA 37+00.00 - STA MA 38+00.00 HATCH BUFFER RT
 STA MA 37+00.00 - STA MA 42+00.00 EDGE LINE LT
 STA MA 38+00.00 - STA MA 42+00.00 EDGE LINE RT

4 INCH YELLOW LINE, LOW VOC CHLORINATED RUBBER PAINT AND TEMPORARY 4 INCH YELLOW LINE, PAINT
 (ALL LINES WILL INCLUDE C/L LINE BREAKS FOR TOWN HIGHWAYS)
 S = SOLID, D = DASHED
 ESSEX JUNCTION:
 STA MA 37+00.00 - STA MA 42+00.00 LT & RT
 S - S

6 INCH WHITE LINE, LOW VOC CHLORINATED RUBBER PAINT AND TEMPORARY 6 INCH WHITE LINE, PAINT
 (ALL LINES WILL INCLUDE EDGE LINE BREAKS AND RADIUS FOR TOWN HIGHWAYS)
 ESSEX JUNCTION:
 STA MA 37+00.00 - STA MA 38+00.00 BIKE LANE EDGE LINE RT
8 INCH WHITE LINE, LOW VOC CHLORINATED RUBBER PAINT
 ESSEX JUNCTION:
 STA MA 38+46.00 - STA MA 38+58.00 RT, FIRE HYDRANT, NO PARKING
CROSSWALK MARKING, LOW VOC CHLORINATED RUBBER PAINT AND TEMPORARY CROSSWALK MARKING, PAINT
 ESSEX JUNCTION:
 STA MA 37+08.00 - STA MA 37+36.00 LT

REMOVING SIGNS AS SHOWN - 3

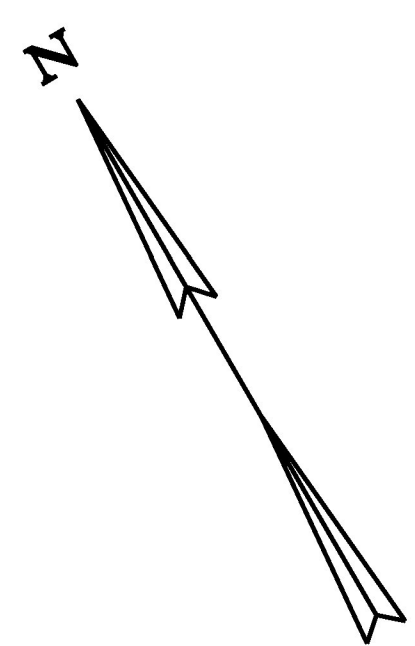

REHAB DROP INLETS, CATCH BASINS, OR MANHOLES, CLASS I, II OR III
 ESSEX JUNCTION:
 STA MA 37+36.0 LT MA 38+58 LT
~~STA MA 40+66.0 LT MA 41+01 LT~~

ADJUST ELEVATION OF VALVE BOX
 ESSEX JUNCTION:
 STA MA 37+50.0 RT
CHANGING ELEVATION OF SEWER MANHOLES
 ESSEX JUNCTION:
 STA MA 38+58.0 LT MA 40+66 LT
~~STA MA 41+01.0 LT~~

DETECTABLE WARNING SURFACE
 ESSEX JUNCTION:
 STA MA 37+05.0 LT
 STA MA 37+37.0 LT
PORTLAND CEMENT CONCRETE SIDEWALK, 5 INCH
 ESSEX JUNCTION:
 STA MA 37+05.0 LT
 STA MA 37+37.0 LT

REMOVAL OF EXISTING CURB
 ESSEX JUNCTION:
 STA MA 37+05.0 LT
 STA MA 37+37.0 LT
CAST-IN-PLACE CONCRETE CURB, TYPE B
 ESSEX JUNCTION:
 STA MA 37+05.0 LT
 STA MA 37+37.0 LT

SIGN LEGEND
 R = REMOVE
 S = SALVAGE
 N = NEW
 RET = RETAIN
 B-B = BACK TO BACK
 EXISTING = - - - - -
 NEW = _____
 R = RETURN TO VILLAGE OF ESSEX JUNCTION

NOT TO SCALE

NOTE:
 I. SEE SHEET 10 FOR FIRE HYDRANT PAVEMENT MARKING DETAIL.

PROJECT NAME: ESSEX JUNCTION
 PROJECT NUMBER: NH 2956(2)

FILE NAME: z15v026bdr.dgn PLOT DATE: 4/19/2016
 PROJECT LEADER: D.GOZALKOWSKI DRAWN BY: C. KAHLBAUGH
 DESIGNED BY: J. SCUDDER CHECKED BY: J. SHIELDS
 PLAN SHEET 31 SHEET 113 OF 171