

4 INCH WHITE LINE, LOW VOC CHLORINATED RUBBER PAINT AND TEMPORARY 4 INCH WHITE LINE, PAINT  
 (ALL LINES WILL INCLUDE EDGE LINE BREAKS AND RADIUS FOR TOWN HIGHWAYS)  
 ESSEX JUNCTION:  
 STA MA 42+00.00 - STA MA 47+00.00 EDGE LINE LT & RT  
 STA MA 43+50.72 SOLID LANE LINE LT, RIVENDELL DRIVE  
 STA MA 43+50.72 EDGE LINES LT, RIVENDELL DRIVE  
 STA MA 44+00.00 - STA MA 45+68.00 DOTTED LANE LINE RT  
 STA MA 45+68.00 - STA MA 47+00.00 SOLID LANE LINE RT

8 INCH YELLOW LINE, LOW VOC CHLORINATED RUBBER PAINT  
 ESSEX JUNCTION:  
 STA MA 46+00.00 - STA MA 47+00.00 MEDIAN HATCH C/L & LT

CROSSWALK MARKING, LOW VOC CHLORINATED RUBBER PAINT AND TEMPORARY CROSSWALK MARKING, PAINT  
 ESSEX JUNCTION:  
 STA MA 43+50.72 LT, RIVENDELL DRIVE  
 STA MA 43+96.00 LT & RT

4 INCH YELLOW LINE, LOW VOC CHLORINATED RUBBER PAINT AND TEMPORARY 4 INCH YELLOW LINE, PAINT  
 (ALL LINES WILL INCLUDE C/L LINE BREAKS FOR TOWN HIGHWAYS)  
 S = SOLID, D = DASHED

ESSEX JUNCTION:  
 STA MA 42+00.00 - STA MA 46+00.00 LT & RT S = S  
 STA MA 43+50.72 DOUBLE SOLID LT, RIVENDELL DRIVE  
 STA MA 46+00.00 - STA MA 47+00.00 DOUBLE SOLID MEDIAN C/L & LT

24 INCH STOP BAR, LOW VOC CHLORINATED RUBBER PAINT AND TEMPORARY 24 INCH STOP BAR, PAINT  
 ESSEX JUNCTION:  
 STA MA 43+50.72 LT, RIVENDELL DRIVE

TEMPORARY LETTER OR SYMBOL, PAINT



ESSEX JUNCTION:  
 STA MA 42+60.00 LT, "S,C,H,O,O,L" (12 EA)  
 STA MA 43+50.72 LT, RIVENDELL DRIVE ARROW (2 EA)  
 STA MA 43+50.72 LT, RIVENDELL DRIVE ARROW (2 EA)  
 STA MA 45+72.00 RT, ARROW (2 EA)  
 STA MA 46+56.00 RT, ARROW (2 EA)

REMOVING SIGNS AS SHOWN - 10

ERECTING SALVAGED SIGNS AS SHOWN - 1

LETTER OR SYMBOL, LOW VOC CHLORINATED RUBBER PAINT

ESSEX JUNCTION:  
 STA MA 42+60.00 LT, "S,C,H,O,O,L" (6 EA)  
 STA MA 43+50.72 LT, RIVENDELL DRIVE ARROW (1 EA)  
 STA MA 43+50.72 LT, RIVENDELL DRIVE ARROW (1 EA)  
 STA MA 45+72.00 RT, ARROW (1 EA)  
 STA MA 46+14.00 RT, "O,N,L,Y" (4 EA)  
 STA MA 46+56.00 RT, ARROW (1 EA)  
 STA MA 46+98.00 RT, "O,N,L,Y" (4 EA)

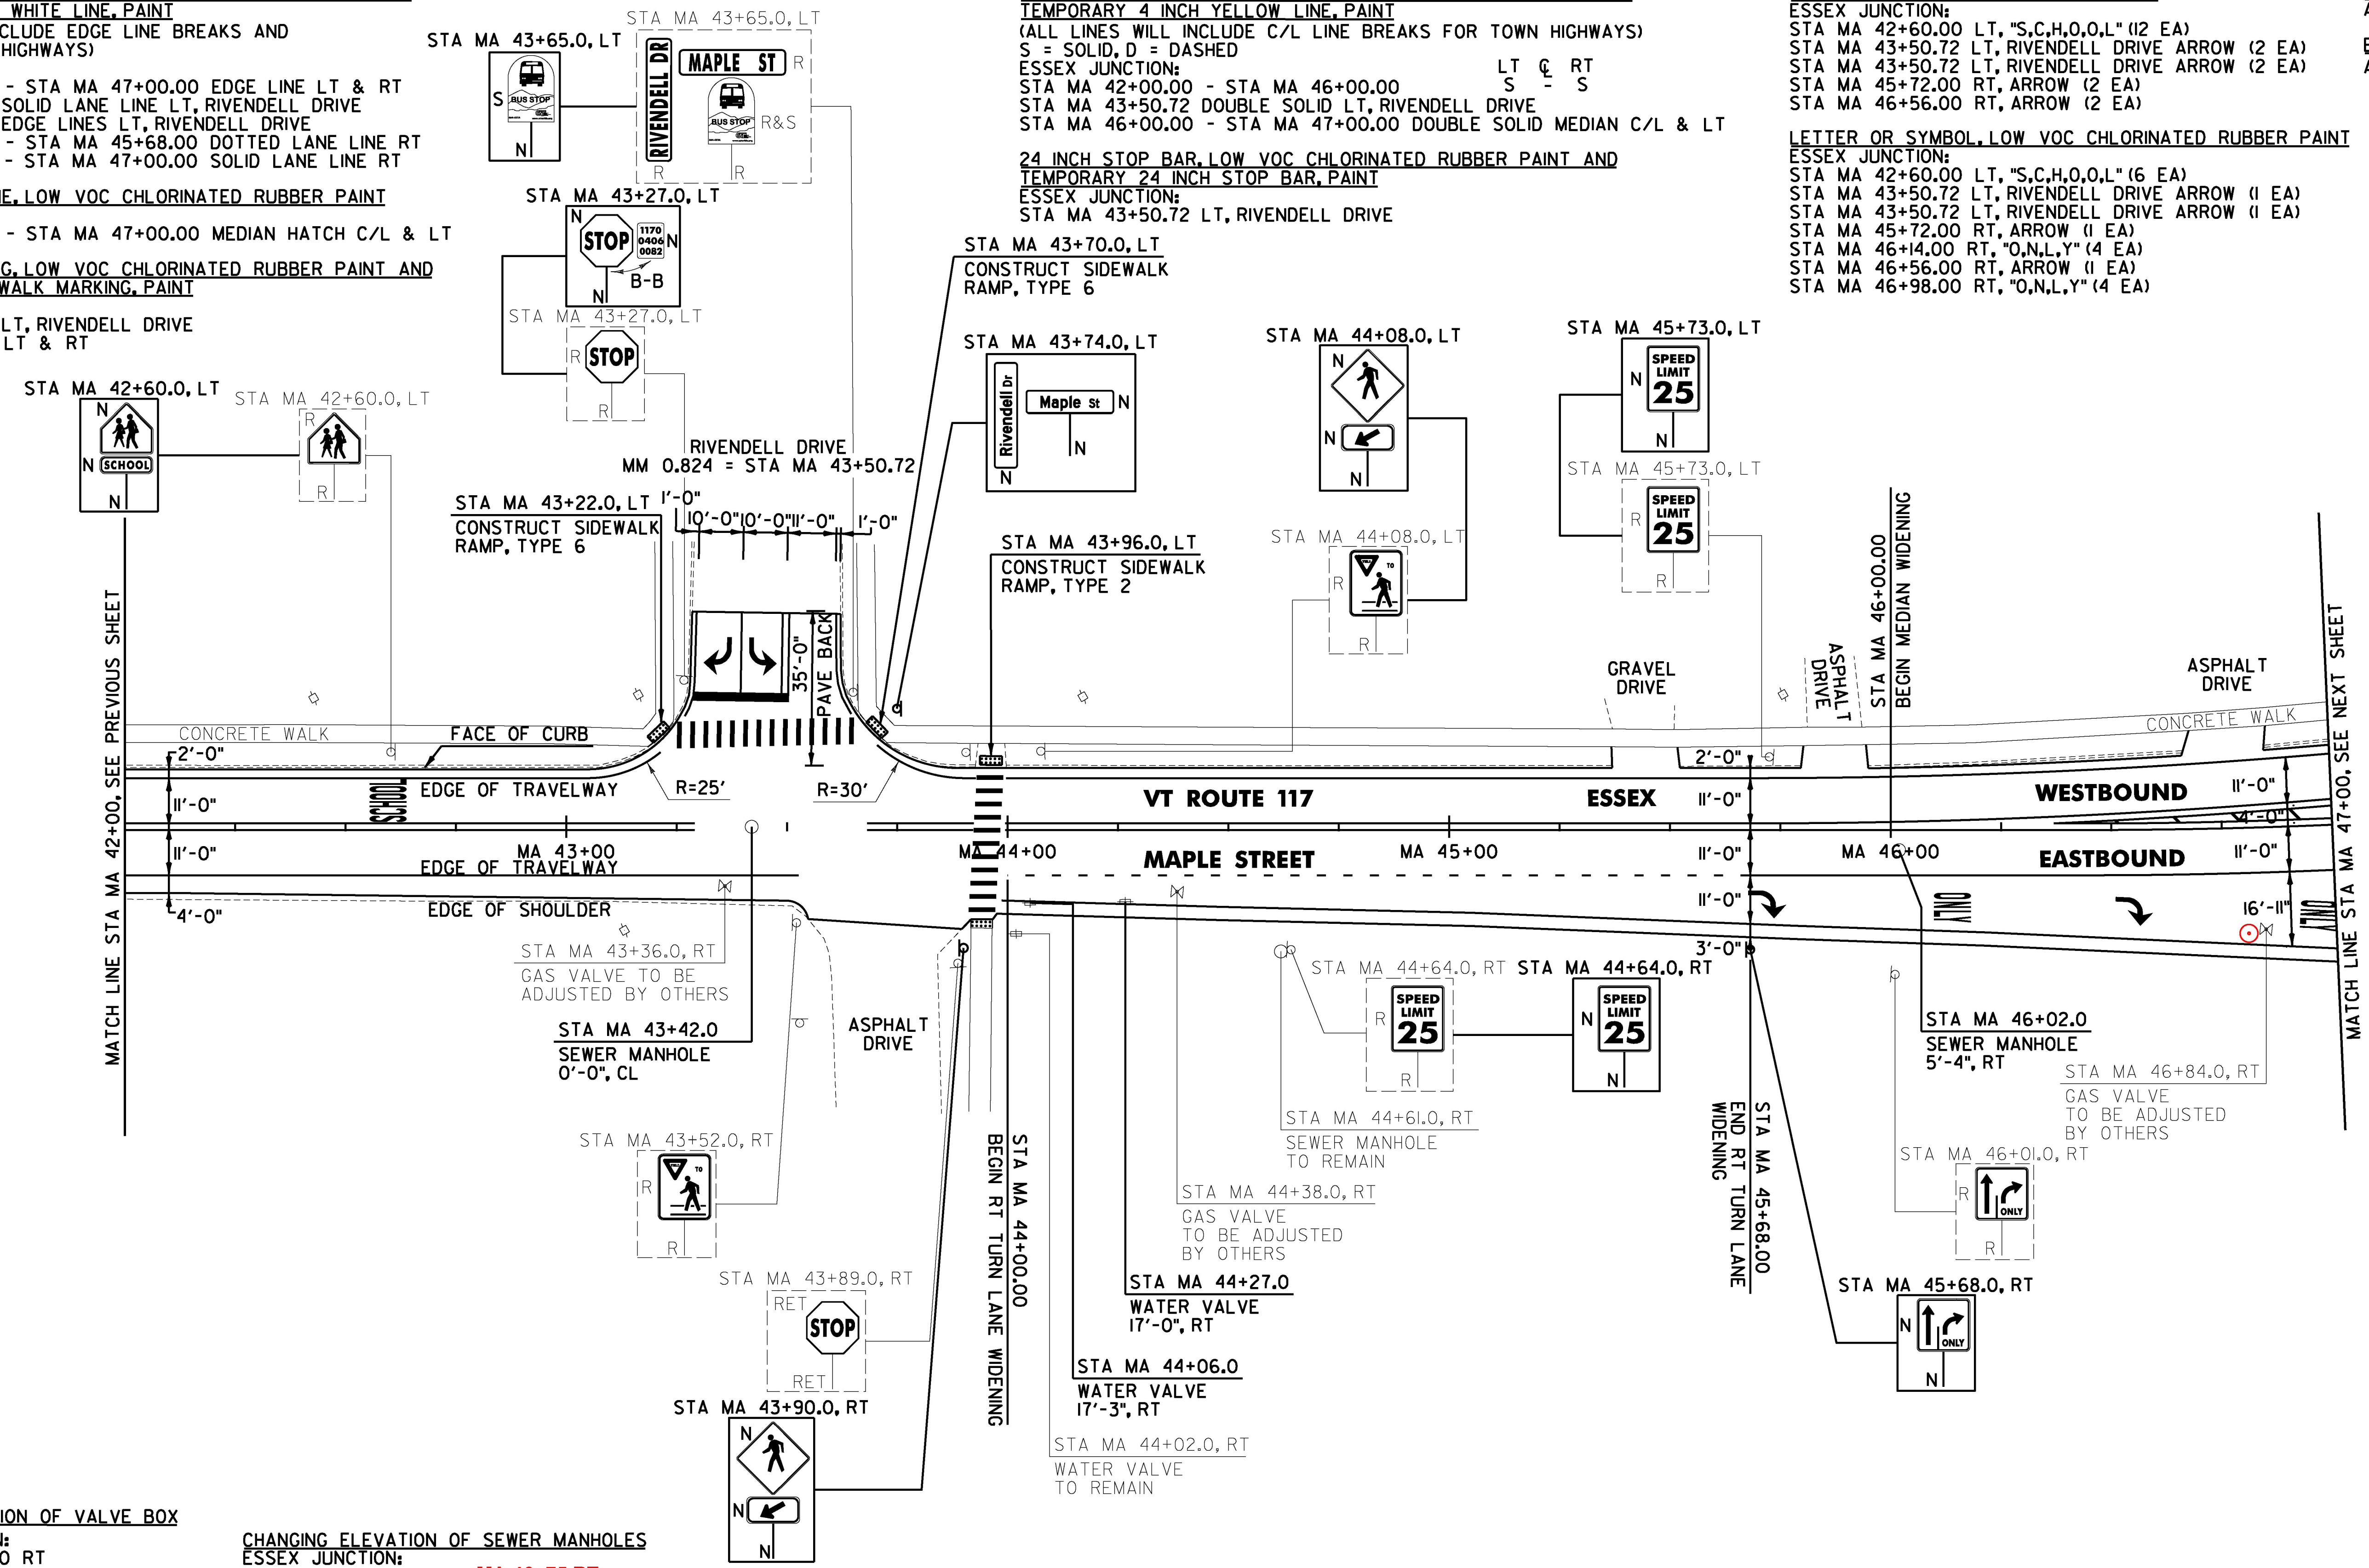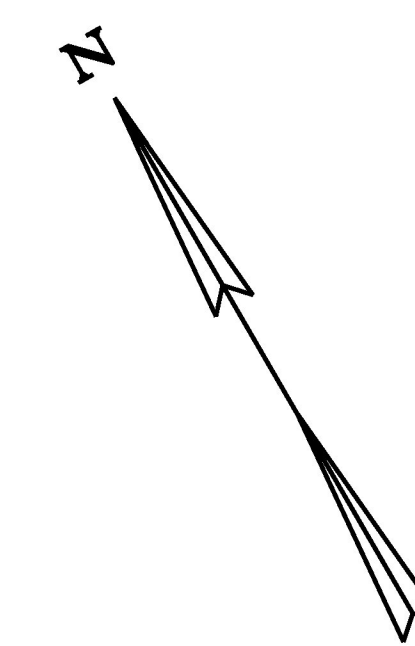

ADJUST ELEVATION OF VALVE BOX

ESSEX JUNCTION:  
 STA MA 44+06.0 RT  
 STA MA 44+27.0 RT

DETECTABLE WARNING SURFACE

ESSEX JUNCTION:  
 STA MA 43+22.0 LT  
 STA MA 43+70.0 LT  
 STA MA 43+96.0 LT

PORTLAND CEMENT CONCRETE

SIDEWALK, 5 INCH  
 ESSEX JUNCTION:  
 STA MA 43+22.0 LT  
 STA MA 43+70.0 LT  
 STA MA 43+96.0 LT

CHANGING ELEVATION OF SEWER MANHOLES

ESSEX JUNCTION:  
~~STA MA 43+42.0 CL~~ MA 46+75 RT  
~~STA MA 46+02.0 RT~~

REMOVAL OF EXISTING CURB

ESSEX JUNCTION:  
~~STA MA 43+22.0 LT~~  
~~STA MA 43+70.0 LT~~  
~~STA MA 43+96.0 LT~~

CAST-IN-PLACE CONCRETE CURB, TYPE B

ESSEX JUNCTION:  
~~STA MA 43+22.0 LT~~  
~~STA MA 43+70.0 LT~~  
~~STA MA 43+96.0 LT~~

REHAB, CLASS 1

MA 43+42 CL  
 MA 46+02 RT

SIGN LEGEND  
 R = REMOVE  
 S = SALVAGE  
 N = NEW  
 RET = RETAIN  
 B-B = BACK TO BACK  
 EXISTING = -----  
 NEW = \_\_\_\_\_  
 R = RETURN TO VILLAGE OF ESSEX JUNCTION

NOT TO SCALE



PROJECT NAME: ESSEX JUNCTION  
 PROJECT NUMBER: NH 2956(2)

FILE NAME: z15v026bdr.dgn  
 PROJECT LEADER: D.GOZALKOWSKI  
 DESIGNED BY: J. SCUDDER  
 PLAN SHEET 32

PLOT DATE: 4/19/2016  
 DRAWN BY: C. KAHLBAUGH  
 CHECKED BY: J. SHIELDS  
 SHEET 114 OF 171