


4 INCH WHITE LINE, LOW VOC CHLORINATED RUBBER PAINT AND TEMPORARY 4 INCH WHITE LINE PAINT
 (ALL LINES WILL INCLUDE EDGE LINE BREAKS AND RADIUS FOR TOWN HIGHWAYS)
 ESSEX JUNCTION:
 STA MA 52+50.00 - STA MA 53+28.00 DOTTED LANE LINE LT
 STA MA 52+50.00 - STA MA 57+50.00 EDGE LINE LT & RT

4 INCH YELLOW LINE, LOW VOC CHLORINATED RUBBER PAINT AND TEMPORARY 4 INCH YELLOW LINE PAINT
 (ALL LINES WILL INCLUDE C/L LINE BREAKS FOR TOWN HIGHWAYS)
 S = SOLID, D = DASHED
 ESSEX JUNCTION:
 STA MA 54+28.00 - STA MA 57+50.00
 STA MA 52+50.00 - STA MA 54+28.00 DOUBLE SOLID MEDIAN LT & C/L

8 INCH YELLOW LINE, LOW VOC CHLORINATED RUBBER PAINT AND ESSEX JUNCTION:
 STA MA 52+50.00 - STA MA 54+28.00 MEDIAN HATCH LT
 Letter or Symbol, Low VOC Chlorinated Rubber Paint
 STA MA 54+01, LT "AHEAD"
 STA MA 54+41, LT "SIGNAL"

REMOVING SIGNS AS SHOWN - 1

N

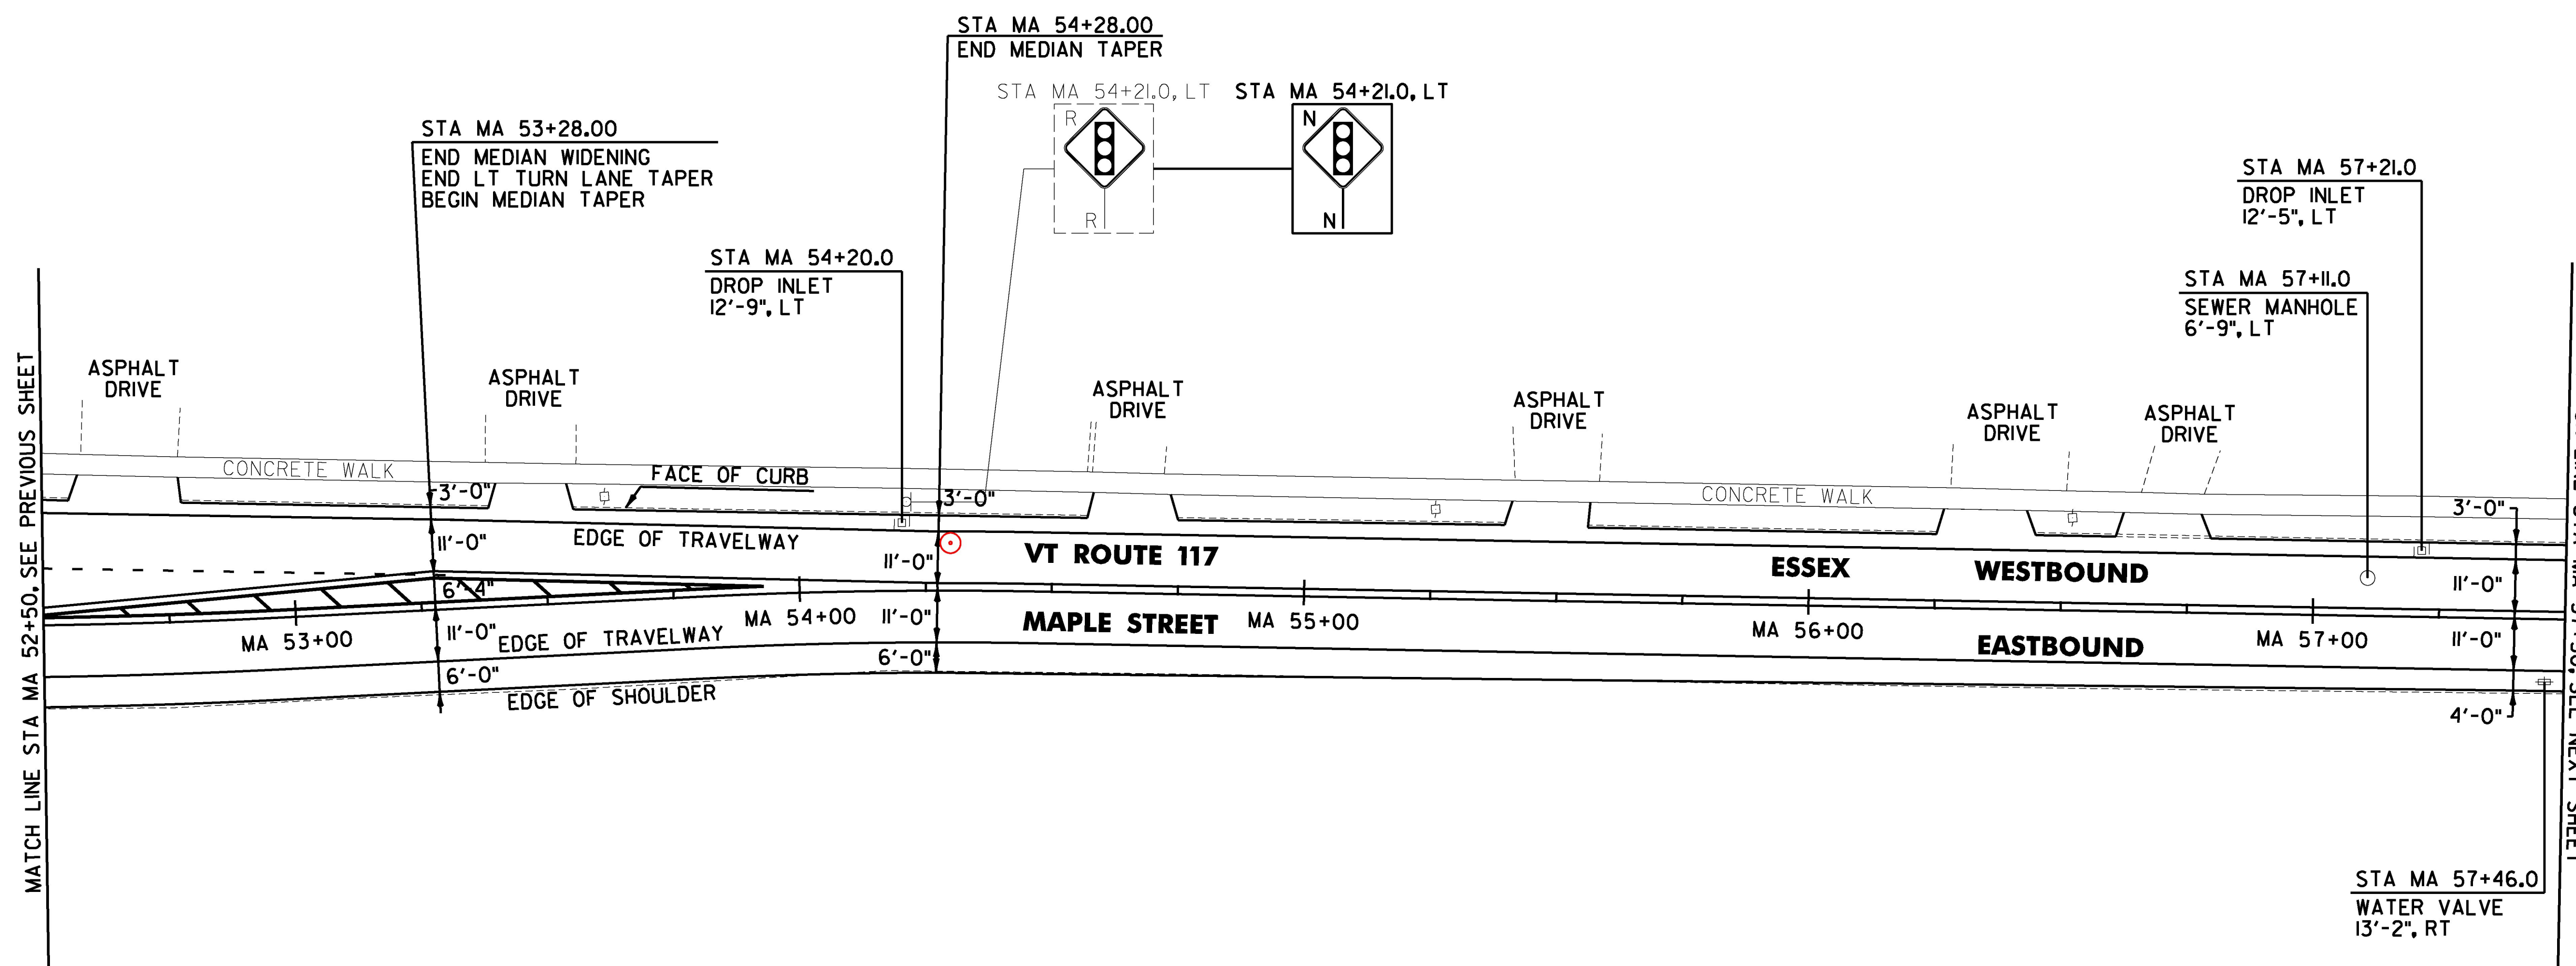

REHAB. DROP INLETS, CATCH BASINS, OR MANHOLES, CLASS I, II, OR III
 ESSEX JUNCTION:
 STA MA 54+20.0 LT MA 54+30 LT
 STA MA 57+21.0 LT MA 57+11 LT

ADJUST ELEVATION OF VALVE BOX
 ESSEX JUNCTION:
 STA MA 57+46.0 RT

CHANGING ELEVATION OF SEWER MANHOLES
 ESSEX JUNCTION:
~~STA MA 57+11.0 LT~~

SIGN LEGEND
 R = REMOVE
 S = SALVAGE
 N = NEW
 RET = RETAIN
 B-B = BACK TO BACK
 EXISTING = _____
 NEW = _____
 R = RETURN TO VILLAGE OF ESSEX JUNCTION

NOT TO SCALE



PROJECT NAME: ESSEX JUNCTION
 PROJECT NUMBER: NH 2956(2)

FILE NAME: z15v026bdr.dgn
 PROJECT LEADER: D.GOZALKOWSKI
 DESIGNED BY: J. SCUDDER
 PLAN SHEET 34

PLOT DATE: 4/19/2016
 DRAWN BY: C. KAHLBAUGH
 CHECKED BY: J. SHIELDS
 SHEET 116 OF 171