
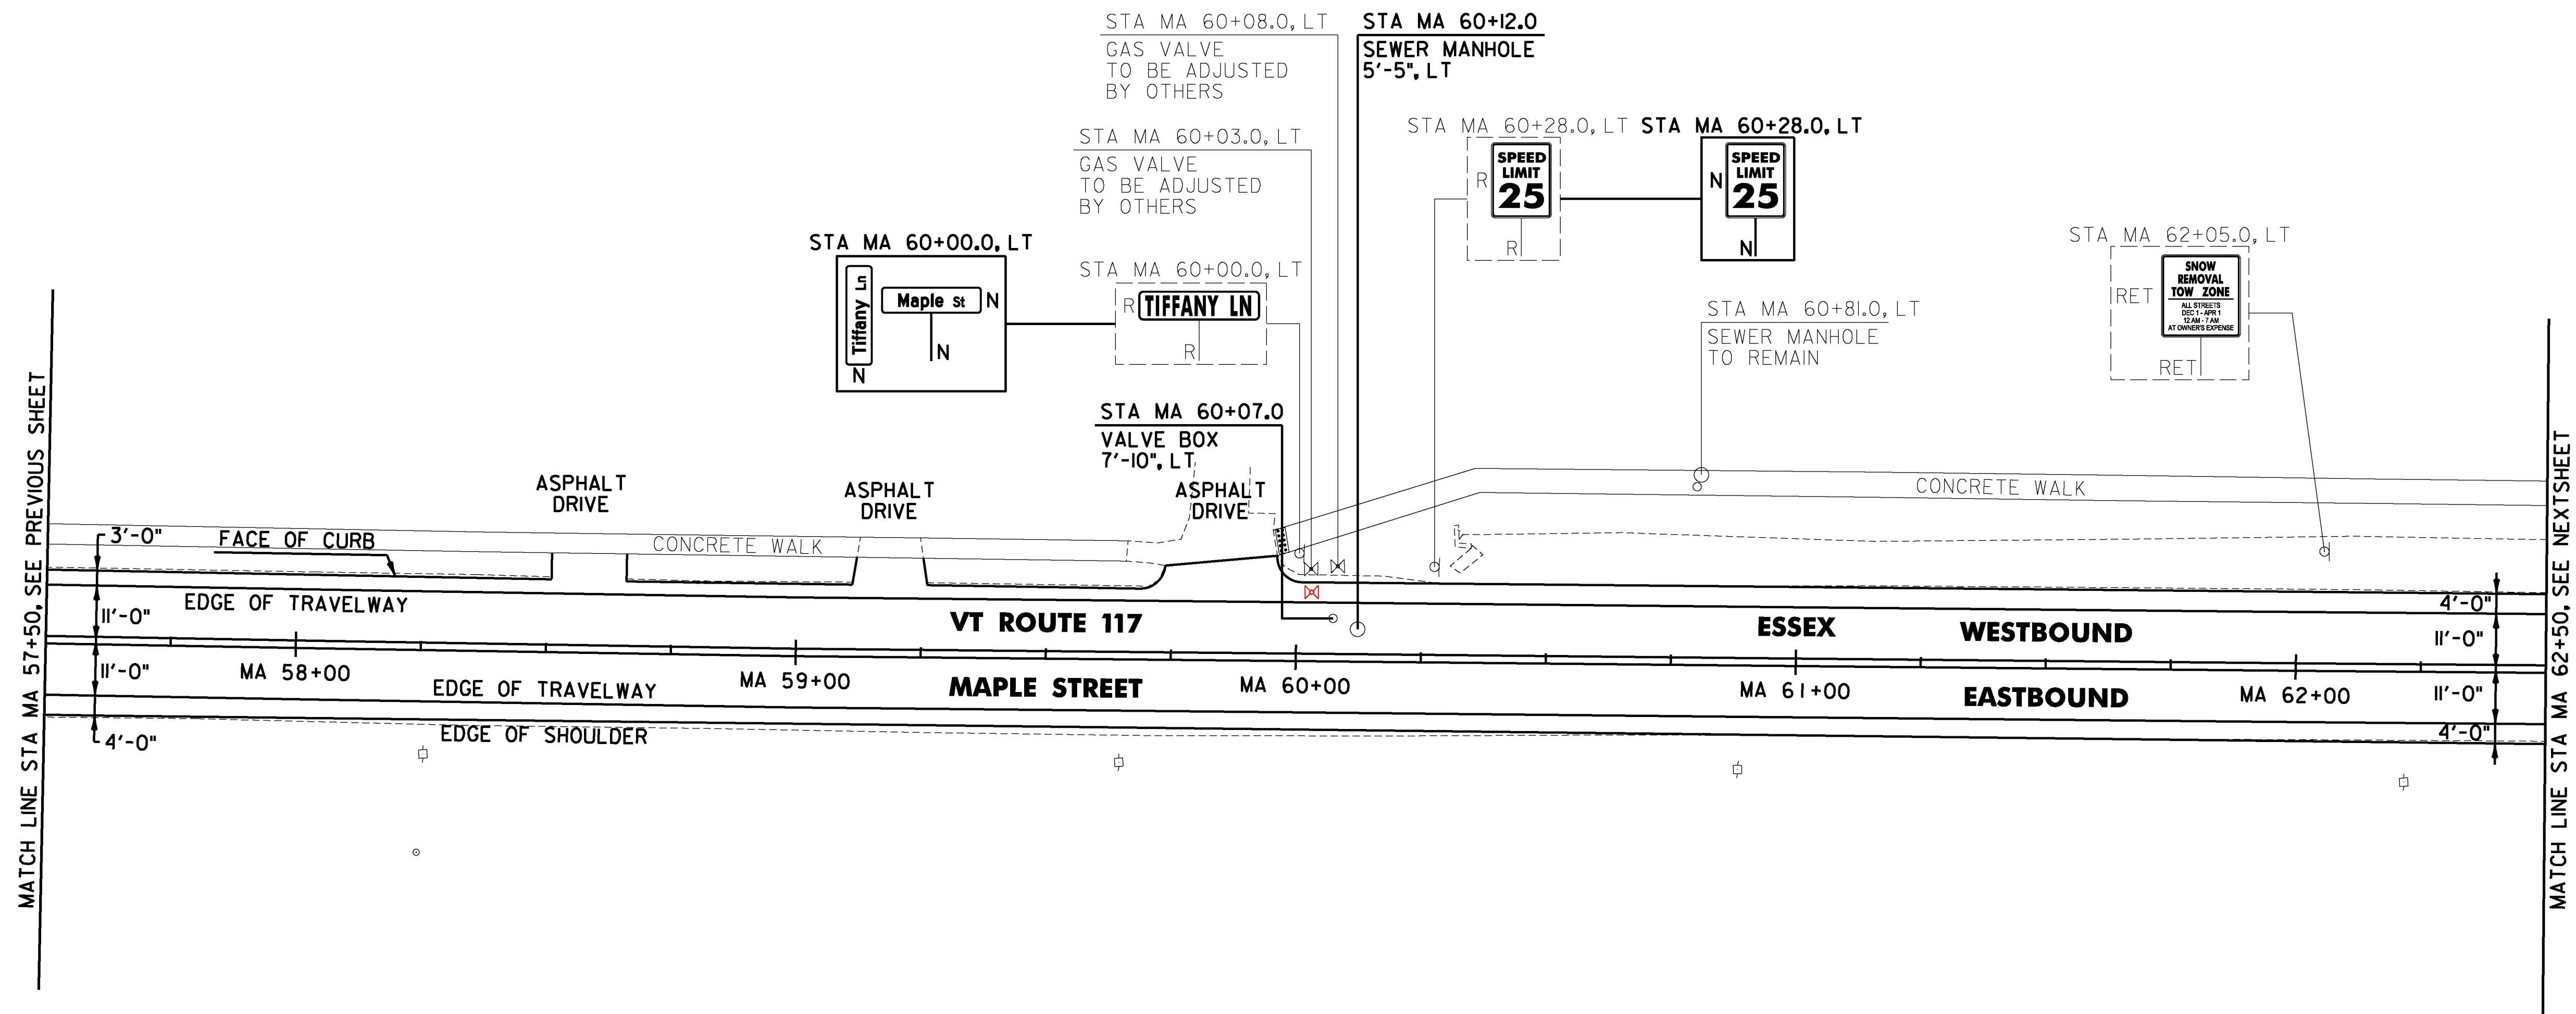


4 INCH WHITE LINE, LOW VOC CHLORINATED RUBBER PAINT AND
 TEMPORARY 4 INCH WHITE LINE, PAINT
 (ALL LINES WILL INCLUDE EDGE LINE BREAKS AND
 RADIUS FOR TOWN HIGHWAYS)
 ESSEX JUNCTION:
 STA MA 57+50.00 - STA MA 62+50.00 EDGE LINE LT & RT

4 INCH YELLOW LINE, LOW VOC CHLORINATED RUBBER PAINT AND
 TEMPORARY 4 INCH YELLOW LINE, PAINT
 (ALL LINES WILL INCLUDE C/L LINE BREAKS FOR TOWN HIGHWAYS)
 S = SOLID, D = DASHED
 ESSEX JUNCTION:
 STA MA 57+50.00 - STA MA 62+50.00 LT & RT
 S - S

REMOVING SIGNS
 AS SHOWN - 2

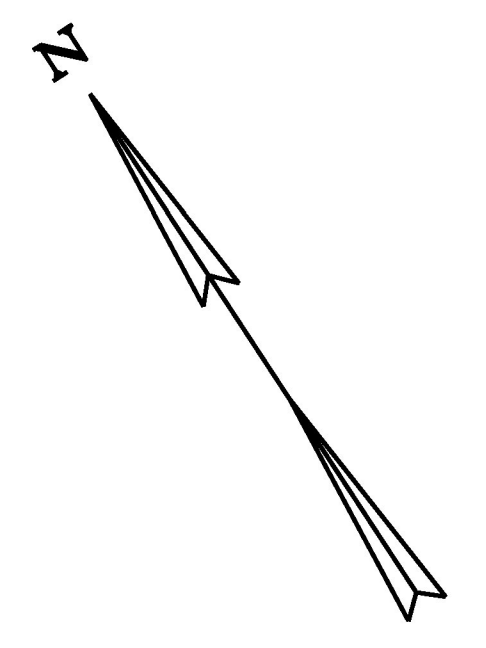

MATCH LINE STA MA 57+50, SEE PREVIOUS SHEET

MATCH LINE STA MA 62+50, SEE NEXT SHEET

CHANGING ELEVATION OF SEWER MANHOLES
 ESSEX JUNCTION:
 STA MA 60+12.0 LT

ADJUST ELEVATION OF VALVE BOX
 ESSEX JUNCTION:
 STA MA 60+07.0 LT **MA 60+03 LT**

SIGN LEGEND
 R = REMOVE
 S = SALVAGE
 N = NEW
 RET = RETAIN
 B-B = BACK TO BACK
 EXISTING = _____
 NEW = _____
 R ⊕ = RETURN TO VILLAGE
 ⊕ = OF ESSEX JUNCTION

NOT TO SCALE



PROJECT NAME: ESSEX JUNCTION
 PROJECT NUMBER: NH 2956(2)

FILE NAME: z15v026bdr.dgn
 PROJECT LEADER: D.GOZALKOWSKI
 DESIGNED BY: J. SCUDDER
 PLAN SHEET 35

PLOT DATE: 4/19/2016
 DRAWN BY: C. KAHLBAUGH
 CHECKED BY: J. SHIELDS
 SHEET 117 OF 171