






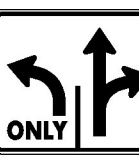






TRAFFIC SIGN SUMMARY SHEET 20

MILEMARKER, STATION, OR SIGN NUMBER	SIGN LEGEND	SIGN DIMENSIONS		NEW & SALVAGED SIGNS				EXIST POST		NEW SIGN POSTS														REMARKS SHSM = FHWA STANDARD HIGHWAY SIGNS AND MARKINGS BOOK	SIGN DETAIL							
		WIDTH (in)	HEIGHT (in)	"A"	SEE NOTE 2	SALV SIGN	SALV TIS	RETA IN	SALV AGE	NO. OF POSTS	FLANGED CHANNEL			SQUARE STEEL (in)			TUBULAR STEEL Ø (in)				W-SHAPE STEEL				DETAIL IN SHSM	DETAIL ON DWG. NUMBER	STD. SHEET NUMBER					
											1.2	2.0	3.0	1.8	2.42	2.5	ANCHOR	SUPPORT	FOUND-ATION	3.0	3.5	4.0	5.0					FTG. SIZE	WEIGHT	POST SIZE		
																															lb/ft	lb/ft
ESSEX JUNCTION VT ROUTE 15 MN 145+66.0, RT	  	1	36	12	3.00	1			2						11.75	X	X									DOUBLE SIDED SIGN, SIGN ID CODE D3-1 TOP MOUNTING BRACKET REQUIRED TO INSTALL SIGN ON POST. COSTS ASSOCIATED WITH THIS BRACKET WILL BE CONSIDERED INCIDENTAL TO THE SIGN POST.		156				
NEW LOCATION MN 145+25 RT		1	54	12	4.50	1												4.0	X							BACK-TO-BACK SIGN ID CODE D3-1		157				
		1	54	12	4.50	1												4.0	X							SIGN ID CODE D3-1		157				
		1	6	10	0.42		1																			SIGN ID CODE VD-700			T-44			
MN 145+67.0, LT	  	1	36	12	3.00				2						11.75	X	X									DOUBLE SIDED SIGN, SIGN ID CODE D3-1 TOP MOUNTING BRACKET REQUIRED TO INSTALL SIGN ON POST. COSTS ASSOCIATED WITH THIS BRACKET WILL BE CONSIDERED INCIDENTAL TO THE SIGN POST.		156				
		1	60	12	5.00																						BACK-TO-BACK SIGN ID CODE D3-1		157			
		1	60	12	5.00																						SIGN ID CODE D3-1		157			
		1	6	10	0.42																					SIGN ID CODE VD-700			T-44			
MN 146+85.0, RT		1	24	24	4.00				1						X	12.75	X											R8-3				
MN 146+92.0, LT		1	36	30	7.50				1						X	13.25	X										SIGN ID CODE VR-922L			E-145A		
MN 147+33.0, RT							1		1						12.25		X									Salvaged sign mounted on new post	-	-	-			
MN 148+25.0, LT							1		1						X	12.50	X									SALVAGED SIGN TO BE MOUNTED ON NEW POST	-	-	-			
MN 149+96.0, RT		1	24	30	5.00				1						X	15.25	X											R2-1				
		1	24	24	4.00																							R8-3				
NOTES: 1. FINAL POST LENGTHS ARE TO BE DETERMINED IN THE FIELD. POST SIZES ARE COMPUTED BASED ON INFORMATION FURNISHED ON THE STANDARD SHEETS AND THE VTRANS "SIGN POST DESIGN GUIDELINE."												LF	LF	LF	LF	LF	EA	LB														
2. SIGN AREAS LABELED IN THIS COLUMN WILL BE PAID FOR UNDER ITEM 900.670 SPECIAL PROVISION (TRAFFIC SIGNS, EXTRUDED).												113.50			8.00																	
												LF			EA			LB				EA		EA		LB						
												TOTALS			SF 21.34			SF 25.00			EA + 6											

PROJECT NAME: ESSEX JUNCTION
PROJECT NUMBER: NH 2956(2)
FILE NAME: z15v026tss.dgn
PROJECT LEADER: D.GOZALKOWSKI
DESIGNED BY: J. SCUDDER
TRAFFIC SIGN SUMMARY SHEET 20

PLOT DATE: 5/2/2016
DRAWN BY: C. KAHLBAUGH
CHECKED BY: J. SHIELDS
SHEET 138 OF 171

