



STATE OF VERMONT
AGENCY OF TRANSPORTATION

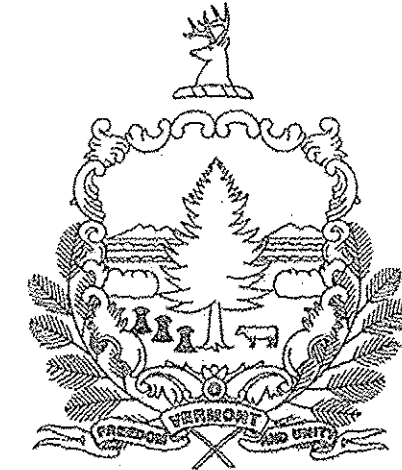

PROPOSED IMPROVEMENT
BRIDGE PROJECT

TOWN OF DANVILLE
COUNTY OF CALEDONIA
US ROUTE 2 BRIDGE NO. 92

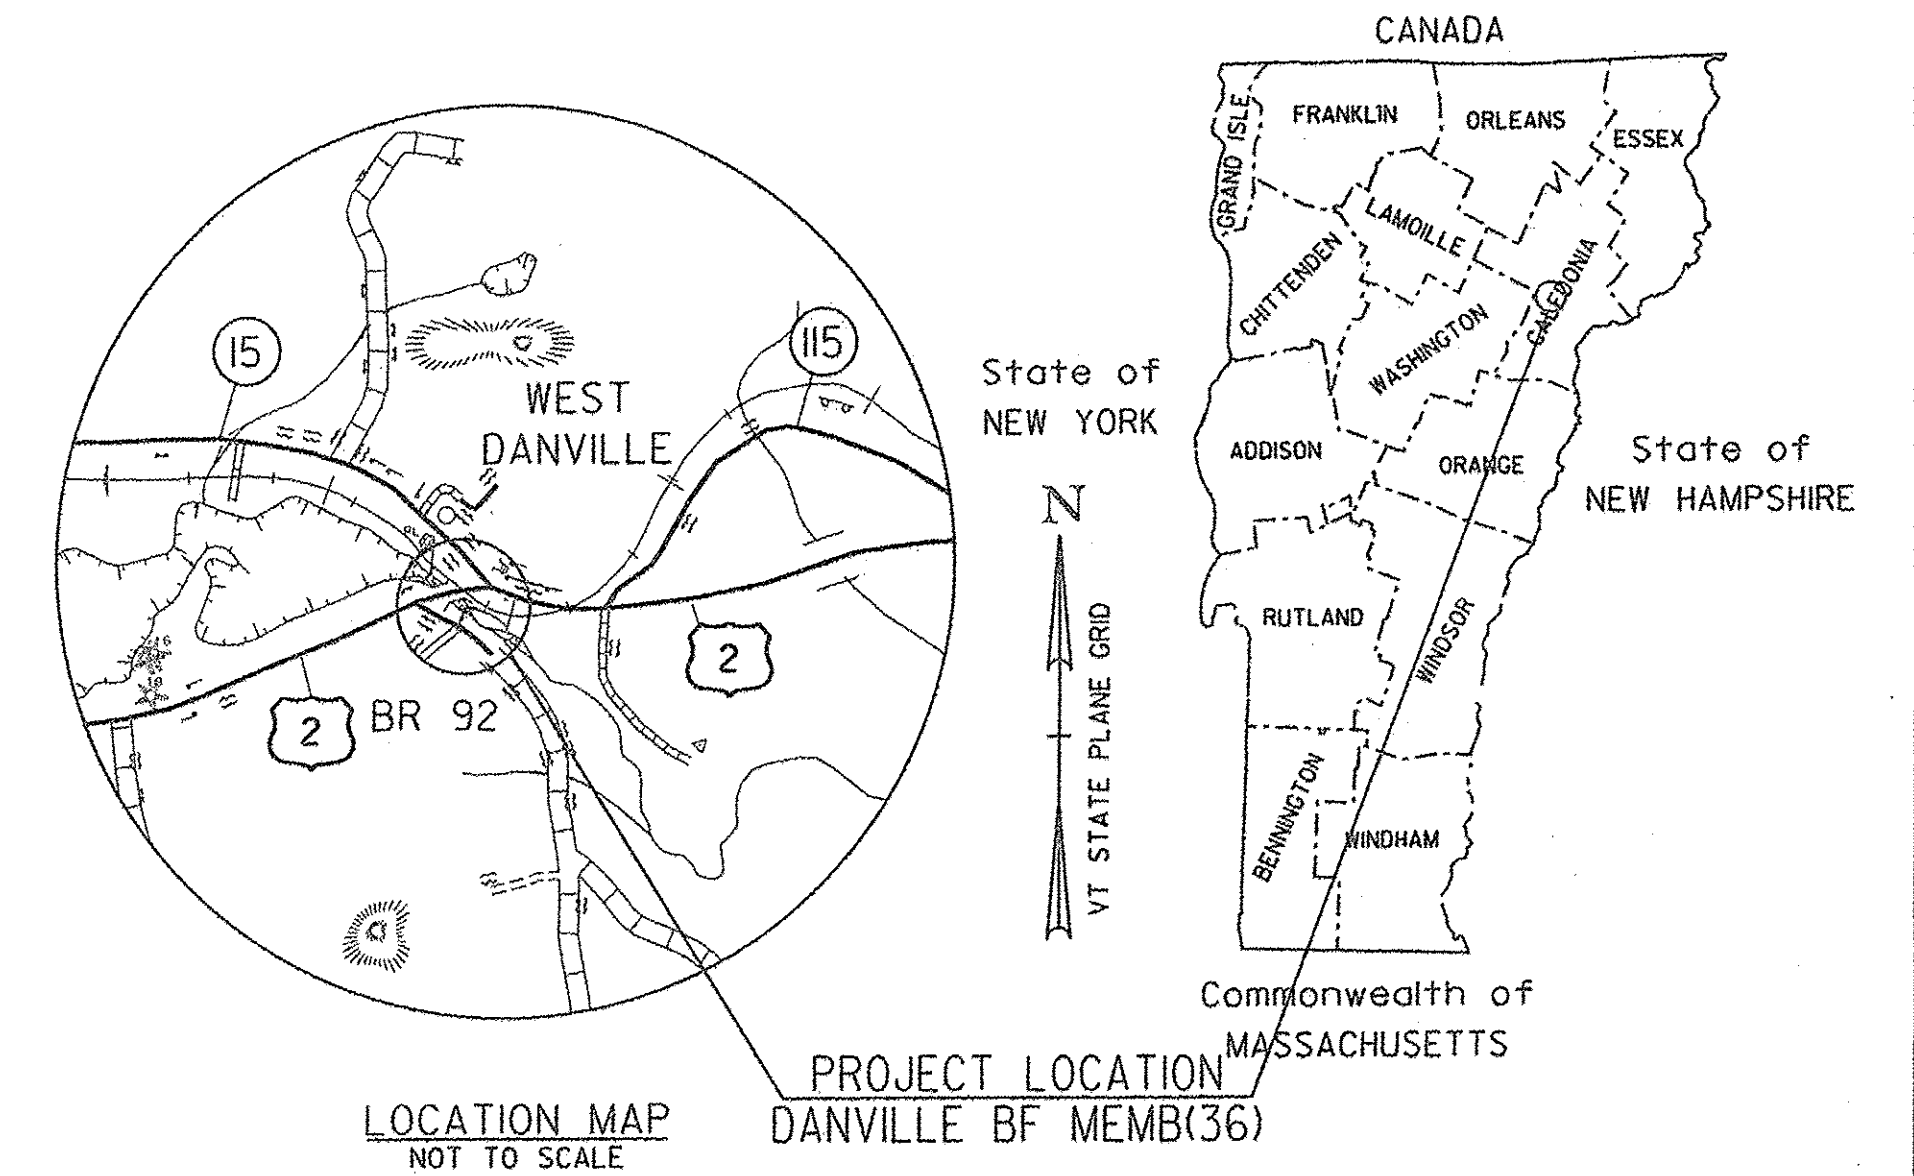


PROJECT LOCATION: BRIDGE 92 IS LOCATED ON US ROUTE 2 (M.M.1.64) OVER JOE'S BROOK IN THE TOWN OF DANVILLE.

PROJECT DESCRIPTION: REMOVAL AND REPLACEMENT OF BITUMINOUS CONCRETE WEARING SURFACE AND MEMBRANE, REPLACING CONCRETE CURB ON UPSTREAM SIDE, REPLACING APPROACH SIDEWALK, AND MINOR ASSOCIATED WORK.

LENGTH OF BRIDGE: 74.00 FEET = 0.014 MILES

RECORD PLANS	
CONTRACTOR:	WINTERSET, INC. - LYNDONVILLE, VT
RESIDENT ENGINEER:	DOUG BUMPS
CONSTRUCTION BEGAN:	SEPTEMBER 5, 2014
CONSTRUCTION COMPLETE:	NOVEMBER 14, 2014
RECORD PLANS BY:	DOUG BUMPS & C. PIERCE
I HEREBY CERTIFY THAT ALL THE CONSTRUCTION REQUIRED BY THIS SET OF DRAWINGS HAS BEEN ACCOMPLISHED AS INDICATED HEREIN.	
BY	<i>Douglas Bumps</i> RESIDENT ENGINEER
DATE	5/26/15
NOTE: Any further information concerning final quantities, amounts or other details relative to this project may be found at Central Files in the electronic archives.	

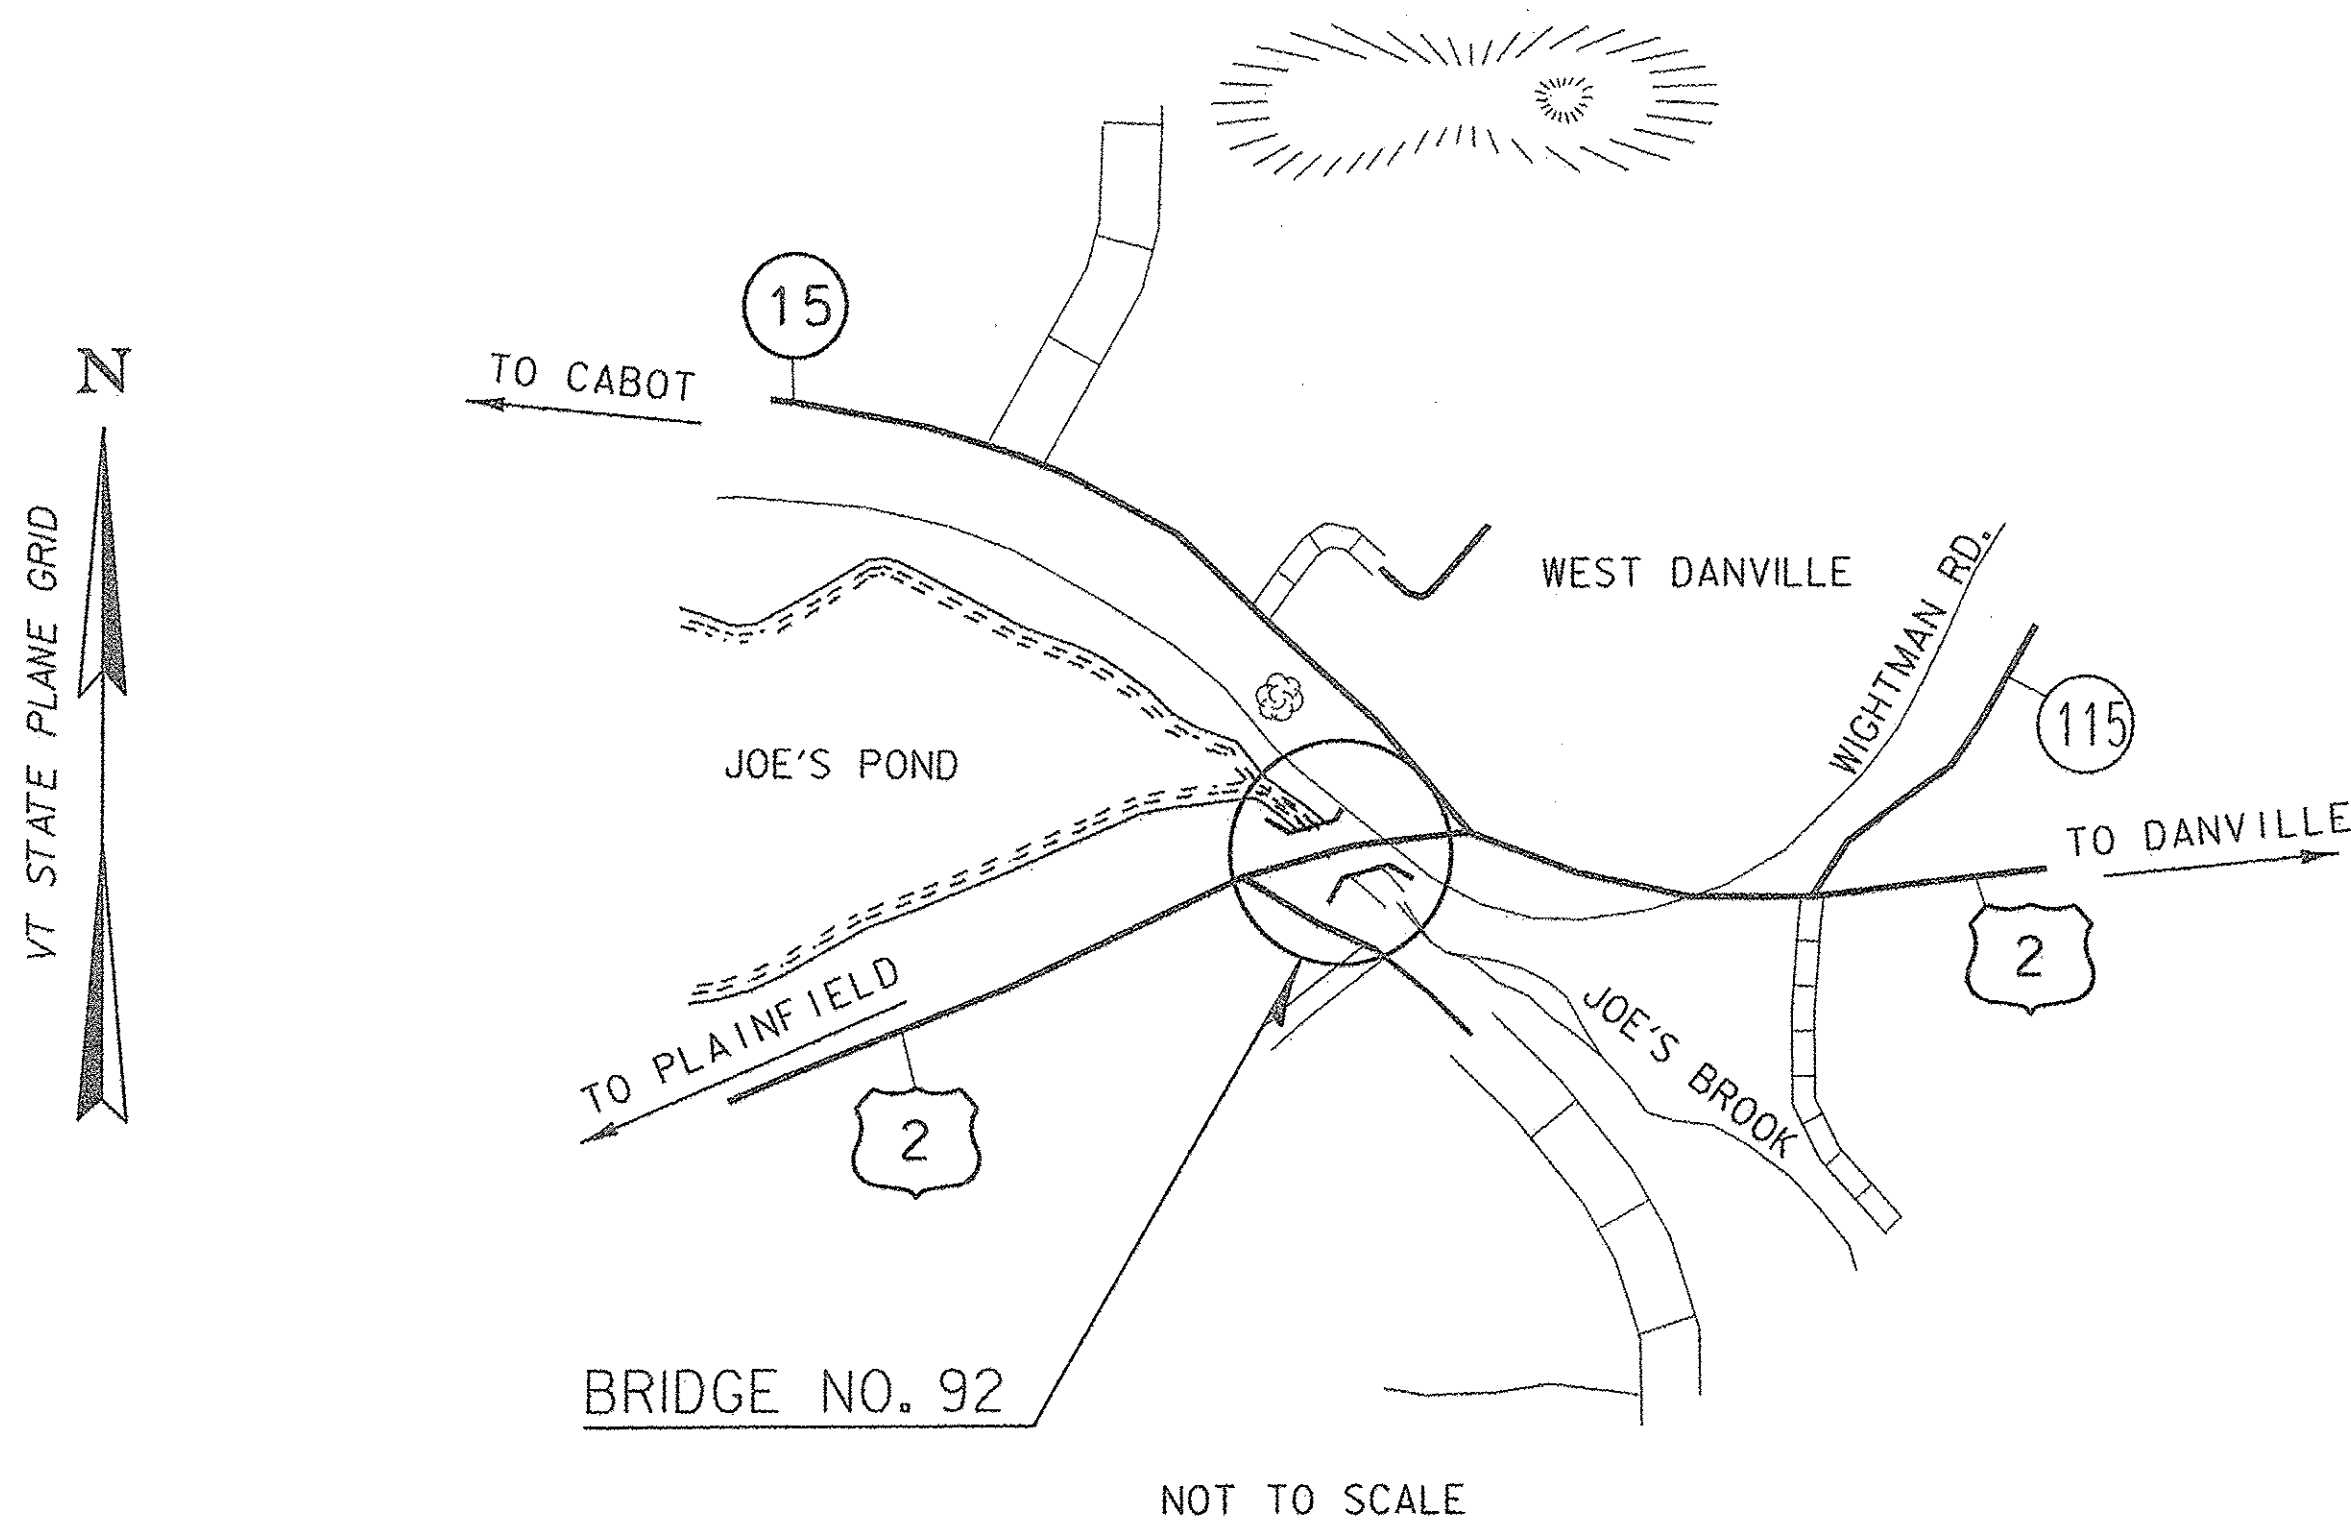

THESE PLANS ARE SUBJECT TO SUCH ENGINEERING CHANGES AS MAY BE REQUIRED BY THE FEDERAL HIGHWAY ADMINISTRATION OR THE DIRECTOR OF PROGRAM DEVELOPMENT.

CONSTRUCTION IS TO BE CARRIED ON IN ACCORDANCE WITH THESE PLANS AND THE STANDARD SPECIFICATIONS FOR CONSTRUCTION DATED 2011, AS APPROVED BY THE FEDERAL HIGHWAY ADMINISTRATION ON JULY 20, 2011 FOR USE ON THIS PROJECT, INCLUDING ALL SUBSEQUENT REVISIONS AND SUCH REVISED SPECIFICATIONS AND SPECIAL PROVISIONS AS ARE INCORPORATED IN THESE PLANS.

QUALITY ASSURANCE PROGRAM : LEVEL I	
SURVEYED BY :	N/A
SURVEYED DATE :	N/A
DATUM	
VERTICAL	N/A
HORIZONTAL	N/A

6/6/14

Stantec
Stantec Consulting Services Inc.
55 Green Mountain Drive
South Burlington VT U.S.A. 05403
Phone: (802) 864-0223
Fax: (802) 864-0165
www.stantec.com

DIRECTOR OF PROGRAM DEVELOPMENT
APPROVED *[Signature]* DATE 6/9/14

PROJECT MANAGER : DOUG BONNEAU

PROJECT NAME : DANVILLE
PROJECT NUMBER : BF MEMB(36)

SHEET 1 OF 22 SHEETS