

INDEX OF SHEETS

- 1. TITLE SHEET
- 2. DETAIL SHEET
- 3. QUANTITY SHEET
- 4. ITEM DETAIL SHEET


STANDARDS

E-193	08-18-1995
T-1	08-06-2012
T-10	08-06-2012
T-24	08-06-2012
T-28	08-06-2012
T-29	08-06-2012
T-30	08-06-2012

STATE OF VERMONT AGENCY OF TRANSPORTATION



PROPOSED IMPROVEMENT STATEWIDE COUNTIES OF WINDSOR, WINDHAM AND RUTLAND VT ROUTE 103 (PRINCIPAL ARTERIAL)

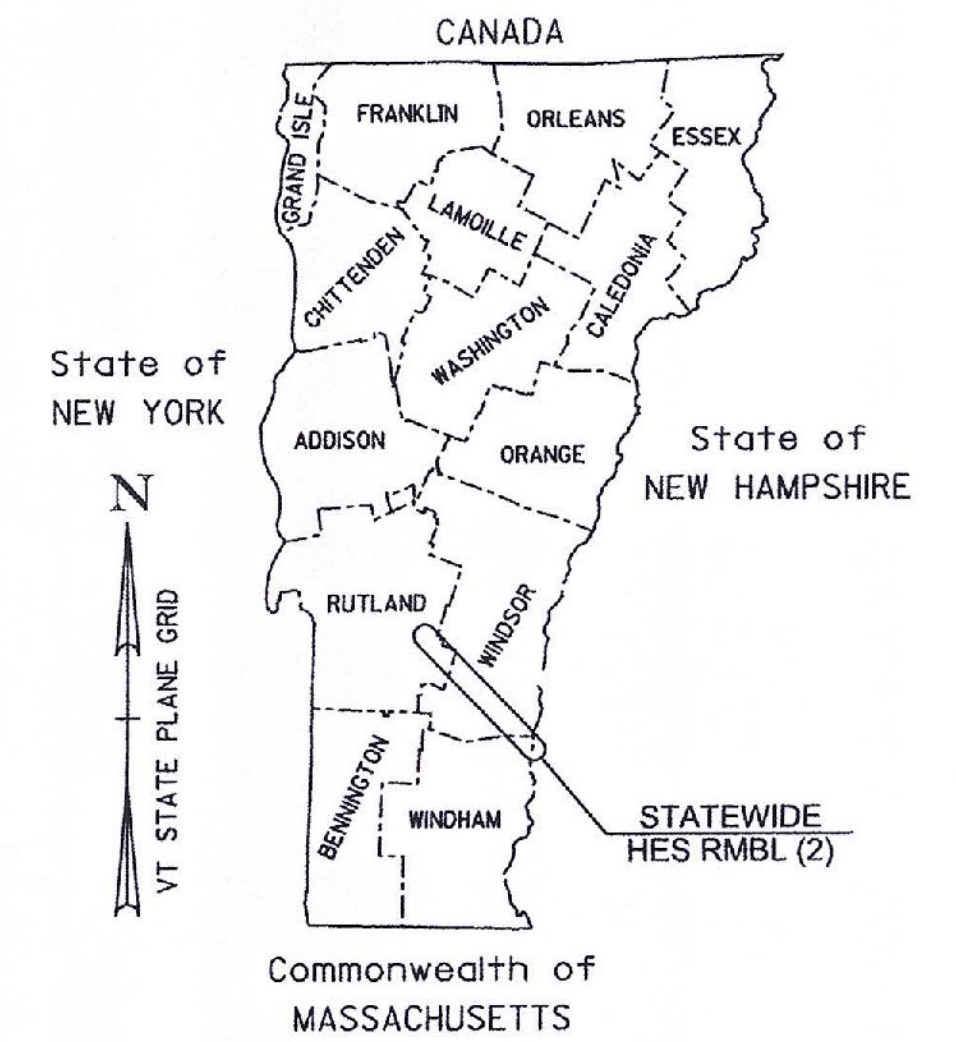


RECORD PLANS	
CONTRACTOR:	KUBRICKY CONSTRUCTION CORP. - WILTON, NY
RESIDENT ENGINEER:	PAUL PERRY
CONSTRUCTION BEGAN:	OCTOBER 30, 2014
CONSTRUCTION COMPLETE:	NOVEMBER 6, 2014
RECORD PLANS BY:	PAUL PERRY & PERCY BANNERMAN
I HEREBY CERTIFY THAT ALL THE CONSTRUCTION REQUIRED BY THIS SET OF DRAWINGS HAS BEEN ACCOMPLISHED AS INDICATED HEREIN.	
BY	<i>Paul V. Perry</i> RESIDENT ENGINEER
DATE	5/12/15
NOTE: Any further information concerning final quantities, amounts or other details relative to this project may be found at Central Files in the electronic archives.	

PROJECT LOCATION: BEGINNING IN THE TOWN OF ROCKINGHAM ON VT ROUTE 103 AT MM 0.550 AND EXTENDING NORTHERLY 29.914 MILES TO MM 1.980 IN THE TOWN OF CLARENDON.

PROJECT LENGTH:	ROCKINGHAM	CHESTER	CAVENDISH	LUDLOW	MOUNT HOLLY	WALLINGFORD	SHREWSBURY	CLARENDON	TOTAL
	30624 FEET	31601 FEET	18744 FEET	14995 FEET	40566 FEET	1162 FEET	10380 FEET	9874 FEET	157946 FEET
	5.800 MILES	5.985 MILES	3.550 MILES	2.840 MILES	7.683 MILES	0.220 MILES	1.966 MILES	1.870 MILES	29.914 MILES

PROJECT INFORMATION: THE PROJECT SHALL CONSIST OF THE INSTALLATION OF NEW 12" END HES RMBL (2) CLARENDON (MM 1.980) CENTERLINE RUMBLE STRIPS AND CENTERLINE PAVEMENT MARKINGS.

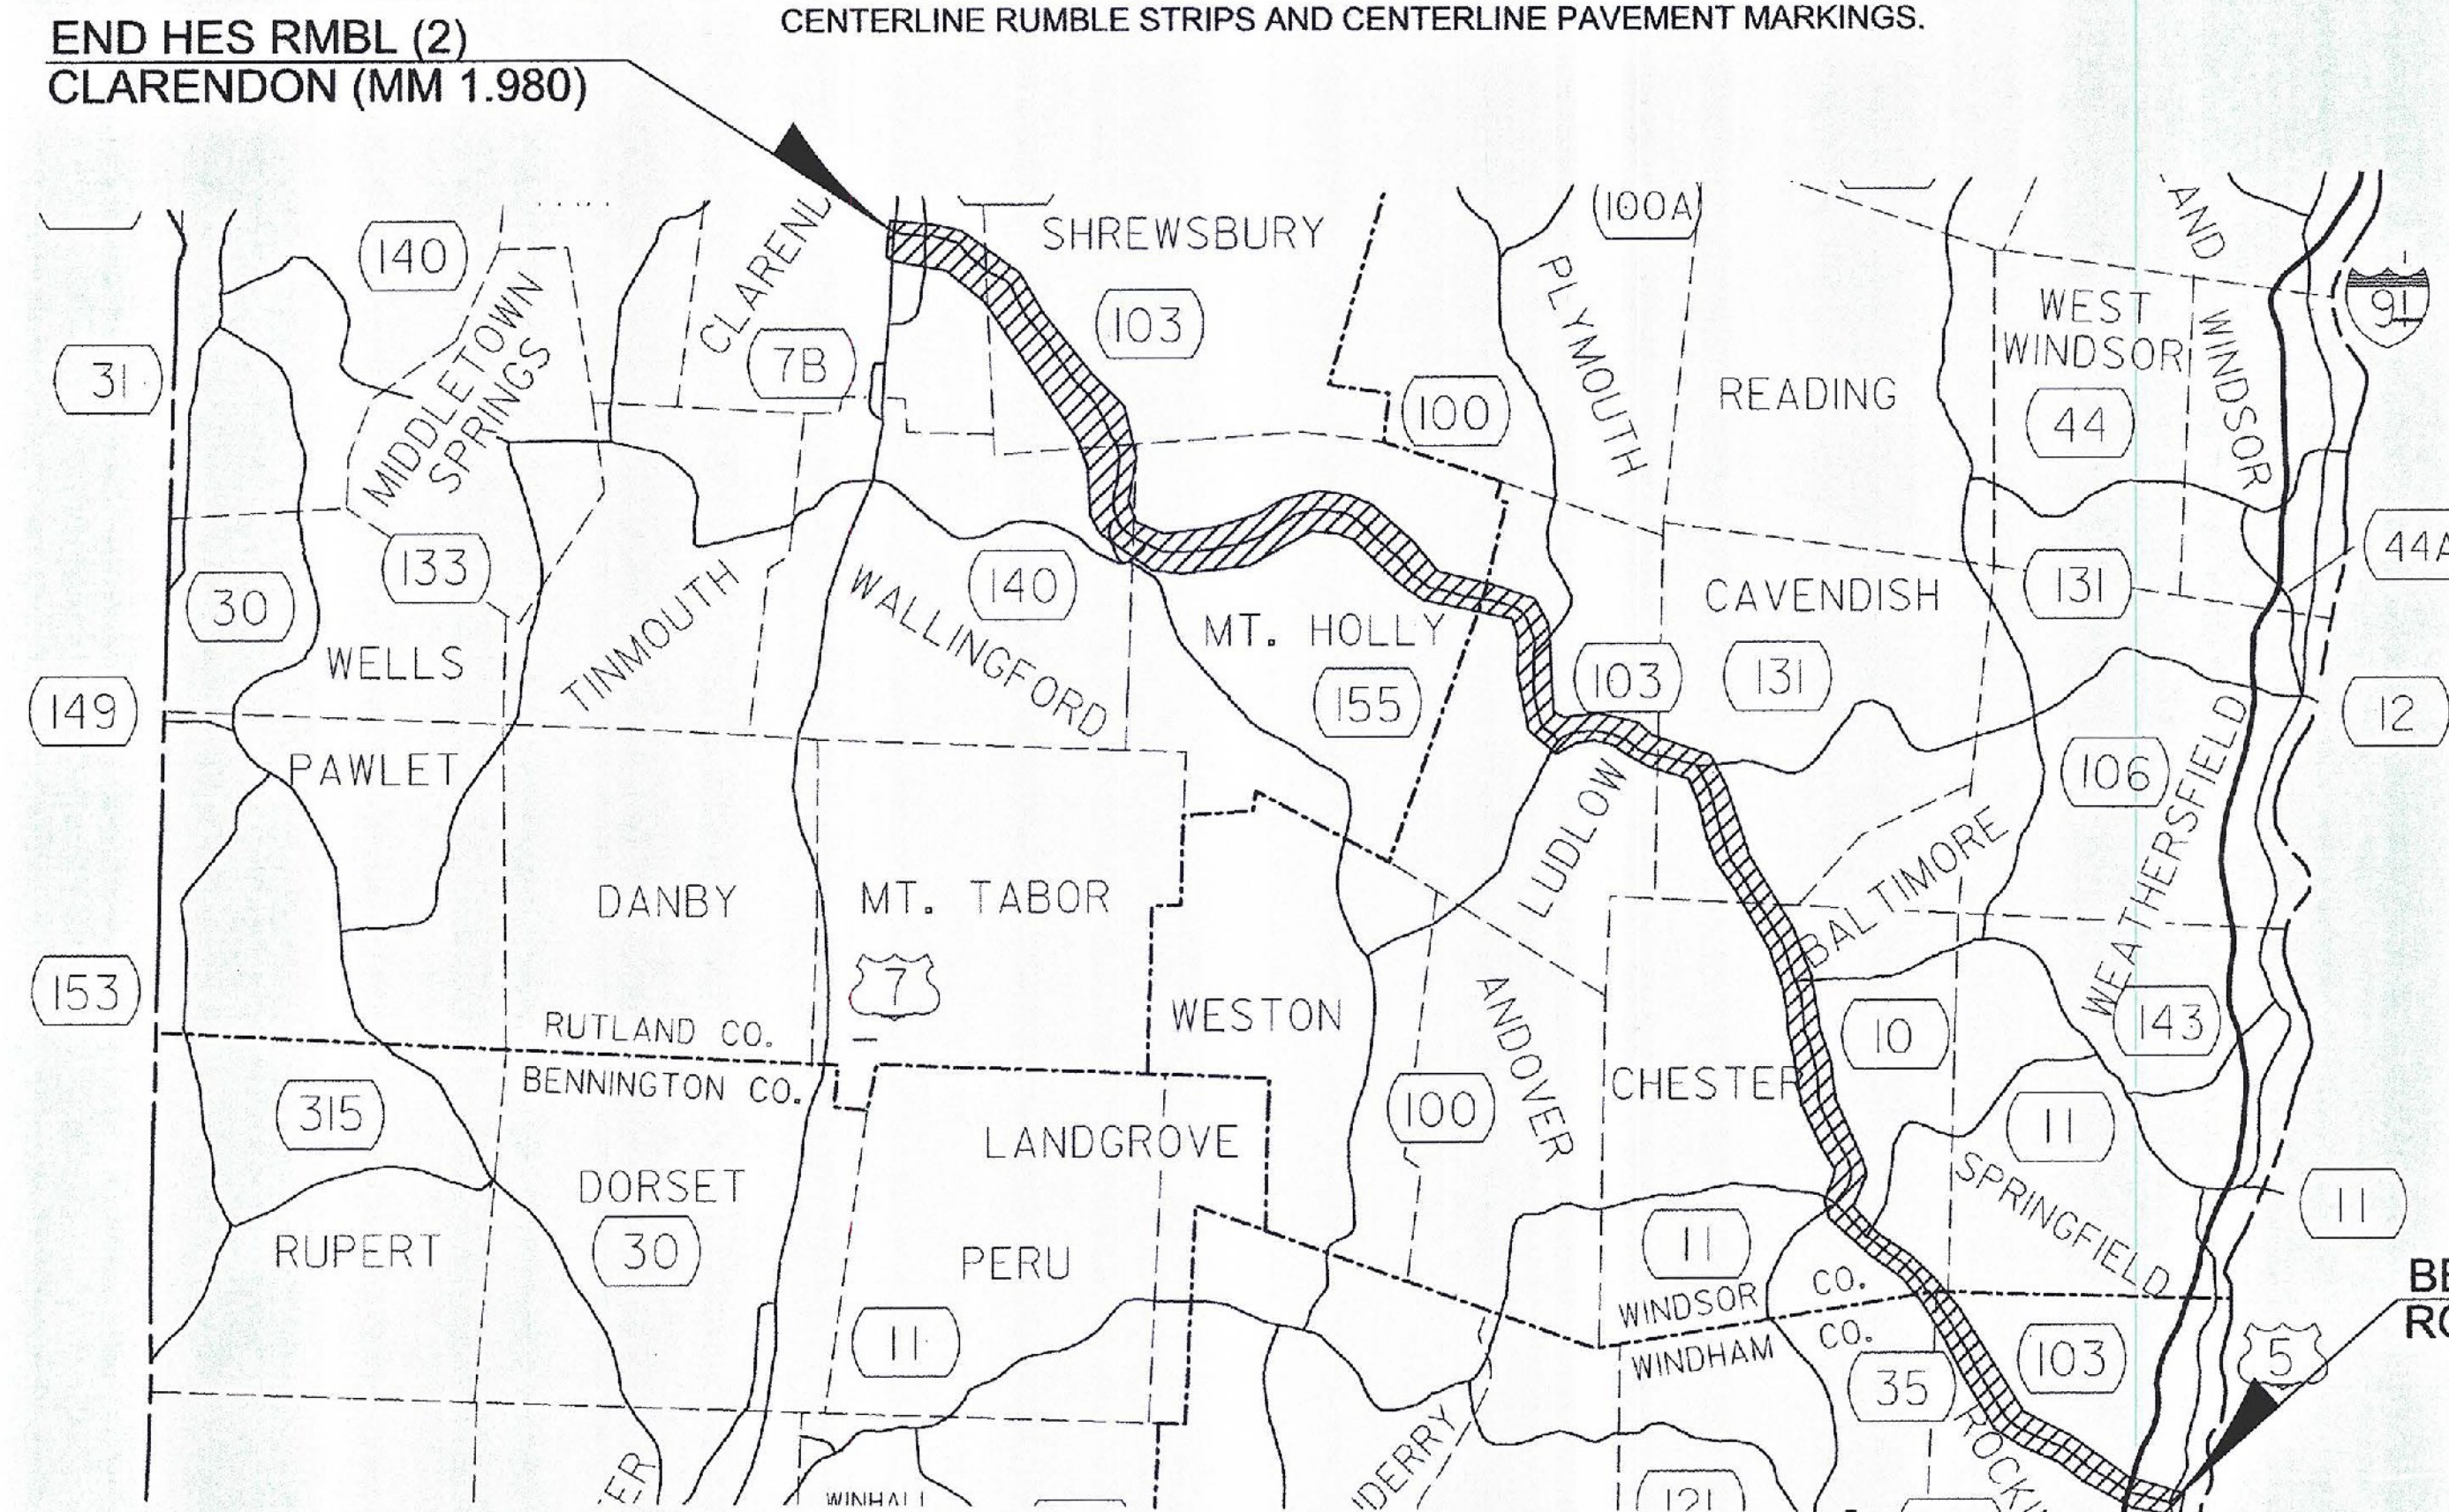

THESE PLANS ARE SUBJECT TO SUCH ENGINEERING CHANGES AS MAY BE REQUIRED BY THE FEDERAL HIGHWAY ADMINISTRATION OR THE DIRECTOR OF PROGRAM DEVELOPMENT.

CONSTRUCTION IS TO BE CARRIED ON IN ACCORDANCE WITH THESE PLANS AND THE STANDARD SPECIFICATIONS FOR CONSTRUCTION DATED 2011, AS APPROVED BY THE FEDERAL HIGHWAY ADMINISTRATION ON JULY 20, 2011 FOR USE ON THIS PROJECT, INCLUDING ALL SUBSEQUENT REVISIONS AND SUCH REVISED SPECIFICATIONS AND SPECIAL PROVISIONS AS ARE INCORPORATED IN THESE PLANS.

QUALITY ASSURANCE PROGRAM : LEVEL I	
SURVEYED BY :	N/A
SURVEYED DATE :	N/A
DATUM	
VERTICAL	N/A
HORIZONTAL	N/A

DIRECTOR OF PROGRAM DEVELOPMENT	
APPROVED	<i>Patricia Coburn</i> DATE 5-21-14
PROJECT MANAGER : PATRICIA COBURN, P.E.	
PROJECT NAME :	STATEWIDE
PROJECT NUMBER :	HES RMBL (2)
SHEET 1 OF 4 SHEETS	