
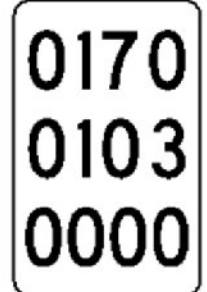
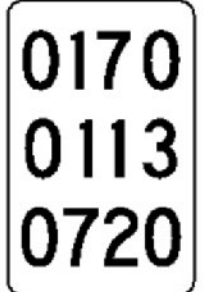

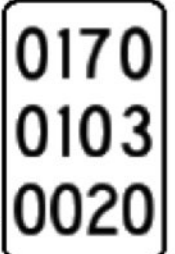



DIRECTION	MILEPOINT	LOCATION CODE (SHEET 3)	SIGN CODE	WIDTH (IN)	HEIGHT (IN)	SHEETING REMARKS	SIGN LEGEND	NEW SIGNS		EXISTING SIGNS				EXIST POST		NUMBER OF NEW POSTS	SQUARE STEEL (IN)			TUBULAR STEEL Ø (IN)				SIGN FRAME REQUIRED	REMARKS	SIGN DETAIL LOCATION			
								"A"	"B"	RETAIN	SALVAGE FROM	SALVAGE TO	REMOVE	RETAIN	REMOVE		1.75	2.00	2.50	FOUNDATION						SHSM	PROJECT SHEET #	STANDARD SHEET #	
																	(LB / FT)			3.00	3.50	4.00	5.00						(LB / FT)
EB BRISTOL VT 17							FY-FLUORESCENT YELLOW FYG-FLUORESCENT YELLOW GREEN																"SHSM"-STANDARD HIGHWAY SIGNS AND MARKINGS BOOK						
EB	0.000	C	VD-024	72	10		Bristol / New Haven						1		X														
		C	VD-700	6	8		MILE MARKER 0170 / 0103 / 0000 (BRISTOL)						1																
		C	VD-700	6	8		MILE MARKER 0170 / 0113 / 0721 (NEW HAVEN)						1																
		C	VD-024	72	10			5.00								2			13.25	13.25							11		
		C	VD-700	6	10			0.42																				T-44	
		C	VD-700	6	10			0.42																				T-44	
EB	0.012	A	R2-1	24	30								1		X														
		A	R2-1	30	36			7.50								1			13.00							X			
EB	0.034						EMPTY POST						1		X													REMOVE POST. PAID FOR AS ITEM 675.13, REMOVING SIGNS.	
EB	0.191	A	VD-062B	72	16		OFFICIAL BUSINESS DIRECTIONAL SIGN			1					X													RED CEDAR SCHOOL	
		A	VD-700	6	8		MILE MARKER 0170 / 0103 / 0020						1																
EB	0.200	A	VD-700	6	10			0.42								1			7.00									INSTALL 50 FT ± EAST OF EXISTING SIGN AT MP 0.191	
EB	0.390	A	VW-133R	30	30								1		X														
		A	VW-054R	30	30			6.25								1			14.75									E-154	
SIGN SUMMARY SHEET							SHEET TOTALS	20.01 20.00	0.00	1	0	0	7	0	0	5			70.0	61.25	0	0.0	0.0	0.0	0.0				PROJECT NAME: STATEWIDE-SOUTHWEST PROJECT NUMBER: STPG SIGN(51)
VERMONT AGENCY OF TRANSPORTATION							TOWN DIRECTIONAL TOTALS	129.9	0.0	4	1	1	33	0	0	20			275.0		0		0.0						FILE NAME: z13e624ts bristol EB PROJECT MANAGER: C. BEAN DESIGNED BY: S. GOODWIN BRISTOL VT-17 EASTBOUND 1
																												PLOT DATE: 4/28/2015 DRAWN BY: S. GOODWIN CHECKED: D. MUNRO SHEET 29 OF 121	