

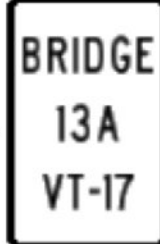
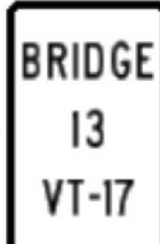









DIRECTION	MILEPOINT	LOCATION CODE (SHEET 3)	SIGN CODE	WIDTH (IN)	HEIGHT (IN)	SHEETING REMARKS	SIGN LEGEND	NEW SIGNS		EXISTING SIGNS				EXIST POST		NUMBER OF NEW POSTS	SQUARE STEEL (IN)			TUBULAR STEEL Ø (IN)				SIGN FRAME REQUIRED	REMARKS	SIGN DETAIL LOCATION		
								"A"	"B"	RETAIN	SALVAGE FROM	SALVAGE TO	REMOVE	RETAIN	REMOVE		1.75	2.00	2.50	FOUNDATION						SHSM	PROJECT SHEET #	STANDARD SHEET #
																	(LB / FT)			3.00	3.50	4.00	5.00					
<b>WB BRISTOL VT 17</b>							FY-FLUORESCENT YELLOW FYG-FLUORESCENT YELLOW GREEN																"SHSM"-STANDARD HIGHWAY SIGNS AND MARKINGS BOOK					
WB	2.273	F	VD-701	6	8																							
		F	VD-701	6	10			0.42																			T-42	
WB	2.240	F	VW-285	36	36																							
		F	VW-285	30	30			6.25																		7		
WB	1.970	F	VD-701	6	8																							
		F	VD-701	6	10			0.42																			T-42	
WB	1.655	F	VD-701	6	8																							
		F	VD-701	6	10			0.42																			T-42	
WB	1.000	F	W1-2R	30	30	FY		6.25																				
		F	W13-1P	18	18	FY		2.25																				
WB	0.974	F	W1-8	18	24	FY		3.00																				
		E	W1-8	18	24	FY		3.00																				
WB	0.951	F	W1-8	18	24	FY		3.00																				
		E	W1-8	18	24	FY		3.00																				
WB	0.929	F	W1-8	18	24	FY		3.00																				
<b>SIGN SUMMARY SHEET</b>							<b>SHEET TOTALS</b>	31.01 34.00	0.00	0	0	0	4	0	0	9	110.00 120.00	0	0.0	0.0	0.0	0.0	0.0	PROJECT NAME: STATEWIDE-SOUTHWEST PROJECT NUMBER: STPG SIGN(51)				
VERMONT AGENCY OF TRANSPORTATION								SF	SF	EA	EA	EA	EA	EA	EA	EA	FT	EA	LB	LB	LB	LB	LB	FILE NAME: z13e624ts bristol WB PROJECT MANAGER: C. BEAN DESIGNED BY: S. GOODWIN BRISTOL VT-17 WESTBOUND 1				
<b>TOWN DIRECTIONAL TOTALS</b>								156.8	0.0	4	0	0	32	0	0	22	310.0	0		0.0				PLOT DATE: 4/28/2015 DRAWN BY: S. GOODWIN CHECKED: D. MUNRO SHEET 35 OF 121				