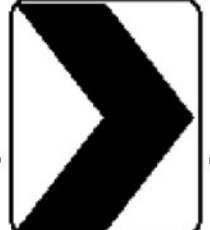
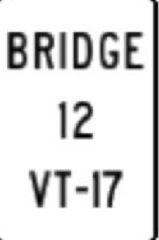

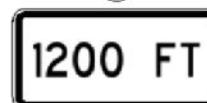

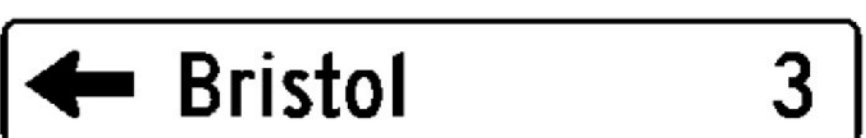


DIRECTION	MILEPOINT	LOCATION CODE (SHEET 3)	SIGN CODE	WIDTH (IN)	HEIGHT (IN)	SHEETING REMARKS	SIGN LEGEND	NEW SIGNS		EXISTING SIGNS				EXIST POST		NUMBER OF NEW POSTS	SQUARE STEEL (IN)			TUBULAR STEEL Ø (IN)				SIGN FRAME REQUIRED	REMARKS	SIGN DETAIL LOCATION				
								"A"	"B"	RETAIN	SALVAGE FROM	SALVAGE TO	REMOVE	RETAIN	REMOVE		(LB / FT)			(LB / FT)						SHSM	PROJECT SHEET #	STANDARD SHEET #		
																	1.75	2.00	2.50	3.00	3.50	4.00	5.00							
WB BRISTOL VT 17							FY-FLUORESCENT YELLOW FYG-FLUORESCENT YELLOW GREEN																"SHSM"-STANDARD HIGHWAY SIGNS AND MARKINGS BOOK							
WB	0.929	E	W1-8	18	24	FY		3.00							1		13.25							X						
WB	0.849	F	VD-701	6	8								1																	
		F	VD-701	6	10			0.42							1		9.00											T-44		
WB	0.829	F	W3-1	30	30			6.25							1		16.25							X				INSTALL 410 FT ± EAST OF EXISTING SIGN AT MP 0.751		
		F	W16-2aP	24	12			2.00																X						
WB	0.751	F	VD-062A	72	16		OFFICIAL BUSINESS DIRECTIONAL SIGN			1																		Robert Compton Pottery VT 116		
		F	VD-062B	72	16		OFFICIAL BUSINESS DIRECTIONAL SIGN			1																		Mary's at Baldwin Creek, Rest. & Inn		
WB	0.713	F	M2-1	21	15		JCT						1																	
		F	VM1-5	30	24		VERMONT 116						1																	
		F	M2-1	21	15			2.19																				JCT, GREEN ON WHITE		
		F	VM1-5	30	24			5.00																				E-136B		
WB	0.672	F	D1-1a	72	10		<--- BRISTOL 3						1																	
		F	D1-1a	72	10		STARKSBORO 5 ---->						1																	
		F	D1-1a	72	10		HINESBURG 14 ---->						1																	
		F	VD1-1A	72	12		 (CONT. ON NEXT SHEET)	6.00																						
SIGN SUMMARY SHEET							SHEET TOTALS	24.86 24.85	0.00	2	0	0	6	0	0	3	40.0 38.50	0	0.0	0.0	0.0	0.0	0.0	0.0	PROJECT NAME: STATEWIDE-SOUTHWEST PROJECT NUMBER: STPG SIGN(51)					
VERMONT AGENCY OF TRANSPORTATION								SF	SF	EA	EA	EA	EA	EA	EA	EA	EA	EA	EA	EA	EA	EA	EA	FILE NAME: z13e624ts s bristol WB PROJECT MANAGER: C. BEAN DESIGNED BY: S. GOODWIN BRISTOL VT-17 WESTBOUND 2					PLOT DATE: 4/28/2015 DRAWN BY: S. GOODWIN CHECKED: D. MUNRO SHEET 36 OF 121	
TOWN DIRECTIONAL TOTALS							156.8	0.0	4	0	0	32	0	0	22	310.0	0	0.0	0.0	0.0	0.0	0.0	0.0							