


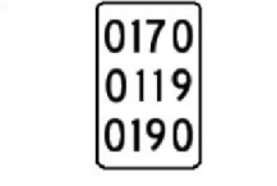






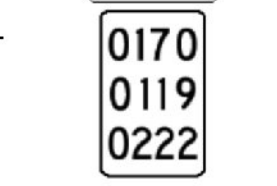
 


DIRECTION	MILEPOINT	LOCATION CODE (SHEET 3)	SIGN CODE	WIDTH (IN)	HEIGHT (IN)	SHEETING REMARKS	SIGN LEGEND	NEW SIGNS		EXISTING SIGNS				EXIST POST		NUMBER OF NEW POSTS	SQUARE STEEL (IN)			TUBULAR STEEL Ø (IN)				SIGN FRAME REQUIRED	REMARKS	SIGN DETAIL LOCATION			
								"A"	"B"	RETAIN	SALVAGE FROM	SALVAGE TO	REMOVE	RETAIN	REMOVE		1.75	2.00	2.50	FOUNDATION	3.00	3.50	4.00			5.00	SHSM	PROJECT SHEET #	STANDARD SHEET #
																	(LB / FT)				(LB / FT)								
EB STARKSBORO VT 17							FY-FLUORESCENT YELLOW FYG-FLUORESCENT YELLOW GREEN																"SHSM"-STANDARD HIGHWAY SIGNS AND MARKINGS BOOK						
		AB	D3-1	57	12		 (CONT.)	4.75							2	12.75	12.75	X									12		
EB	1.892	C	VR-017	24	30			5.00							1	12.75	X											E-141	
EB	1.899	D	R1-1	30	30								1		X														
		C	VD-700	6	8		 MILE MARKER 0170 / 0119 / 0190						1																
		D	R1-1	30	30			6.25							1	13.75	X							X					
		C	VD-700	6	10			0.42																				T-44	
EB	1.918	A	M3-2	24	12			2.00							1	15.75	X											E-136B	
		A	VM1-5	24	24			4.00																				E-136B	
EB	1.956	A	R2-1	24	30			5.00							1	15.75	X							X					
EB	2.228	AB	D-3	18	4		SAM STOKES RD						1		X														
		AB	D3-1	63	12			5.25							2	10.25	10.00	X									12		
EB	2.228	D	R1-1	30	30								1		X														
		C	VD-700	6	8		 MILE MARKER 0170 / 0119 / 0222						1																
		D	R1-1	30	30			6.25																	X				
		C	VD-700	6	10			0.42																				T-44	
SIGN SUMMARY SHEET							SHEET TOTALS		39.34	0.00	0	0	0	5	0	0	8	103.75		0	0.0	0.0	0.0	0.0	PROJECT NAME: STATEWIDE-SOUTHWEST PROJECT NUMBER: STPG SIGN(51)				
VERMONT AGENCY OF TRANSPORTATION							TOWN DIRECTIONAL TOTALS		178.6	0.0	5	3	3	41	0	0	44	610.0		0	0.0	0.0	0.0	0.0	FILE NAME: z13e624tssstarksboro EB PROJECT MANAGER: C. BEAN DESIGNED BY: S. GOODWIN STARKSBORO VT-17 EASTBOUND 4				
																								PLOT DATE: 4/28/2015 DRAWN BY: S. GOODWIN CHECKED: D. MUNRO SHEET 44 OF 121					