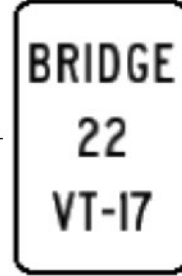
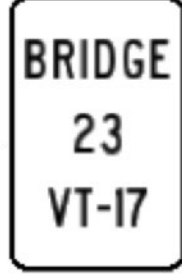

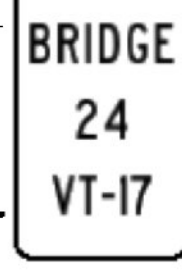
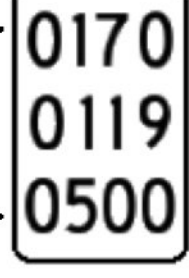
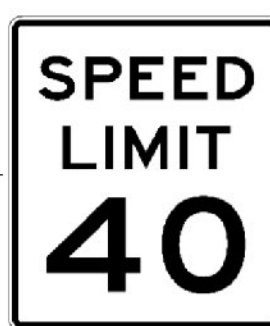




DIRECTION	MILEPOINT	LOCATION CODE (SHEET 3)	SIGN CODE	WIDTH (IN)	HEIGHT (IN)	SHEETING REMARKS	SIGN LEGEND	NEW SIGNS		EXISTING SIGNS				EXIST POST		NUMBER OF NEW POSTS	SQUARE STEEL (IN)			TUBULAR STEEL Ø (IN)				SIGN FRAME REQUIRED	REMARKS	SIGN DETAIL LOCATION		
								"A"	"B"	RETAIN	SALVAGE FROM	SALVAGE TO	REMOVE	RETAIN	REMOVE		1.75	2.00	2.50	3.00	3.50	4.00	5.00			SHSM	PROJECT SHEET #	STANDARD SHEET #
																	(LB / FT)			(LB / FT)								
EB STARKSBORO VT 17							FY-FLUORESCENT YELLOW FYG-FLUORESCENT YELLOW GREEN															"SHSM"-STANDARD HIGHWAY SIGNS AND MARKINGS BOOK						
EB	2.679	A	VD-701	6	8																							
		A	VD-701	6	10			0.42																		T-42		
EB	4.629	A	VD-701	6	8																							
		A	VD-701	6	10			0.42																		T-42		
EB	4.931	A	W3-5	36	36																							
		A	W3-5	36	36			9.00																	X			
EB	4.985	A	VD-701	6	8		BRIDGE 24 VT 17																					
		A	VD-700	6	8		MILE MARKER 0170 / 0119 / 0500																					
		A	VD-701	6	10			0.42																		T-42		
EB	5.000	A	VD-700	6	10			0.42																		T-44		
EB	5.075	A	R2-1	24	30																							
		A	R2-1	30	36			7.50																	X	NOTE: CERTIFICATE IS MP 5.130		
EB	5.130	A	VD1-1A	72	12			6.00																		10		
		A	VD1-1A	72	12			6.00																		10		
SIGN SUMMARY SHEET							SHEET TOTALS		30.18	0.00	0	0	0	6	0	0	9	103.00	0	0.0	0.0	0.0	0.0	0.0	PROJECT NAME: STATEWIDE-SOUTHWEST			
									SF	SF	EA	EA	EA	EA	EA	EA	EA	FT	EA	LB	LB	LB	LB	PROJECT NUMBER: STPG SIGN(51)				
VERMONT AGENCY OF TRANSPORTATION							TOWN DIRECTIONAL TOTALS		178.6	0.0	5	3	3	41	0	0	44	610.0	0		0.0			FILE NAME: z13e624tsstarksboro EB	PLOT DATE: 4/28/2015			
																							PROJECT MANAGER: C. BEAN	DRAWN BY: S. GOODWIN				
																							DESIGNED BY: S. GOODWIN	CHECKED: D. MUNRO				
																							STARKSBORO VT-17 EASTBOUND 6	SHEET 46	OF 121			