
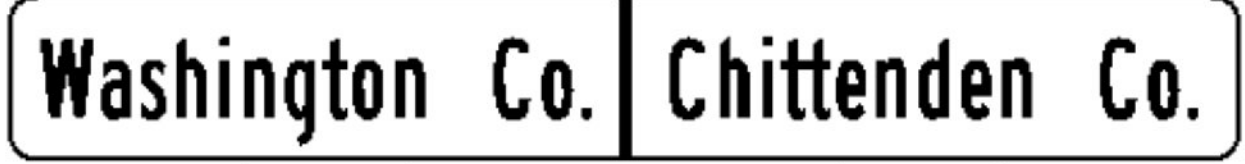
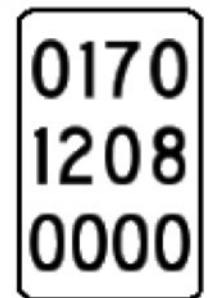
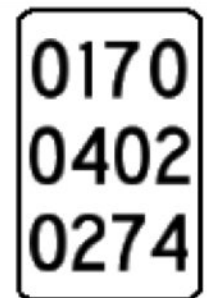





DIRECTION	MILEPOINT	LOCATION CODE (SHEET 3)	SIGN CODE	WIDTH (IN)	HEIGHT (IN)	SHEETING REMARKS	SIGN LEGEND	NEW SIGNS		EXISTING SIGNS				EXIST POST		NUMBER OF NEW POSTS	SQUARE STEEL (IN)			TUBULAR STEEL Ø (IN)				SIGN FRAME REQUIRED	REMARKS	SIGN DETAIL LOCATION		
								"A"	"B"	RETAIN	SALVAGE FROM	SALVAGE TO	REMOVE	RETAIN	REMOVE		(LB / FT)			(LB / FT)						SHSM	PROJECT SHEET #	STANDARD SHEET #
																	1.75	2.00	2.50	3.00	3.50	4.00	5.00					
EB FAYSTON VT 17							FY-FLUORESCENT YELLOW FYG-FLUORESCENT YELLOW GREEN																"SHSM"-STANDARD HIGHWAY SIGNS AND MARKINGS BOOK					
EB	0.000	C	VD-024	60	7.5		FAYSTON / BUELS GORE																					
		C	VD-025	60	7.5		WASHINGTON CO / CHITTENDEN CO																					
		C	VD-700	6	8		MILE MARKER 0170 / 1208 / 0000 (FAYSTON)																					
		C	VD-024	72	10			5.00																		11		
		C	VD-025	72	10			5.00																		11		
		C	VD-700	6	10			0.42																		T-44		
		C	VD-700	6	10			0.42																		T-44		
EB	0.019	A		12	24		Mad River BYWAY			1																		
EB	0.098	A	W1-6	48	24																							
EB	0.052	A	W1-6	48	24	FY		8.00																		X		
EB	0.052	B	W1-6	48	24	FY		8.00																		X		
EB	0.120	A	R2-1	24	30			5.00																		X		
EB	0.234	A	W1-5R	30	30		RIGHT WINDING CURVES																					
		A	W13-1P	18	18		20 M.P.H. (PLAQUE)																					
							(CONT. ON NEXT SHEET)																					
SIGN SUMMARY SHEET							SHEET TOTALS	31.84	0.00	1	0	0	6	0	0	7	405.0	95.25	0	0.0	0.0	0.0	0.0	0.0	PROJECT NAME: STATEWIDE-SOUTHWEST PROJECT NUMBER: STPG SIGN(51)			
VERMONT AGENCY OF TRANSPORTATION							TOWN DIRECTIONAL TOTALS	478.8	0.0	16	0	0	79	0	0	83	1205.0		0		0.0			FILE NAME: z13e624ts favston EB PROJECT MANAGER: C. BEAN DESIGNED BY: S. GOODWIN FAYSTON VT-17 EASTBOUND 1				
																							PLOT DATE: 4/28/2015 DRAWN BY: S. GOODWIN CHECKED: D. MUNRO SHEET 68 OF 121					