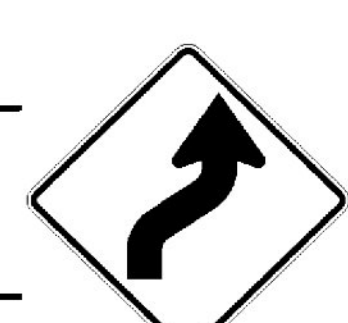
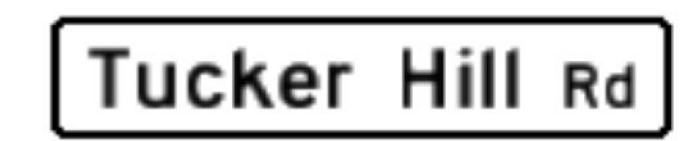
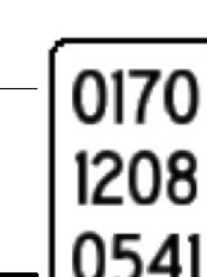


| DIRECTION | MILEPOINT | LOCATION CODE (SHEET 3) | SIGN CODE | WIDTH (IN) | HEIGHT (IN) | SHEETING REMARKS | SIGN LEGEND | NEW SIGNS | | EXISTING SIGNS | | | | EXIST POST | | NUMBER OF NEW POSTS | SQUARE STEEL (IN) | | | TUBULAR STEEL Ø (IN) | | | | SIGN FRAME REQUIRED | REMARKS | SIGN DETAIL LOCATION | | |
|----------------------------------|-----------|-------------------------|-----------|------------|-------------|---|---|-----------|------|----------------|--------------|------------|----------------|------------|--------|---------------------|-------------------|-------|------|----------------------|------|---|------|--|--|----------------------|-----------------|------------------|
| | | | | | | | | "A" | "B" | RETAIN | SALVAGE FROM | SALVAGE TO | REMOVE | RETAIN | REMOVE | | 1.75 | 2.00 | 2.50 | 3.00 | 3.50 | 4.00 | 5.00 | | | SHSM | PROJECT SHEET # | STANDARD SHEET # |
| | | | | | | | | | | | | | | | | | (LB / FT) | | | (LB / FT) | | | | | | | | |
| EB FAYSTON VT 17 | | | | | | | FY-FLUORESCENT YELLOW FYG-FLUORESCENT YELLOW GREEN | | | | | | | | | | | | | | | "SHSM"-STANDARD HIGHWAY SIGNS AND MARKINGS BOOK | | | | | | |
| EB | 4.974 | A | OM3-R | 42 | 36 | | SIGN & POST IS MISSING NO REMOVAL PAID IDR 05-17-2016 by CMMJ | | | | | | | | | | | | | | | | | | X | | | |
| EB | 4.987 | B | OM3-L | 12 | 36 | | LEFT OBJECT MARKER | | | | | | | | | | | | | | | | | | | | | |
| EB | 5.303 | A | W1-4R | 30 | 30 |  | | | | | | | | | | | | | | | | | | | | | | |
| EB | 5.361 | C | VR-017 | 24 | 30 | | LLL 24,000 LBS | | | 1 | | | | | | | | | | | | | | | | | | |
| EB | 5.361 | AB | | 24 | 6 | | TUCKER HILL RD | | | | | | | | | | | | | | | | | | | | | |
| | | C | | 24 | 6 | | MILL BROOK RD | | | | | | | | | | | | | | | | | | | | | |
| | | AB | D3-1 | 60 | 12 |  | | | | | | | | | | | | | | | | | | | | | 12 | |
| EB | 5.373 | D | R1-1 | 30 | 30 | | STOP | | | 1 | | | | | | | | | | | | | | | | | | |
| | | C | VD-700 | 6 | 8 |  | MILE MARKER 0170 / 1208 / 0541 | | | | | | | | | | | | | | | | | | | | | |
| | | C | VD-700 | 6 | 10 | | | | | | | | | | | | | | | | | | | | | | T-44 | |
| EB | 5.389 | A | W1-1L | 30 | 30 | | LEFT TURN | | | | | | | | | | | | | | | | | | | | | |
| | | A | W13-1P | 18 | 18 | | 30 M.P.H. (PLAQUE) | | | | | | | | | | | | | | | | | | | | | |
| EB | 5.475 | A | W3-5 | 36 | 36 | | REDUCE SPEED LIMIT 30 AHEAD | | | 1 | | | | | | | | | | | | | | | | | | |
| SIGN SUMMARY SHEET | | | | | | | SHEET TOTALS | 11.67 | 0.00 | 3 | 0 | 0 | 7 ⁶ | 0 | 0 | 3 | 45.0 | 35.00 | 0 | 0.0 | 0.0 | 0.0 | 0.0 | PROJECT NAME: STATEWIDE-SOUTHWEST PROJECT NUMBER: STPG SIGN(51) | | | | |
| VERMONT AGENCY OF TRANSPORTATION | | | | | | | TOWN DIRECTIONAL TOTALS | 478.8 | 0.0 | 16 | 0 | 0 | 79 | 0 | 0 | 83 | 1205.0 | | 0 | | 0.0 | | | FILE NAME: z13e624ts s favston EB PROJECT MANAGER: C. BEAN DESIGNED BY: S. GOODWIN FAYSTON VT-17 EASTBOUND 13 | PLOT DATE: 4/28/2015 DRAWN BY: S. GOODWIN CHECKED: D. MUNRO SHEET 80 OF 121 | | | |