
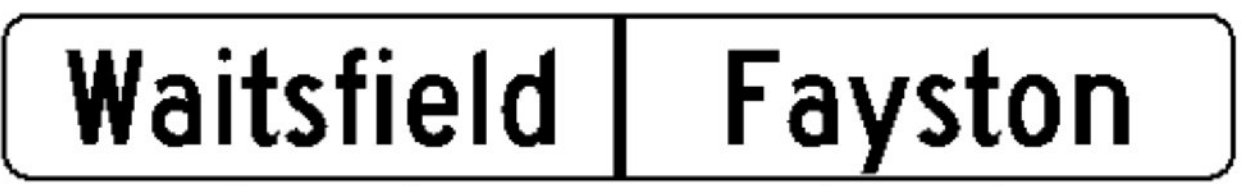
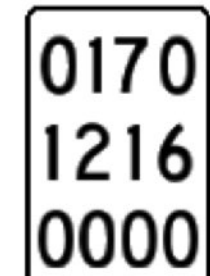


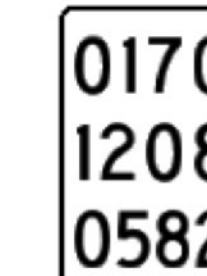


DIRECTION	MILEPOINT	LOCATION CODE (SHEET 3)	SIGN CODE	WIDTH (IN)	HEIGHT (IN)	SHEETING REMARKS	SIGN LEGEND	NEW SIGNS		EXISTING SIGNS				EXIST POST		NUMBER OF NEW POSTS	SQUARE STEEL (IN)			TUBULAR STEEL Ø (IN)				SIGN FRAME REQUIRED	REMARKS	SIGN DETAIL LOCATION			
								"A"	"B"	RETAIN	SALVAGE FROM	SALVAGE TO	REMOVE	RETAIN	REMOVE		(LB / FT)			(LB / FT)						SHSM	PROJECT SHEET #	STANDARD SHEET #	
																	1.75	2.00	2.50	3.00	3.50	4.00	5.00						
EB WAITSFIELD VT 17							FY-FLUORESCENT YELLOW FYG-FLUORESCENT YELLOW GREEN																"SHSM"-STANDARD HIGHWAY SIGNS AND MARKINGS BOOK						
EB	0.000	C	VD-024	60	7.5		WAITSFIELD/FAYSTON																						
		C	VD-700	6	8		MILE MARKER 0170 / 1208 / 0582 (FAYSTON)																						
		C	VD-700	6	8		MILE MARKER 0170 / 1216 / 0000 (WAITSFIELD)																						
		C	VD-024	72	10			5.00																			11		
		C	VD-700	6	10			0.42																					T-44
		C	VD-700	6	10			0.42																					T-44
EB	0.025	A	M2-1	21	15		JCT																						
		A	VM1-5	30	24		VERMONT 100																						
		A	M4-6	24	12		END																						
		A	VM1-5	24	24		VERMONT 17																						
		A	M2-1	21	15			2.19																					
		A	VM1-5	30	24			5.00																					
		A	M4-6	24	12			2.00																					
		A	VM1-5	24	24			4.00																					
SIGN SUMMARY SHEET							SHEET TOTALS	19.03	0.00	0	0	0	7	0	0	2	30.0	53.00	0	0.0	0.0	0.0	0.0	0.0	PROJECT NAME: STATEWIDE-SOUTHWEST PROJECT NUMBER: STPG SIGN(51)				
VERMONT AGENCY OF TRANSPORTATION							TOWN DIRECTIONAL TOTALS	131.6	0.0	1	4	4	30	0	0	17	250.0	0	0.0	0.0	0.0	0.0	0.0	FILE NAME: z13e624ts waitsfield EB PROJECT MANAGER: C. BEAN DESIGNED BY: S. GOODWIN WAITSFIELD VT-17 EASTBOUND 1					
																							PLOT DATE: 4/28/2015 DRAWN BY: S. GOODWIN CHECKED: D. MUNRO SHEET 93 OF 121						