



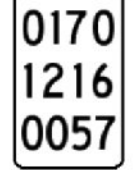





DIRECTION	MILEPOINT	LOCATION CODE (SHEET 3)	SIGN CODE	WIDTH (IN)	HEIGHT (IN)	SHEETING REMARKS	SIGN LEGEND	NEW SIGNS		EXISTING SIGNS				EXIST POST		NUMBER OF NEW POSTS	SQUARE STEEL (IN)			TUBULAR STEEL Ø (IN)				SIGN FRAME REQUIRED	REMARKS	SIGN DETAIL LOCATION		
								"A"	"B"	RETAIN	SALVAGE FROM	SALVAGE TO	REMOVE	RETAIN	REMOVE		1.75	2.00	2.50	FOUNDATION						SHSM	PROJECT SHEET #	STANDARD SHEET #
																	(LB / FT)			3.00	3.50	4.00	5.00					
<b>EB WAITSFIELD VT 17</b>							FY-FLUORESCENT YELLOW FYG-FLUORESCENT YELLOW GREEN																"SHSM"-STANDARD HIGHWAY SIGNS AND MARKINGS BOOK					
EB	0.045	B	W1-6	48	24										X	2	EB 0.045 Second installation 8.25 7.75											
		B	W1-6	48	24			8.00			1	1				2	8.75 9.25 X							X				
EB	0.045	C	VR-017	24	30			5.00								1	13.00 X										E-141	
EB	0.046	AB	D3-1	51	12			4.25			1	1				2	9.00 8.50 X	EB 0.046 Second installation 6.75 6.25								12		
EB	0.050	D	R1-1	30	30		STOP					1			X		12.25											
		D	R1-1	30	30			6.25								1	X							X				
		C	VD-700	6	10			0.42																		T-44		
EB	0.053	A	W1-6	48	24		LEFT ARROW BOARD			1					X													
EB	0.056	A	VD-701	6	8							1			X		7.50											
		A	VD-701	6	10			0.42								1	X									T-42		
EB	0.056	A	OM3-R	12	36							1			X		10.75							X				
		A	OM3-R	12	36			3.00								1	X											
EB	0.071	B	OM3-L	12	36							1			X		11.00											
		B	OM3-L	12	36			3.00								1	X							X				
<b>SIGN SUMMARY SHEET</b>							SHEET TOTALS		30.34	0.00	1	0	0 <sup>2</sup>	5 <sup>7</sup>	0	0	9 <sup>13</sup>	130.0	119.00	0	0.0	0.0	0.0	0.0	PROJECT NAME: STATEWIDE-SOUTHWEST PROJECT NUMBER: STPG SIGN(51)			
VERMONT AGENCY OF TRANSPORTATION							SF	SF	EA	EA	EA	EA	EA	EA	EA	EA	EA	EA	EA	EA	EA	EA	EA	EA	FILE NAME: z13e624ts waitsfield EB PROJECT MANAGER: C. BEAN DESIGNED BY: S. GOODWIN WAITSFIELD VT-17 EASTBOUND 2			
TOWN DIRECTIONAL TOTALS							131.6	0.0	1	4	4	30	0	0	17	250.0	0	0.0	0.0	0.0	0.0	0.0	PLOT DATE: 4/28/2015 DRAWN BY: S. GOODWIN CHECKED: D. MUNRO SHEET 94 OF 121					