

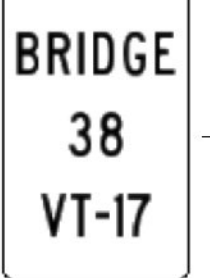






DIRECTION	MILEPOINT	LOCATION CODE (SHEET 3)	SIGN CODE	WIDTH (IN)	HEIGHT (IN)	SHEETING REMARKS	SIGN LEGEND	NEW SIGNS		EXISTING SIGNS				EXIST POST		NUMBER OF NEW POSTS	SQUARE STEEL (IN)			TUBULAR STEEL Ø (IN)				SIGN FRAME REQUIRED	REMARKS	SIGN DETAIL LOCATION			
								"A"	"B"	RETAIN	SALVAGE FROM	SALVAGE TO	REMOVE	RETAIN	REMOVE		1.75	2.00	2.50	FOUNDATION						SHSM	PROJECT SHEET #	STANDARD SHEET #	
																	(LB / FT)			3.00	3.50	4.00	5.00						(LB / FT)
WB WAITSFIELD VT 17							FY-FLUORESCENT YELLOW FYG-FLUORESCENT YELLOW GREEN																"SHSM"-STANDARD HIGHWAY SIGNS AND MARKINGS BOOK						
WB	0.072	F	W1-10R	36	36			9.00							2		14.75	14.75	X								7		
		F	W13-1P	18	18			2.25																X					
WB	0.070	F	VD-701	6	8							1					8.25												
		F	VD-701	6	10			0.42							1		X											T-42	
WB	0.070	F	OM3-R	12	36							1																	
		F	OM3-R	12	36			3.00							1		10.75		X					X					
WB	0.055	E	OM3-L	12	36							1																	
		E	OM3-L	12	36			3.00							1		10.50		X					X					
WB	0.031	F	D2-1	72	12		MT ELLEN SKI AREA 4					1																	
		F	D2-1	72	12		MAD RIVER GLEN SKI AREA 5					1																	
		F	VD2-1	72	12			6.00																			8		
		F	VD2-1	72	12			6.00																			8		
SIGN SUMMARY SHEET							SHEET TOTALS	29.67	0.00	0	0	0	5	0	0	5		70.0	59.00		0	0.0	0.0	0.0	0.0	0.0	PROJECT NAME: STATEWIDE-SOUTHWEST PROJECT NUMBER: STPG SIGN(51)		
VERMONT AGENCY OF TRANSPORTATION							TOWN DIRECTIONAL TOTALS	49.7	0.0	1	1	1	14	0	0	9		130.0			0		0.0				FILE NAME: z13e624ts waits field WB PROJECT MANAGER: C. BEAN DESIGNED BY: S. GOODWIN WAITSFIELD VT-17 WESTBOUND 2		
																										PLOT DATE: 4/28/2015 DRAWN BY: S. GOODWIN CHECKED: D. MUNRO SHEET 99 OF 121			