

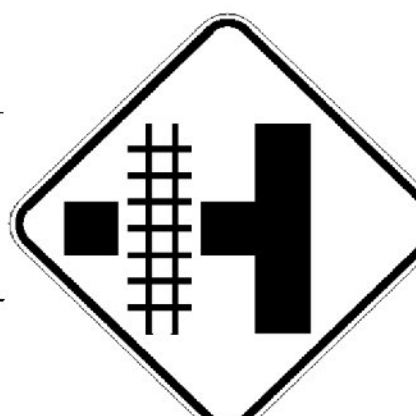


DIRECTION	MILEPOINT	LOCATION CODE (SHEET 3)	SIGN CODE	WIDTH (IN)	HEIGHT (IN)	SHEETING REMARKS	SIGN LEGEND	NEW SIGNS		EXISTING SIGNS				EXIST POST		NUMBER OF NEW POSTS	SQUARE STEEL (IN)			TUBULAR STEEL Ø (IN)				SIGN FRAME REQUIRED	REMARKS	SIGN DETAIL LOCATION		
								"A"	"B"	RETAIN	SALVAGE FROM	SALVAGE TO	REMOVE	RETAIN	REMOVE		1.75	2.00	2.50	3.00	3.50	4.00	5.00			SHSM	PROJECT SHEET #	STANDARD SHEET #
																	(LB / FT)			(LB / FT)								
WB WEST RUTLAND BUS 4							FY-FLUORESCENT YELLOW FYG-FLUORESCENT YELLOW GREEN																"SHSM"-STANDARD HIGHWAY SIGNS AND MARKINGS BOOK					
WB	1.396	F	M3-4	24	12		Colin Judge (04-13-2016) WB 1.396 - Sign and post to be retained, removed by active construction				1																	
		F	M4-3	24	12						1																	
		F	M1-4	24	24						1																	
		F		18	24		CROSSROAD OF VERMONT BY-WAY				1																	
WB	1.313	F	R2-1	24	30																							
		F	R2-1	30	36			7.50																			X	
WB	1.088	F	R2-1	24	30																							
		F	R2-1	30	36			7.50																			X	
WB	0.912	F	W10-3	30	30																							
		F	W10-3L	36	36			9.00																			X	
		F	W16-8p	48	8		Old Boardman Hill Rd	2.67																			7	
WB	0.759	F	VD-062B	72	16		OFFICIAL BUSINESS DIRECTIONAL SIGN				1																Historic Bus. Dist right on marble st.	
		F	VD-062B	72	16		OFFICIAL BUSINESS DIRECTIONAL SIGN				1																West Rutland Industrial Park	
WB	0.667	F	W10-1	36	36		RAILROAD CROSSING				1																	
SIGN SUMMARY SHEET							SHEET TOTALS	26.67	0.00	7	0	0	3	0	0	4	60.0	61.50	0	0.0	0.0	0.0	0.0	0.0	PROJECT NAME: STATEWIDE-SOUTHWEST			
								SF	SF	EA	EA	EA	EA	EA	EA	EA	FT		EA	LB	LB	LB	LB	PROJECT NUMBER: STPG SIGN(51)				
VERMONT AGENCY OF TRANSPORTATION							TOWN DIRECTIONAL TOTALS	32.9	0.0	7	0	0	3	0	0	5	75.0		0		0.0			FILE NAME: z13e624tss westrutland WB	PLOT DATE: 4/28/2015			
																							PROJECT MANAGER: C. BEAN	DRAWN BY: S. GOODWIN				
																							DESIGNED BY: S. GOODWIN	CHECKED: D. MUNRO				
																							WEST RUTLAND BUS-4 WESTBOUND 1	SHEET 102 OF 121				