


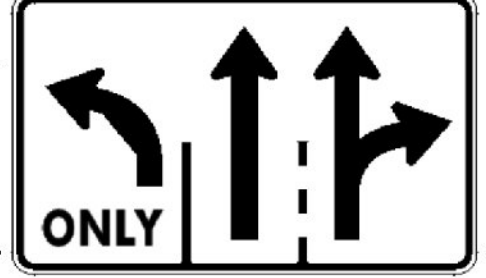

DIRECTION	MILEPOINT	LOCATION CODE (SHEET 3)	SIGN CODE	WIDTH (IN)	HEIGHT (IN)	SHEETING REMARKS	SIGN LEGEND	NEW SIGNS		EXISTING SIGNS				EXIST POST		NUMBER OF NEW POSTS	SQUARE STEEL (IN)			TUBULAR STEEL Ø (IN)				SIGN FRAME REQUIRED	REMARKS	SIGN DETAIL LOCATION		
								"A"	"B"	RETAIN	SALVAGE FROM	SALVAGE TO	REMOVE	RETAIN	REMOVE		1.75	2.00	2.50	3.00	3.50	4.00	5.00			SHSM	PROJECT SHEET #	STANDARD SHEET #
																	(LB / FT)			(LB / FT)								
EB RUTLAND TOWN BUS 4							FY-FLUORESCENT YELLOW FYG-FLUORESCENT YELLOW GREEN															"SHSM"-STANDARD HIGHWAY SIGNS AND MARKINGS BOOK						
		A	M3-2	24	12		(CONT.)	2.00															EAST, BLACK ON WHITE	X				
		A	M4-3	24	12			2.00															BUSINESS, BLACK ON WHITE	X				
		A	M1-4	24	24			4.00																X				
		A	M6-3	21	15			2.19															UP ARROW, BLACK ON WHITE	X				
EB	0.597	M	VD-686				RTE 3 NORTH PROCTOR LEFT LANE (OVERHEAD)						1										REMOVE EXISTING OVERHEAD SIGN ASSEMBLY, CANTILEVER					
		M	VE6-2C				BUSINESS US4 EAST ^UP (OVERHEAD)						1										Assembly removed on May 3, 2016 Paid 0.5 EA - until foundations are removed. per RE					
EB	0.611	A	VR-934L	48	30		LEFT "ONLY" / THRU / THRU & RIGHT						1															
		A	VD-701	6	8		BRIDGE 4 RT 4						1															
		A		6	8		4						1															
		A	VR-934	48	30			10.00							2	15.00 15.50 X										E-145B		
EB	0.612	A	VD-701	6	10			0.42							1	8.50 X											T-42	
EB	0.641	A	VD-066	72	48		CAR POOL INFO 1-800-685-RIDE			1																		
EB	0.660	AB	D-3	6	18		OLD FALLS RD						1															
		AB	D3-1	51	12			4.25							2	11.50 10.75 X							INSTALL INDEPENDENTLY ON TWO POSTS ON THE LEGAL LOAD SIDE OF THE INTERSECTION		12			
SIGN SUMMARY SHEET							SHEET TOTALS	24.86	0.00	1	0	0	6	0	0	5	70.0	61.25	0	0.0	0.0	0.0	0.0	PROJECT NAME: STATEWIDE-SOUTHWEST PROJECT NUMBER: STPG SIGN(51)				
VERMONT AGENCY OF TRANSPORTATION							TOWN DIRECTIONAL TOTALS	230.1	0.0	11	2	2	54	0	0	28	405.0		0		0.0			FILE NAME: z13e624ts rutlandtown EB PROJECT MANAGER: C. BEAN DESIGNED BY: S. GOODWIN RUTLAND TOWN BUS-4 EASTBOUND 4				
																							PLOT DATE: 4/28/2015 DRAWN BY: S. GOODWIN CHECKED: D. MUNRO SHEET 107 OF 121					