


# STATE OF VERMONT AGENCY OF TRANSPORTATION

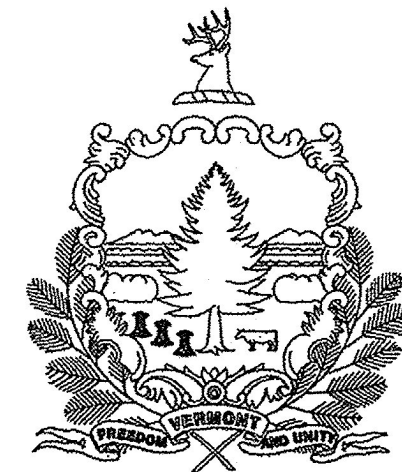

## PROPOSED IMPROVEMENT BRIDGE PROJECT


TOWN OF STRAFFORD  
COUNTY OF ORANGE

ROUTE NO : FAS 0177 (TH 1), RURAL MAJOR COLLECTOR, CLASS 2 TOWN HIGHWAY BRIDGE NO : 29


PROJECT LOCATION: APPROXIMATELY 0.04 MILES NORTH OF THE INTERSECTION OF TOWN HIGHWAY 1 (FAS 0177) AND TOWN HIGHWAY 4.

PROJECT DESCRIPTION: REMOVAL OF THE EXISTING STRUCTURE AND REPLACEMENT WITH A NEW STRUCTURE.

LENGTH OF STRUCTURE: 60.56 FEET  
LENGTH OF ROADWAY: 239.44 FEET  
LENGTH OF PROJECT: 300.00 FEET

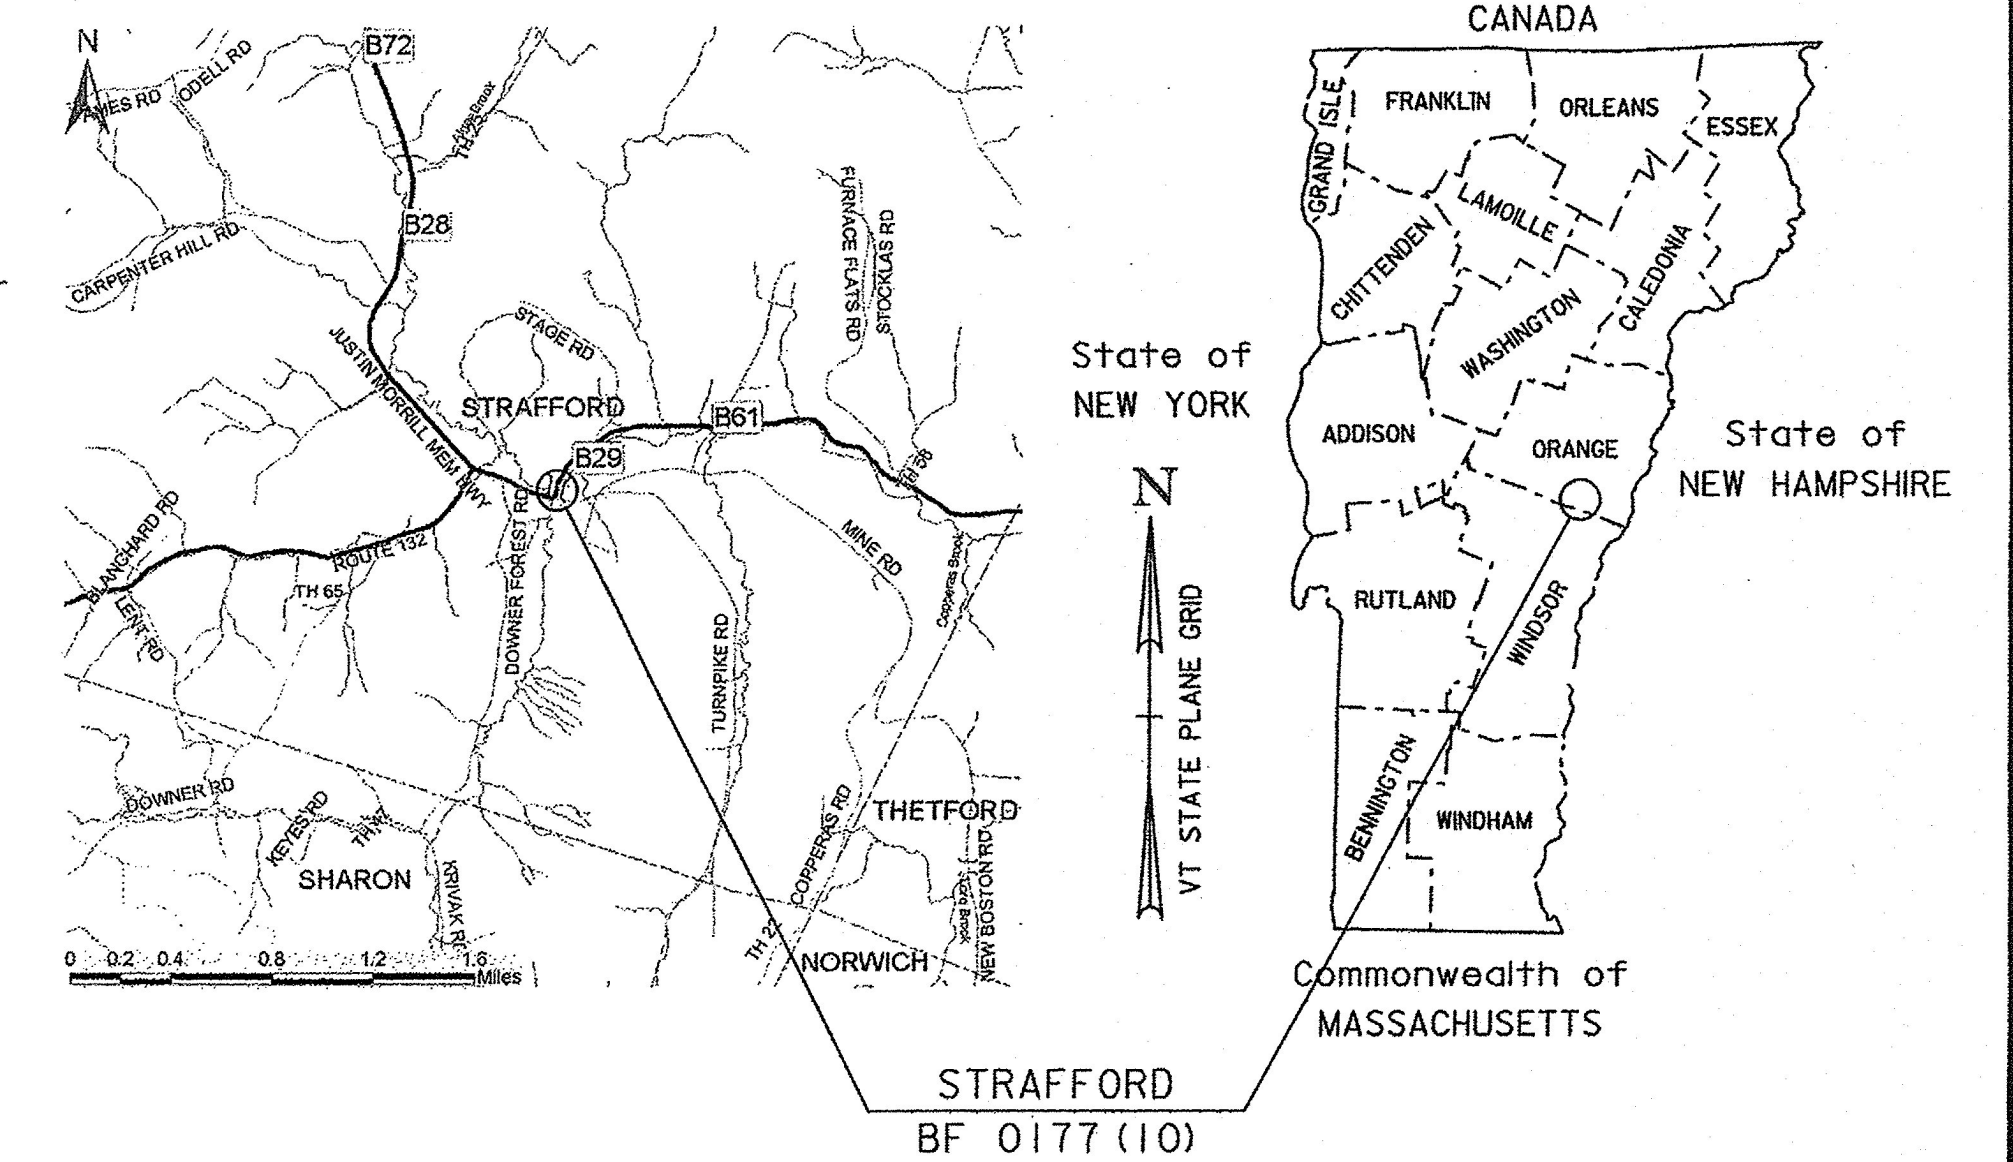

RECORD PLANS	
CONTRACTOR:	MILLER CONSTRUCTION, INC - WINDSOR, VT
RESIDENT ENGINEER:	TOM CHASE
CONSTRUCTION BEGAN:	JULY 10, 2017
CONSTRUCTION COMPLETE:	SEPTEMBER 22, 2017
RECORD PLANS BY:	TOM CHASE & AARON WEAVER
I HEREBY CERTIFY THAT ALL THE CONSTRUCTION REQUIRED BY THIS SET OF DRAWINGS HAS BEEN ACCOMPLISHED AS INDICATED HEREIN.	
BY	<i>Thomas A. Chase</i> RESIDENT ENGINEER
DATE	04/10/18
NOTE: Any further information concerning final quantities, amounts or other details relative to this project may be found at Central Files in the electronic archives.	

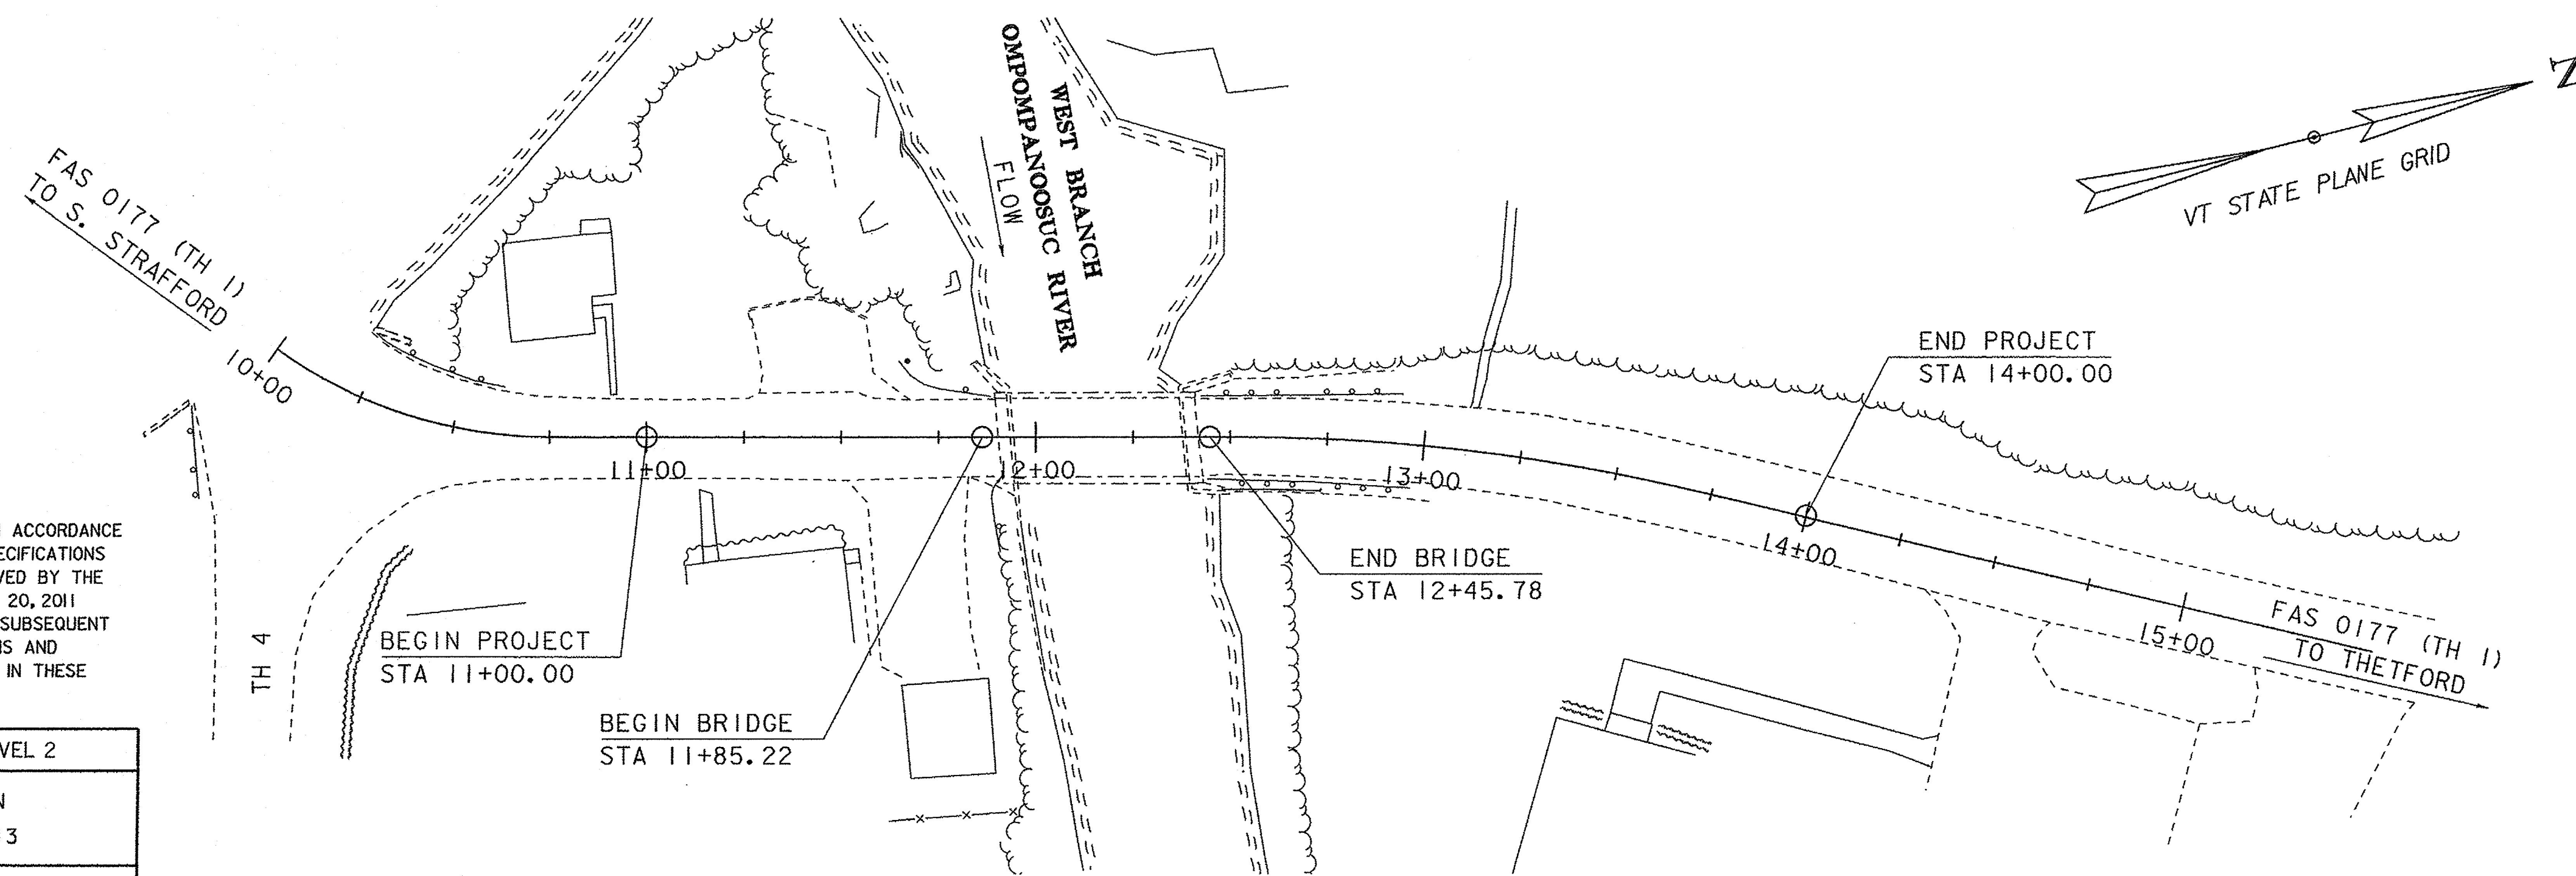

CONSTRUCTION IS TO BE CARRIED ON IN ACCORDANCE WITH THESE PLANS AND THE STANDARD SPECIFICATIONS FOR CONSTRUCTION DATED 2011, AS APPROVED BY THE FEDERAL HIGHWAY ADMINISTRATION ON JULY 20, 2011 FOR USE ON THIS PROJECT, INCLUDING ALL SUBSEQUENT REVISIONS AND SUCH REVISED SPECIFICATIONS AND SPECIAL PROVISIONS AS ARE INCORPORATED IN THESE PLANS.

QUALITY ASSURANCE PROGRAM : LEVEL 2	
SURVEYED BY :	R. GILMAN
SURVEYED DATE :	04/18/2013
DATUM	
VERTICAL	NAVD88
HORIZONTAL	NAD 83 (2011)

DIRECTOR OF PROJECT DELIVERY	
APPROVED <i>J.P.R.</i>	DATE 9/1/2018
PROJECT MANAGER : KRISTIN HIGGINS, P.E.	
PROJECT NAME : STRAFFORD	
PROJECT NUMBER : BF 0177 (10)	
SHEET 1 OF 52 SHEETS	